


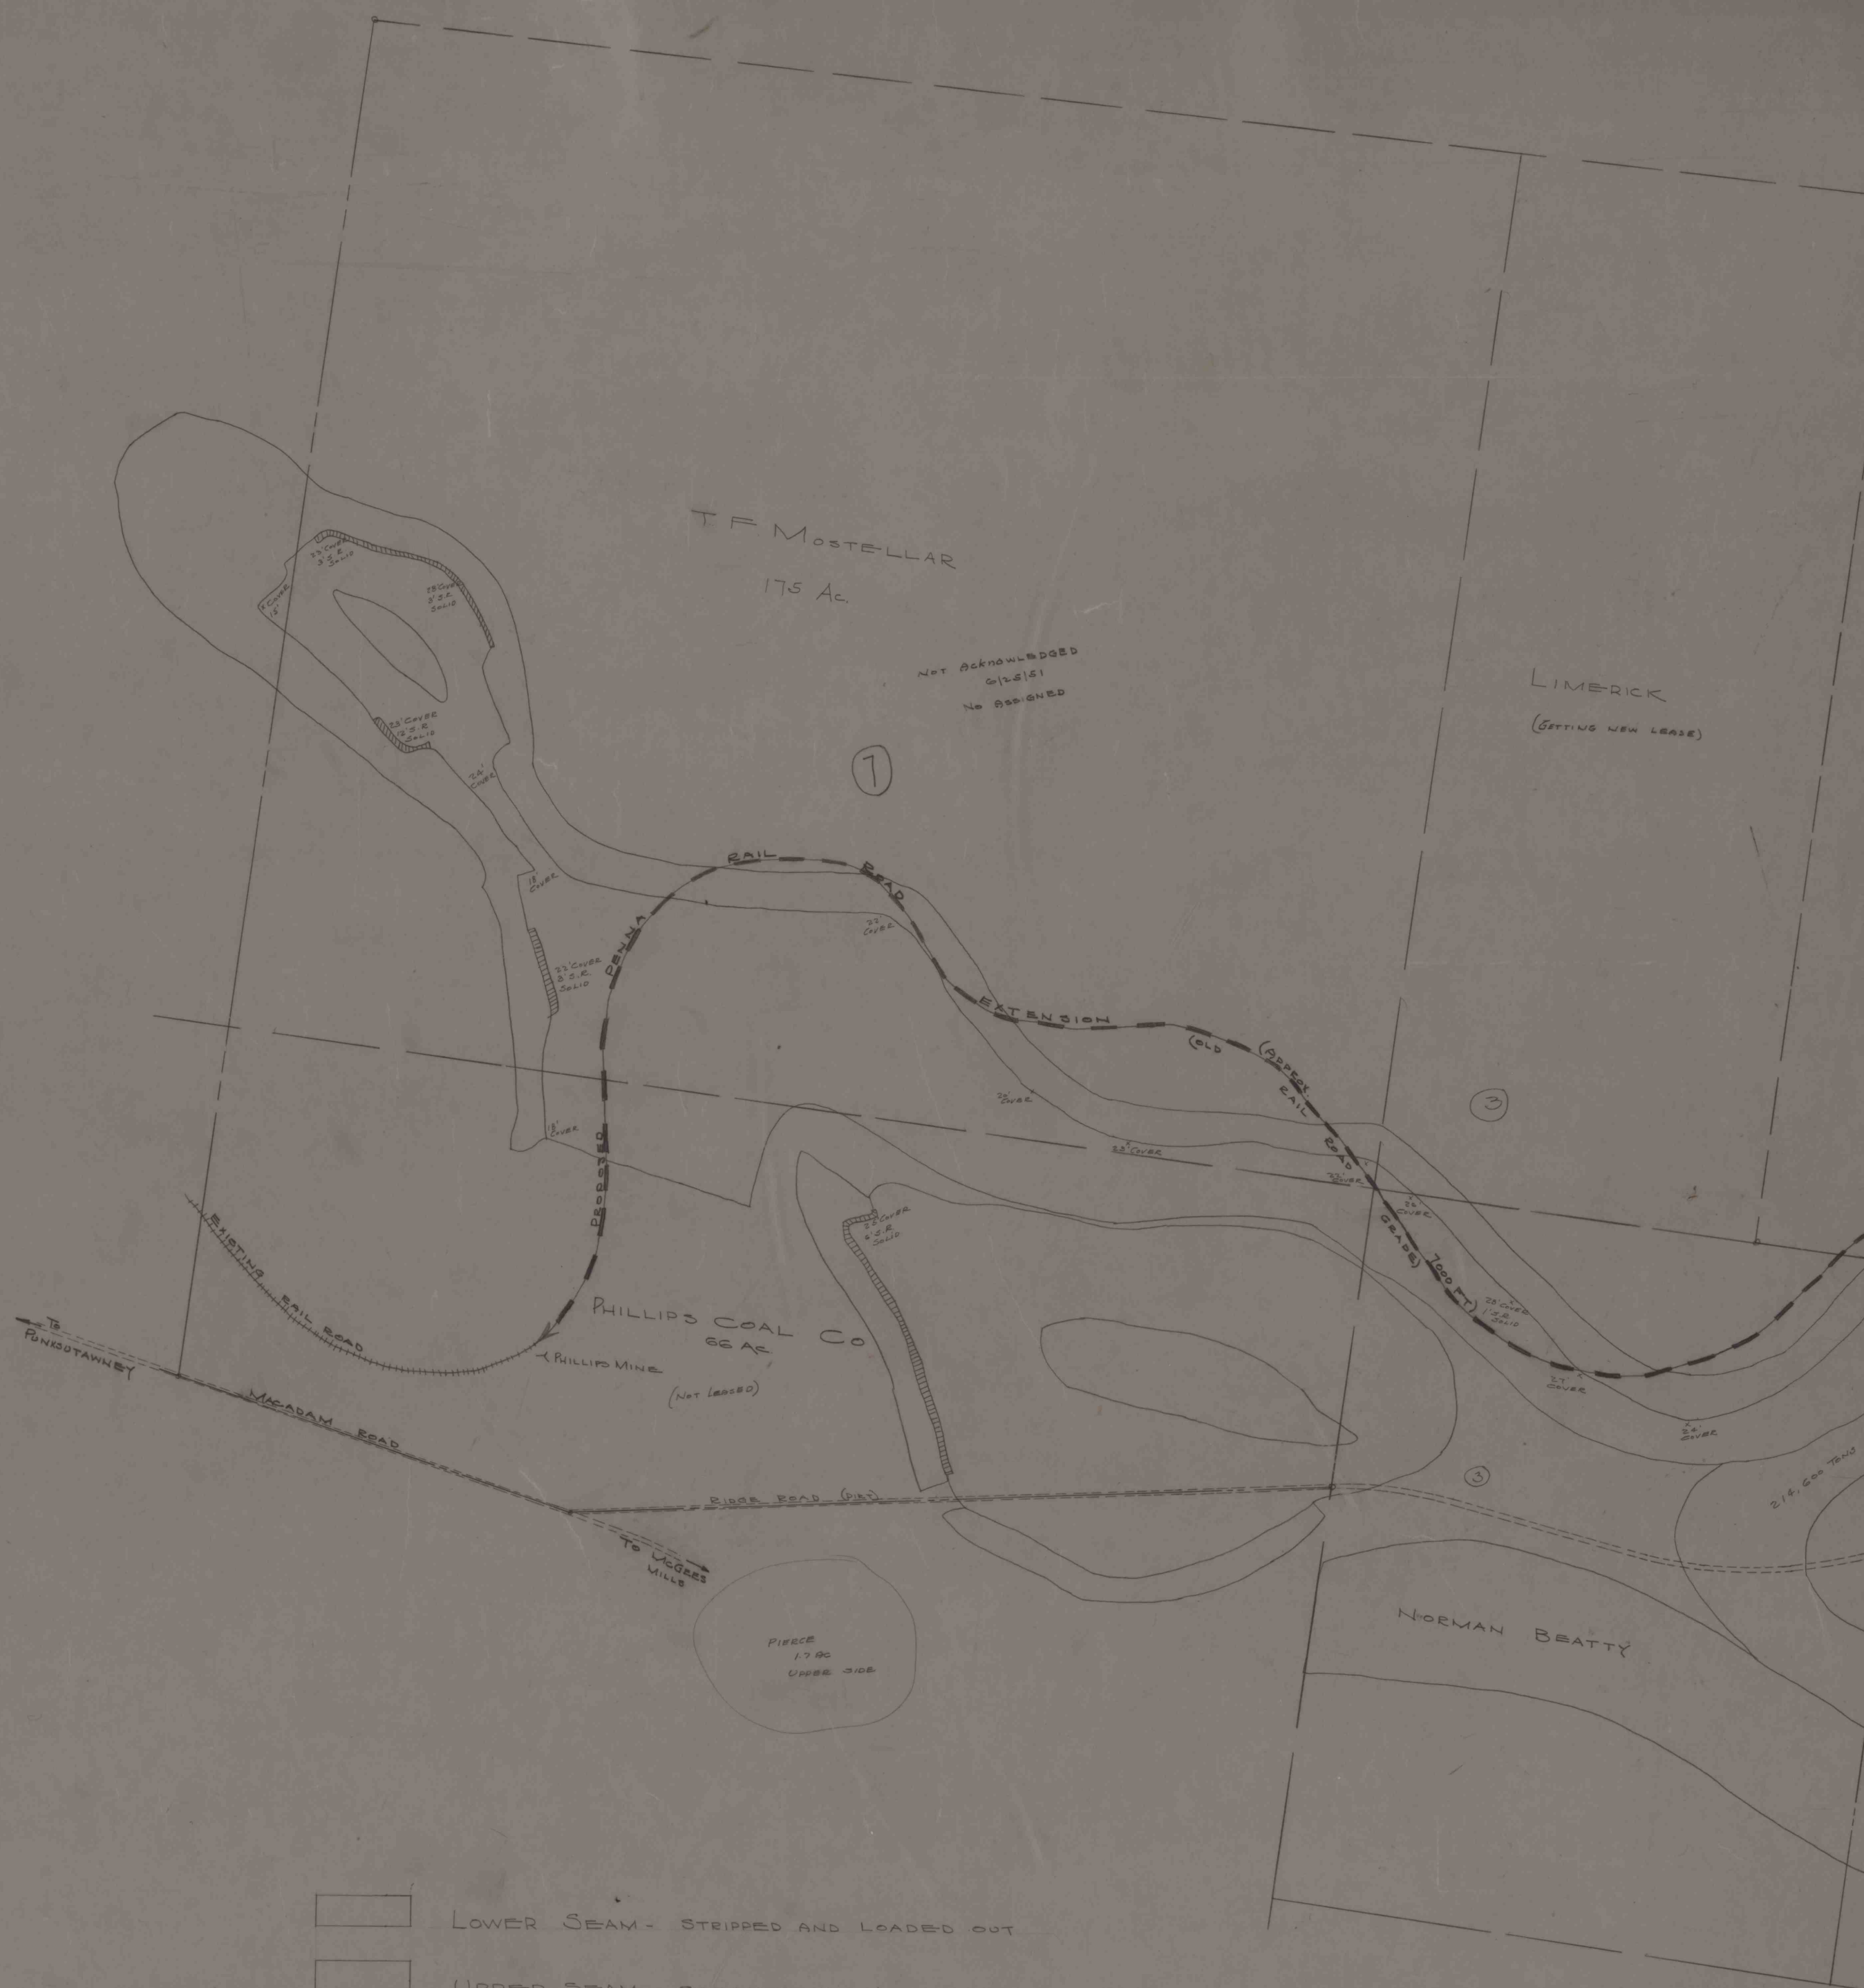

CLOVER RUN COAL CO. INC.

COAL LANDS IN

BELL TOWNSHIP CLEARFIELD CO. AND GASKILL TOWNSHIP, JEFFERSON CO., PENNA.

Scale 1 in. = 200 ft.

August 15, 1947
Clearfield, Penna.

Engineering Offices
Yost, Bromfield & Hess