


WISHAW AREA

WISHAW AREA

17400 12456-82

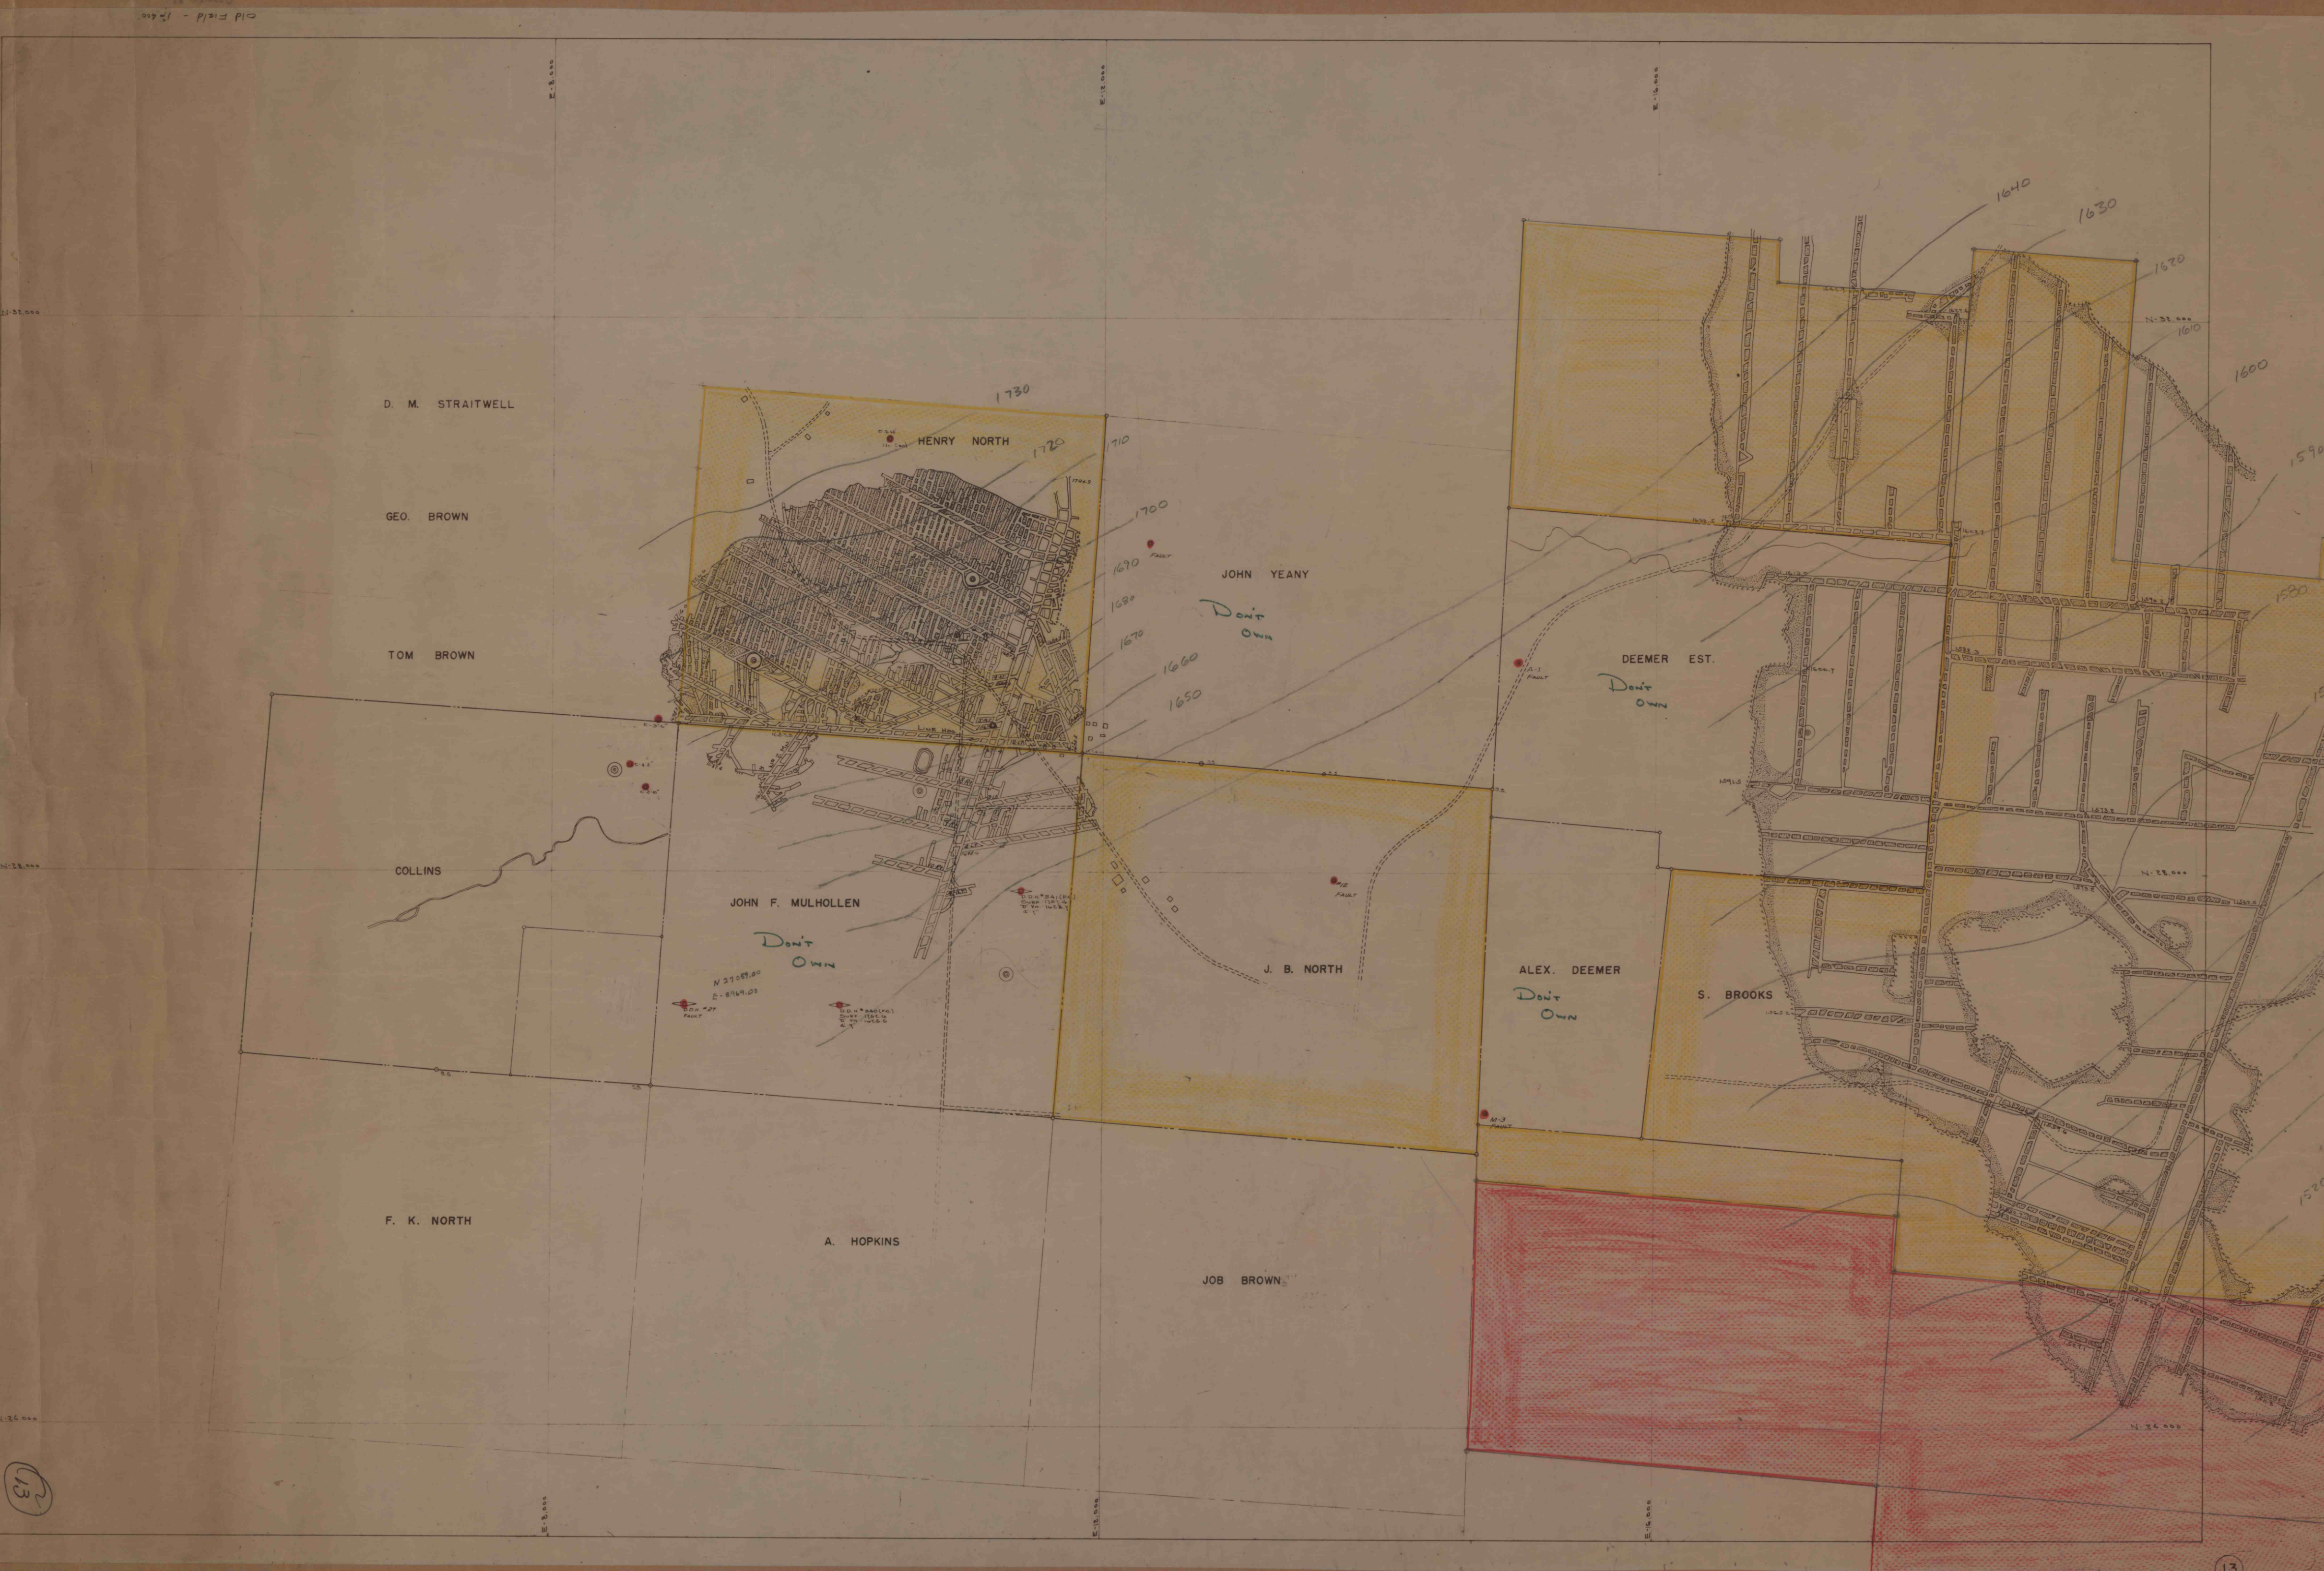

12456-82

WISHAW AREA