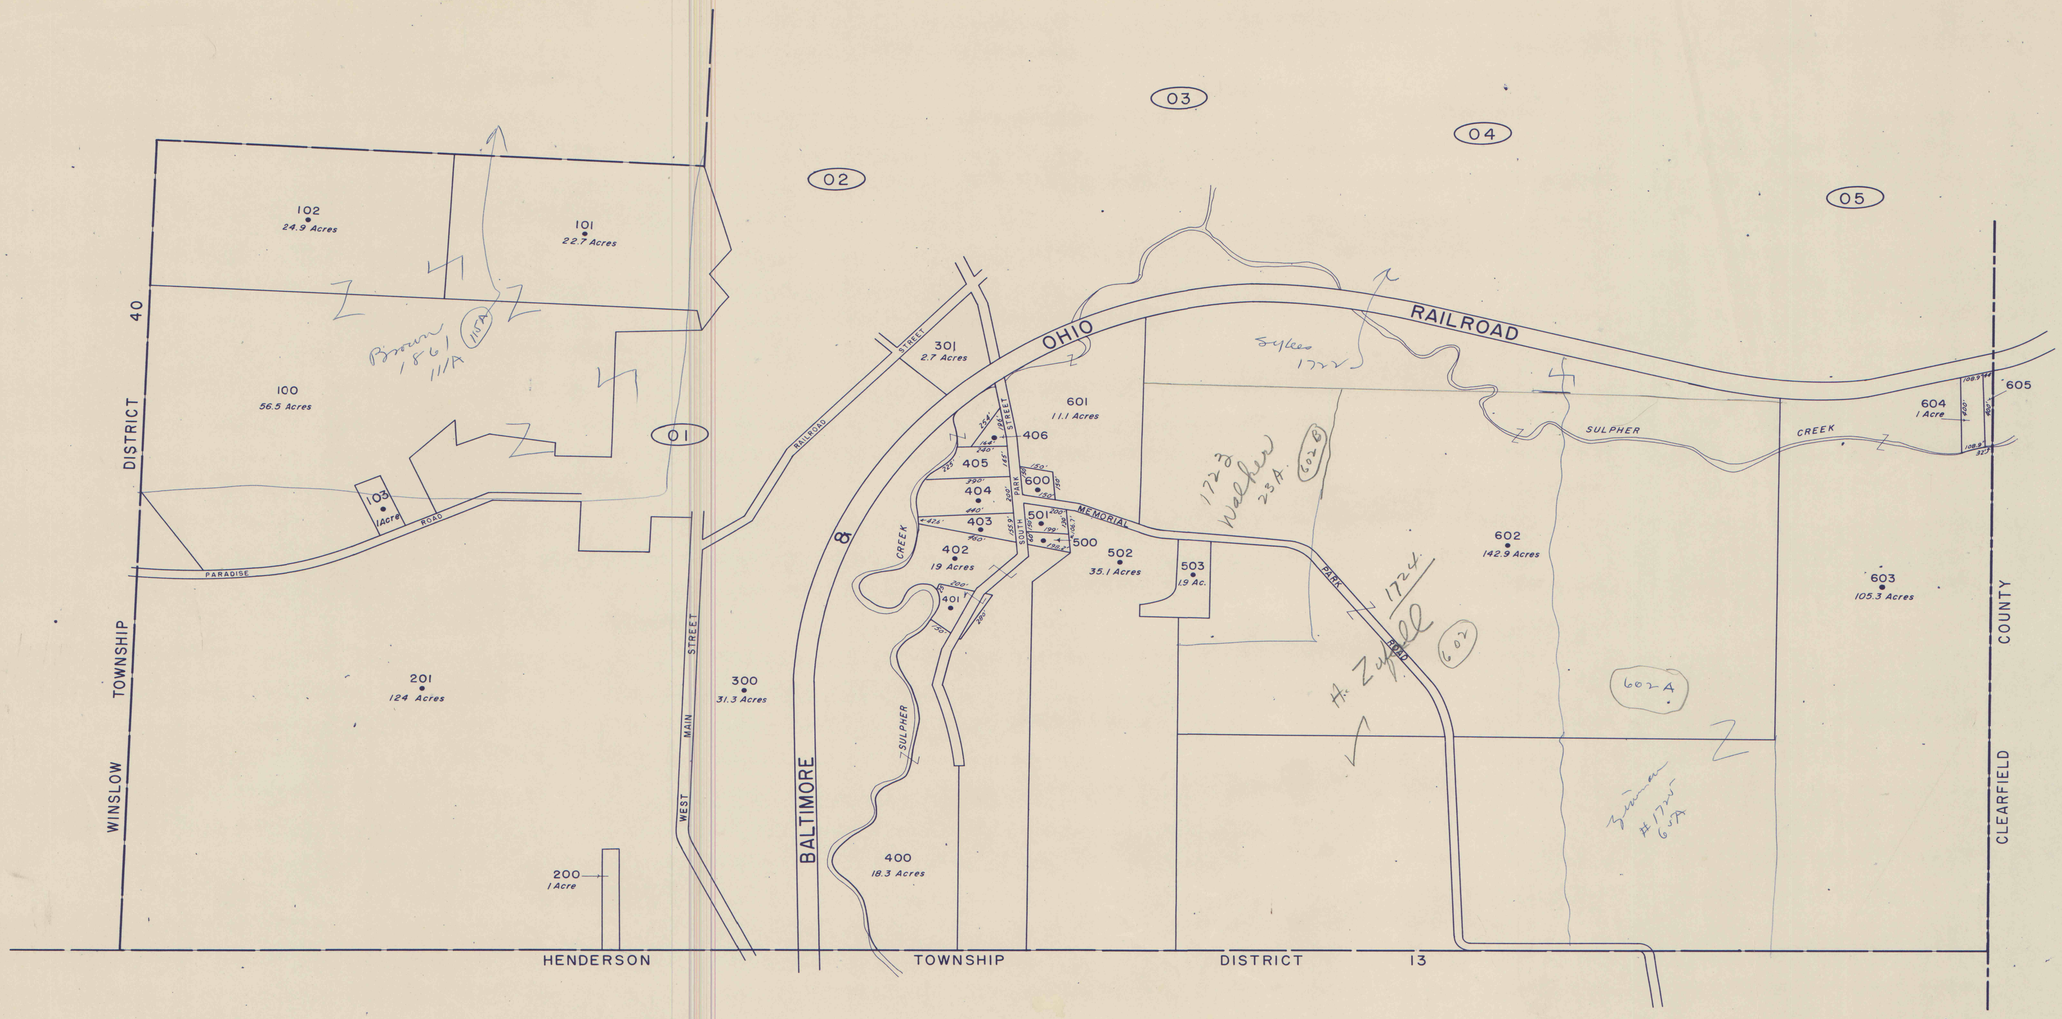

10556-85

DATE	REVISIONS	BY

300 0 300 600
SCALE IN FEET

MICHAEL BAKER, JR., INC.
Consulting Engineers
ROCHESTER, PENNSYLVANIA

KEY MAP
06

JEFFERSON COUNTY
Pennsylvania
1957

BOROUGH OF SYKESVILLE

DISTRICT NO. 35
SHEET NO. 06