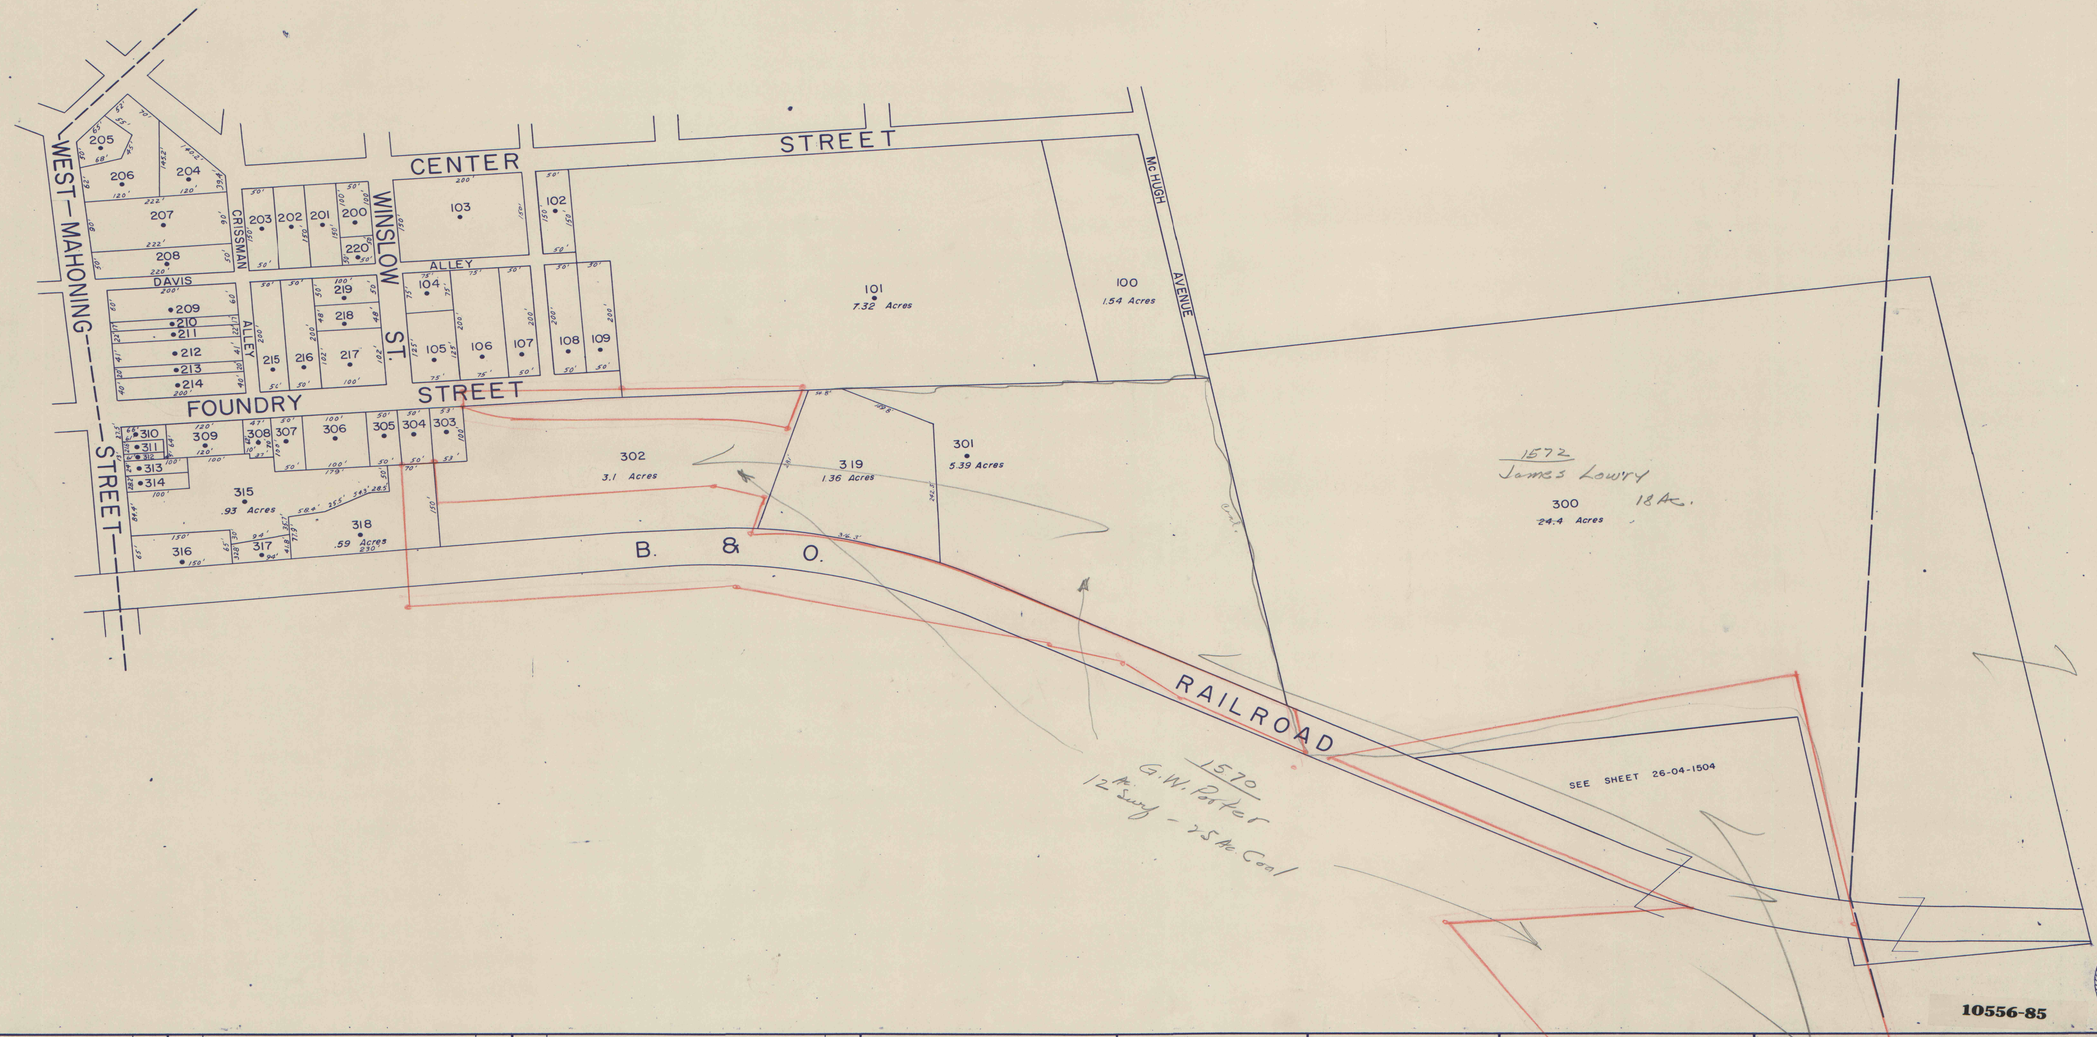

10556-85

DATE	REVISIONS	BY

100 0 100 200
SCALE IN FEET

MICHAEL BAKER, JR., INC.
Consulting Engineers
ROCHESTER, PENNSYLVANIA

KEY MAP
02 | 01
03
04

JEFFERSON COUNTY
Pennsylvania
1957

BOROUGH OF
PUNXSUTAWNEY

DISTRICT NO. 26
SHEET NO. 03