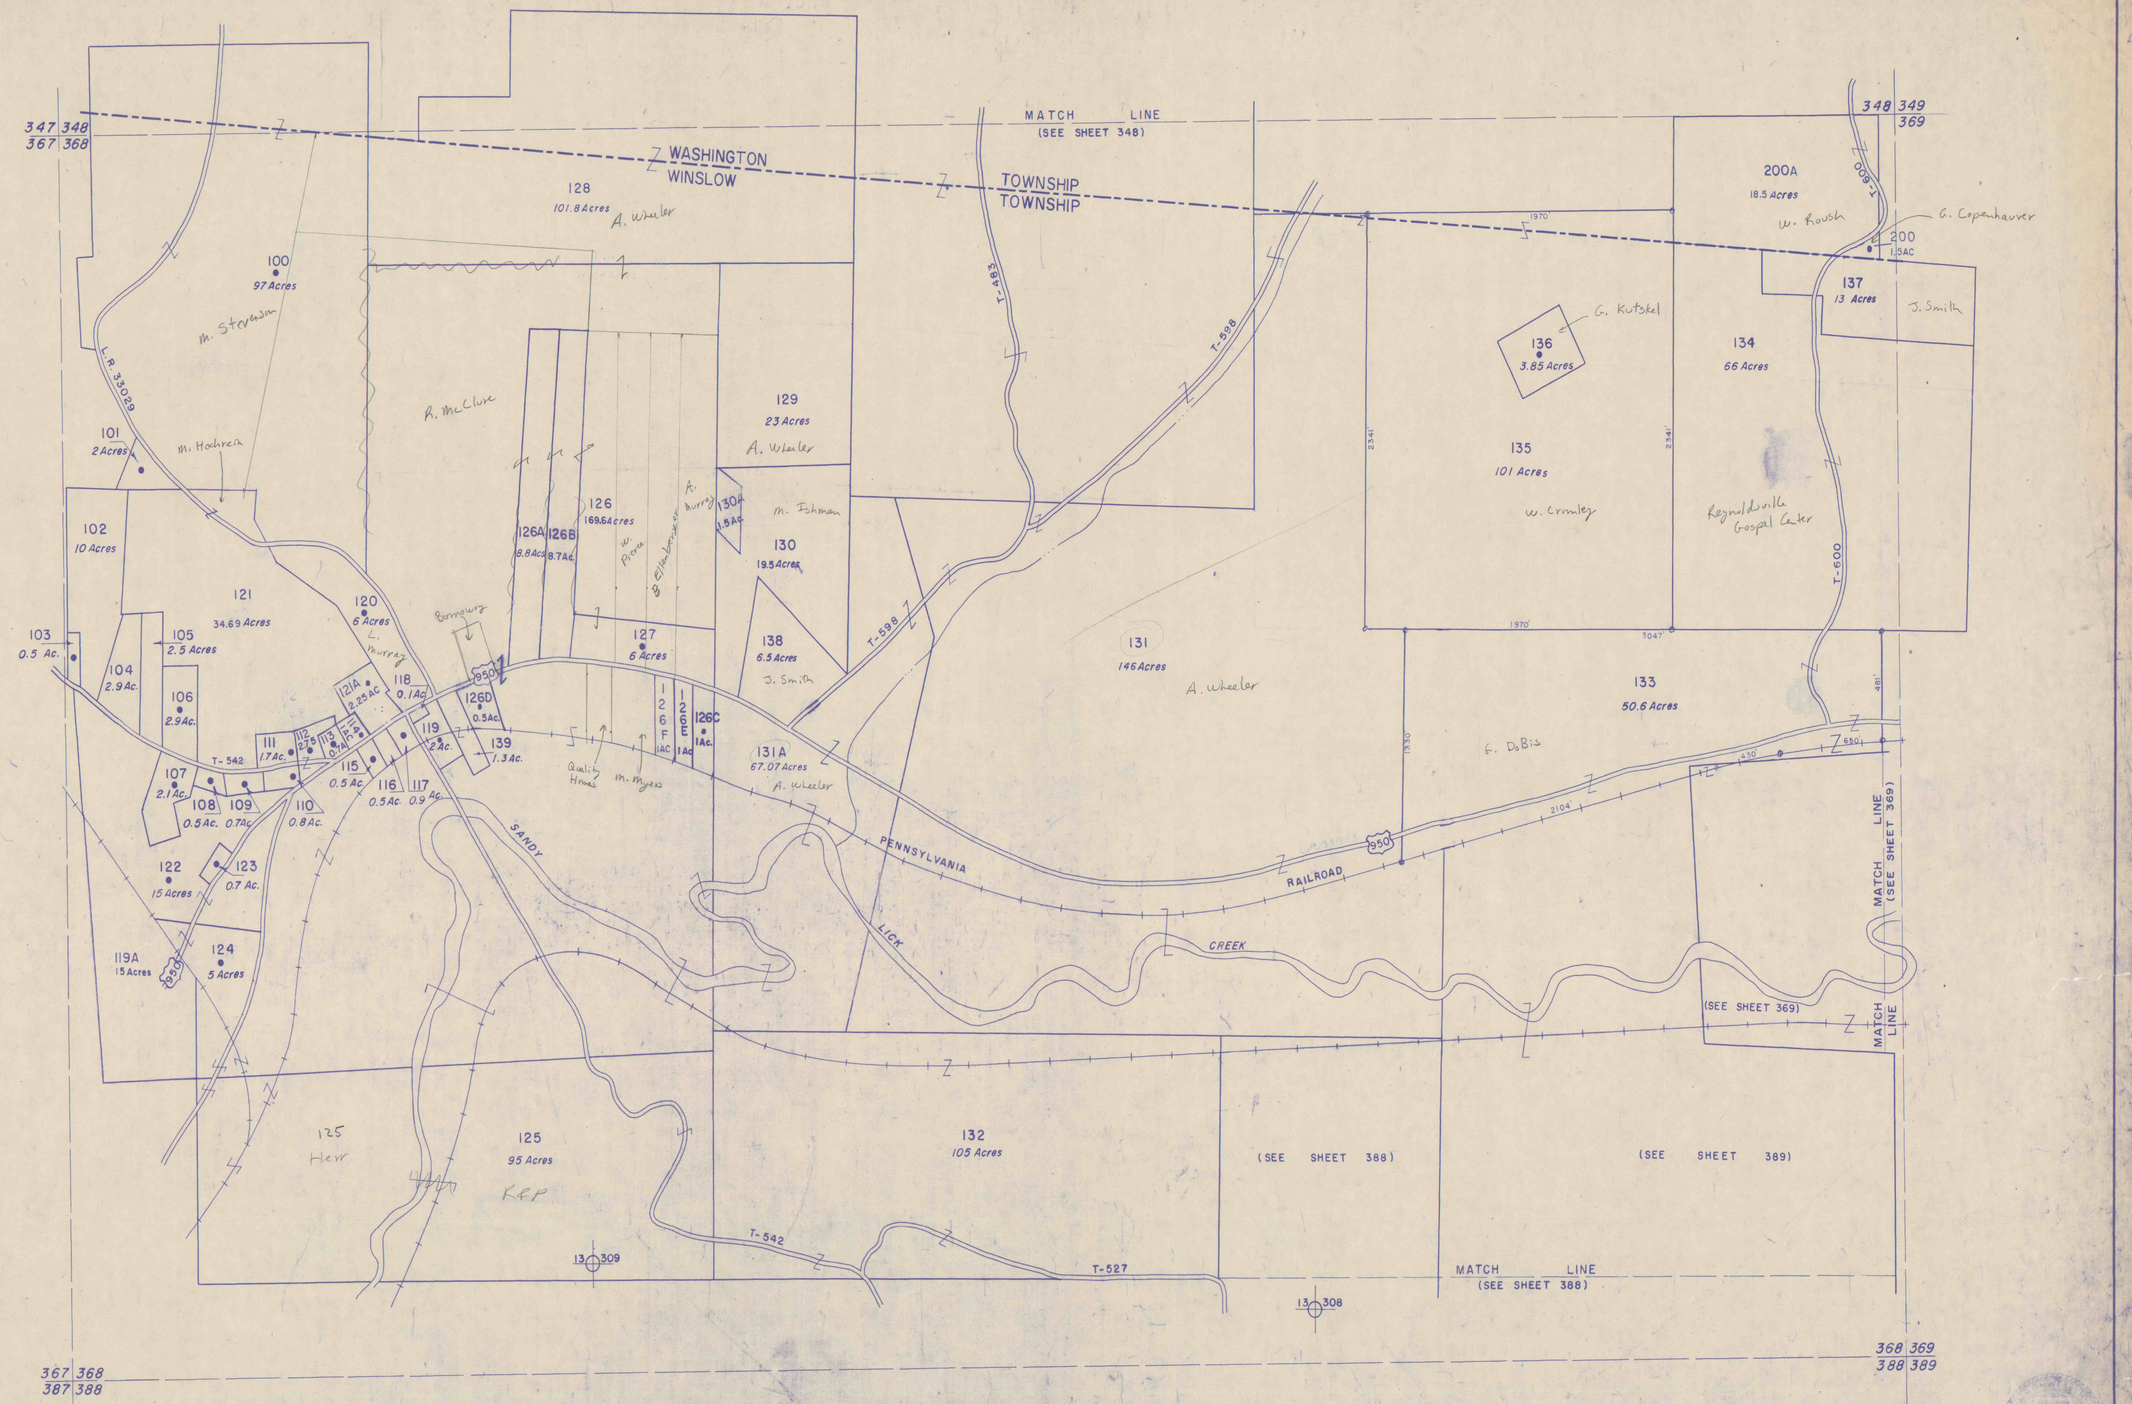

Owners as of 1-25-88 HJP

DATE	REVISIONS	BY
2-8-62		JE

400 0 400 800
SCALE IN FEET

MICHAEL BAKER, JR., INC.
Consulting Engineers
ROCHESTER, PENNSYLVANIA

KEY MAP
348
367 368 369
388

JEFFERSON COUNTY
Pennsylvania
1957

WINSLOW TOWNSHIP
WASHINGTON TOWNSHIP

10556-85

DISTRICT NO. 40-39

SHEET NO. 368