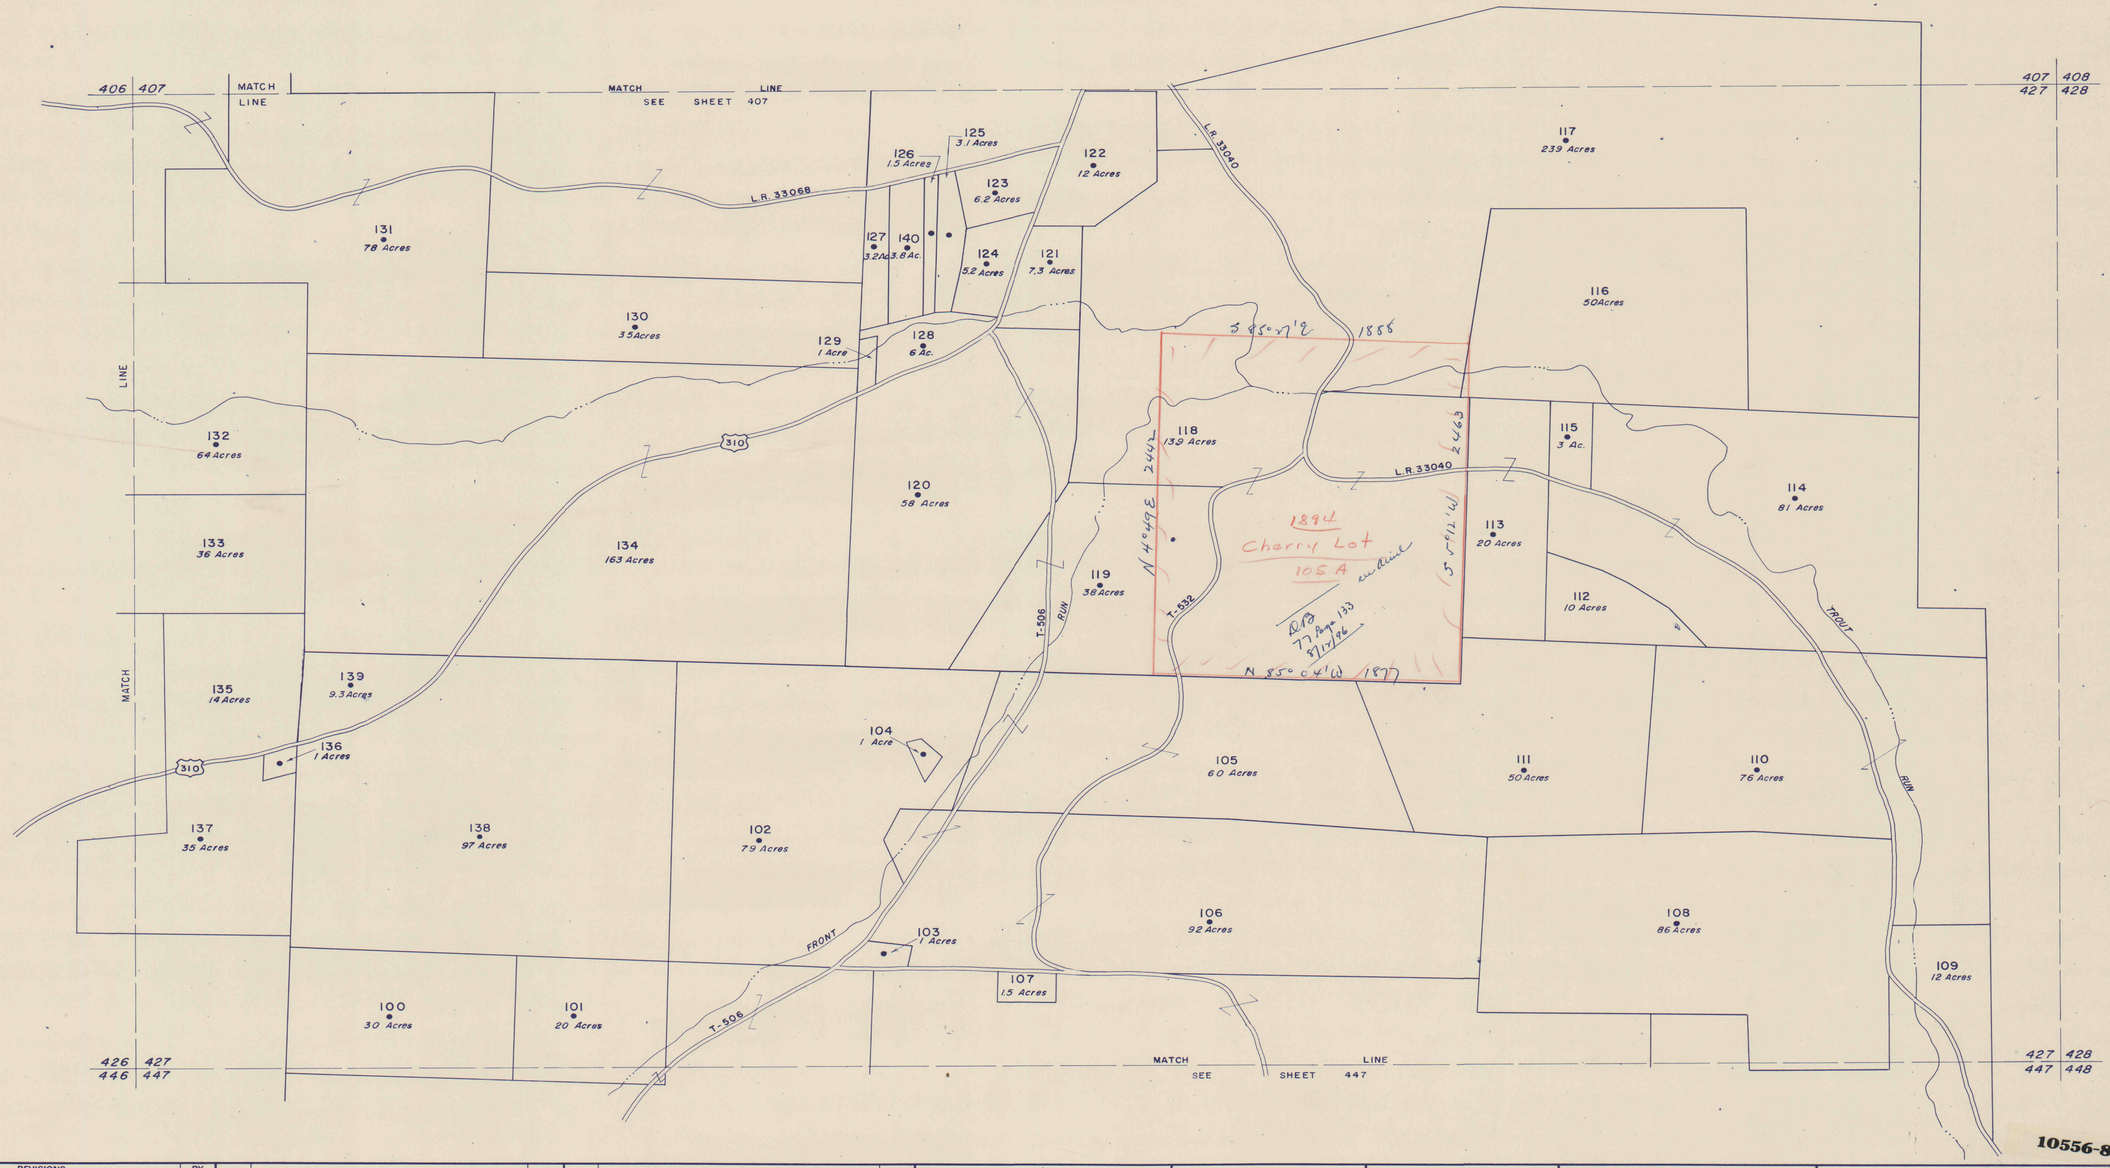

10556-85

DATE	REVISIONS	BY

400 0 400 800
SCALE IN FEET

MICHAEL BAKER, JR., INC.
Consulting Engineers
ROCHESTER, PENNSYLVANIA

KEY MAP
407
426 427 428
447

JEFFERSON COUNTY
Pennsylvania
1957

WINSLOW TOWNSHIP
10556-85

DISTRICT NO. 40
SHEET NO. 427