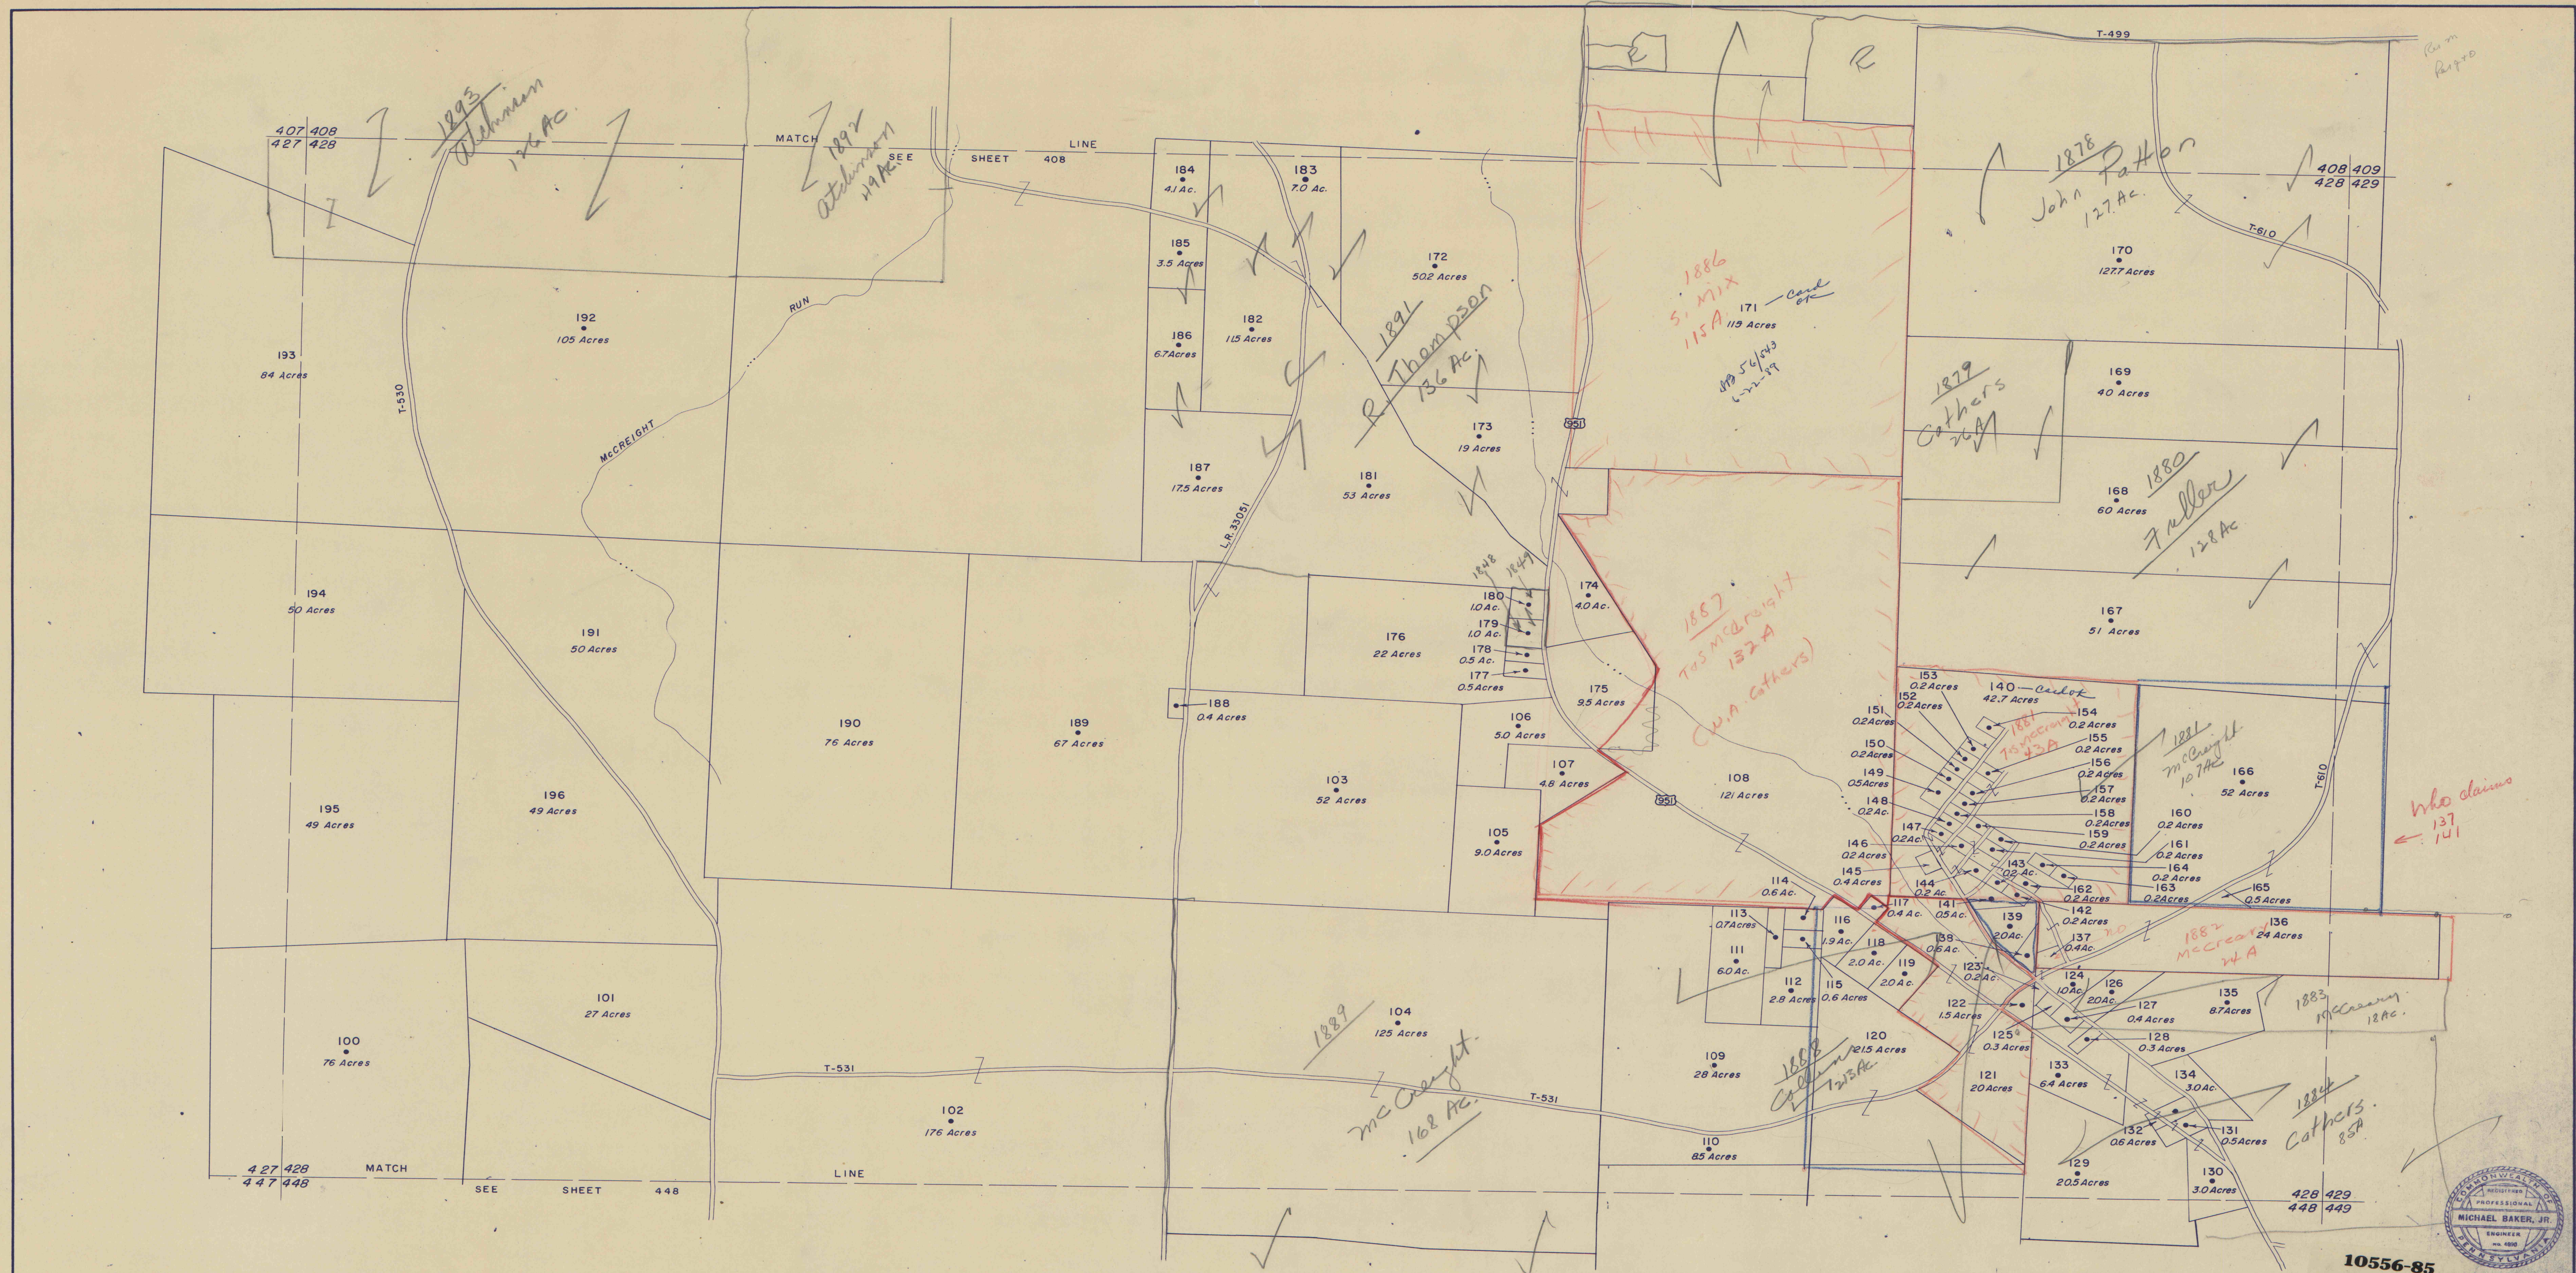
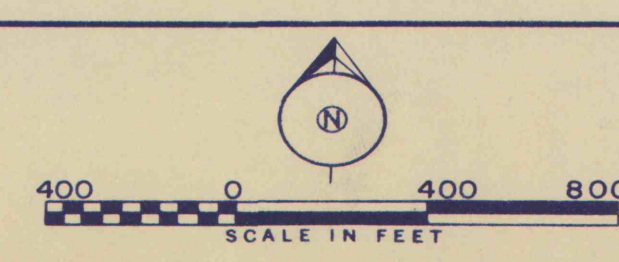


[illegible]

MICHAEL BAKER, JR., INC.
Consulting Engineers
ROCHESTER, PENNSYLVANIA


KEY MAP

	408	
427	428	429
	448	

JEFFERSON COUNTY
Pennsylvania
1957

WINSLOW TOWNSHIP
10.556-85

10556-85

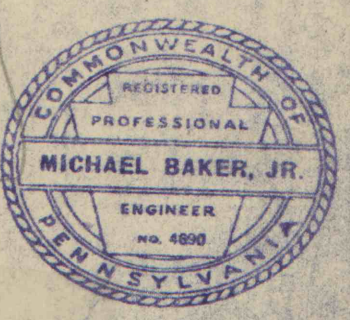

DISTRICT NO.
40
SHEET NO.
428