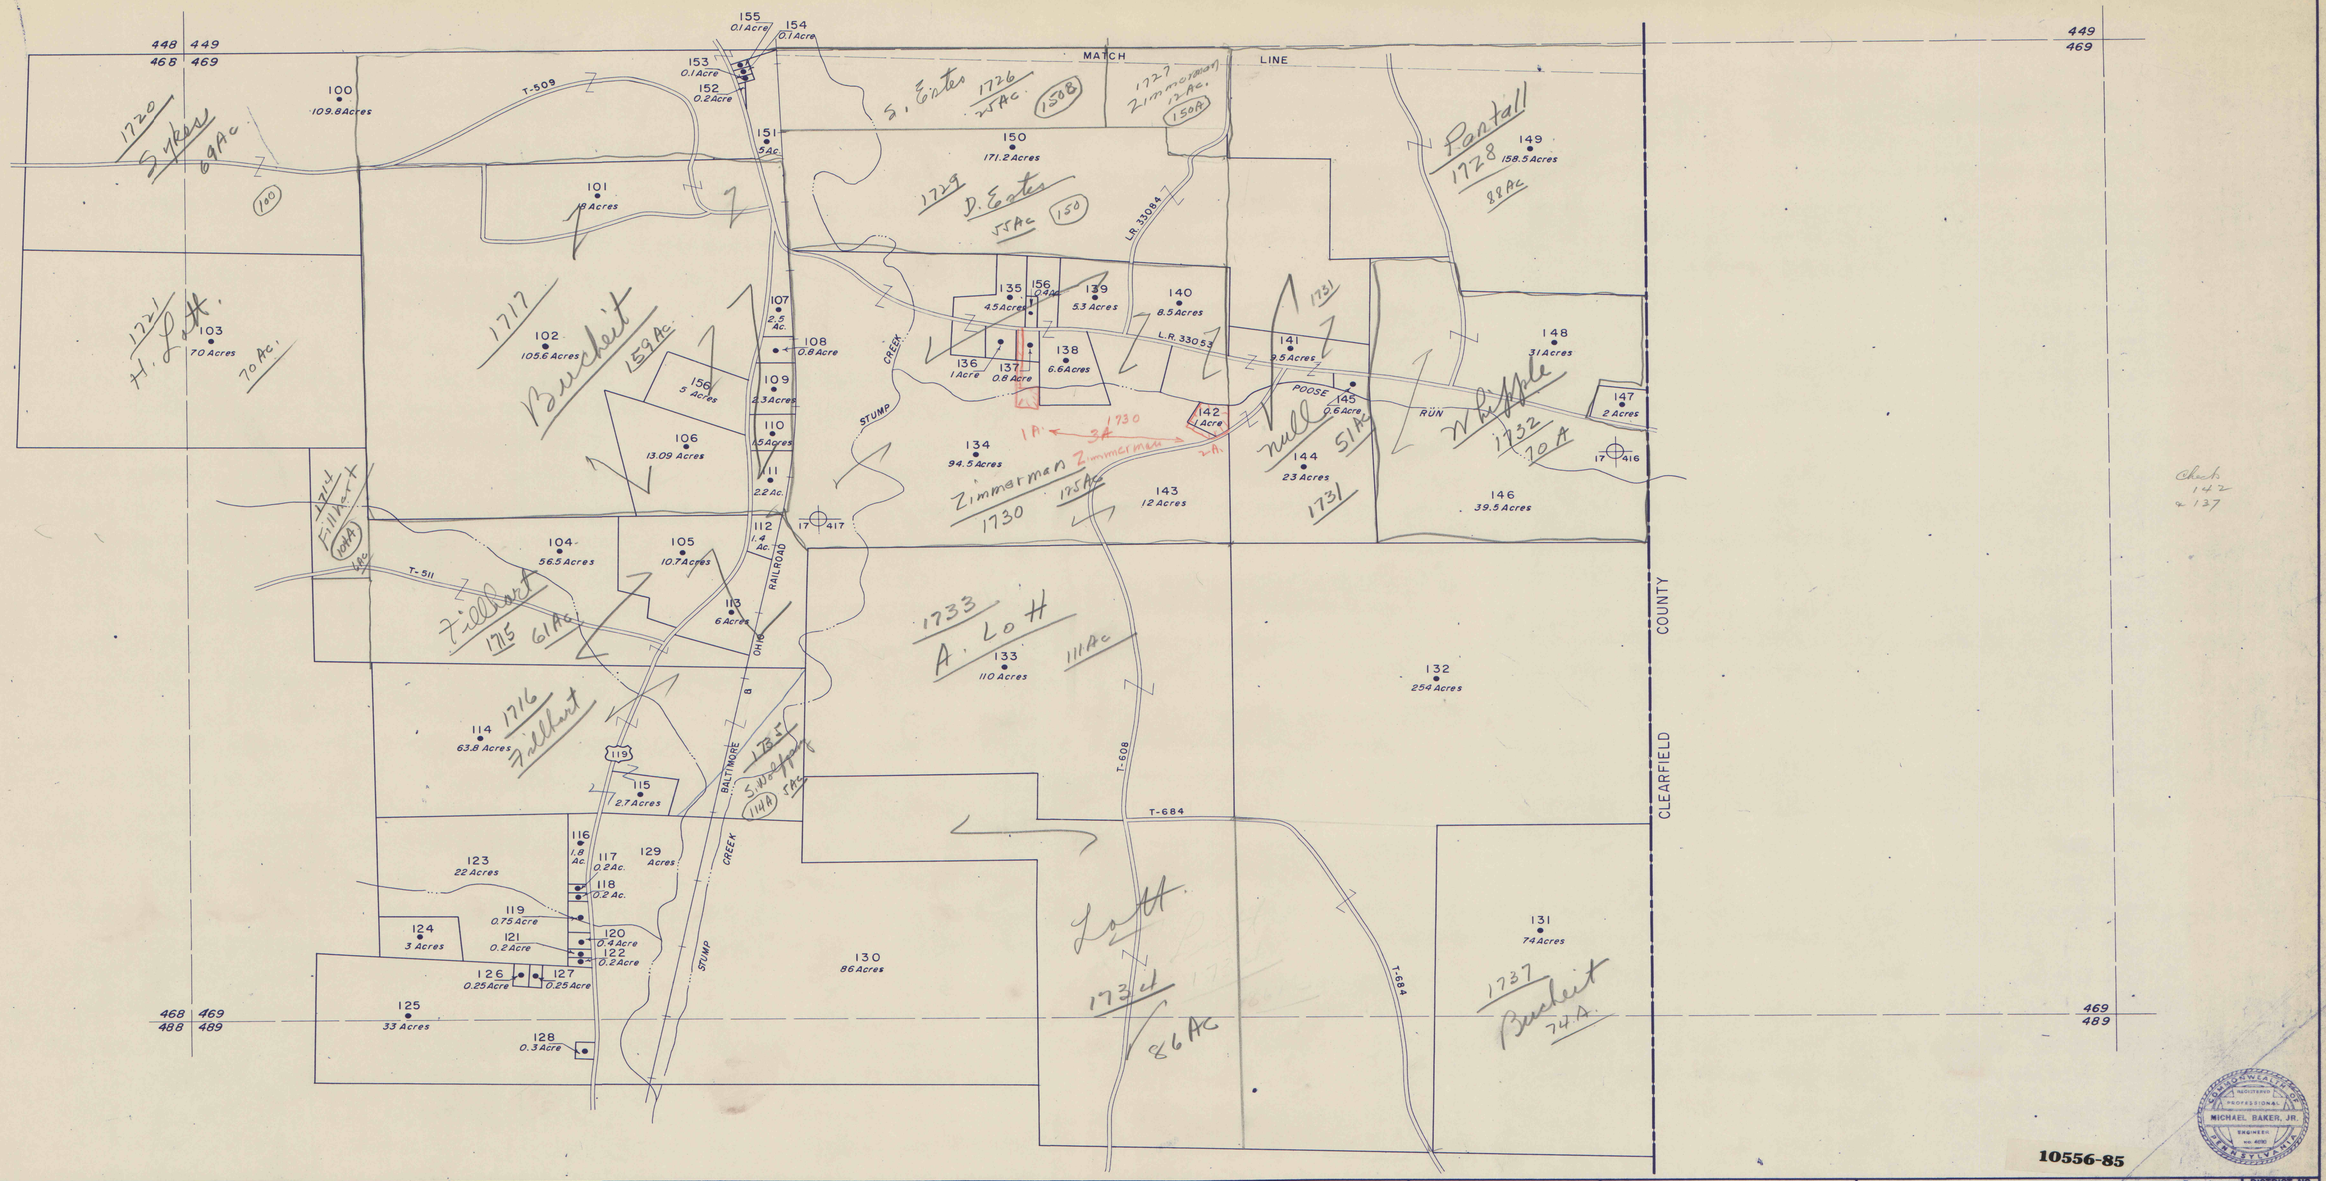

DATE	REVISIONS	BY

400 0 400 800
SCALE IN FEET

MICHAEL BAKER, JR., INC.
Consulting Engineers
ROCHESTER, PENNSYLVANIA

KEY MAP
449
468 469
489

JEFFERSON COUNTY
Pennsylvania
1957

HENDERSON TOWNSHIP
10556-85

DISTRICT NO. 13
SHEET NO. 469