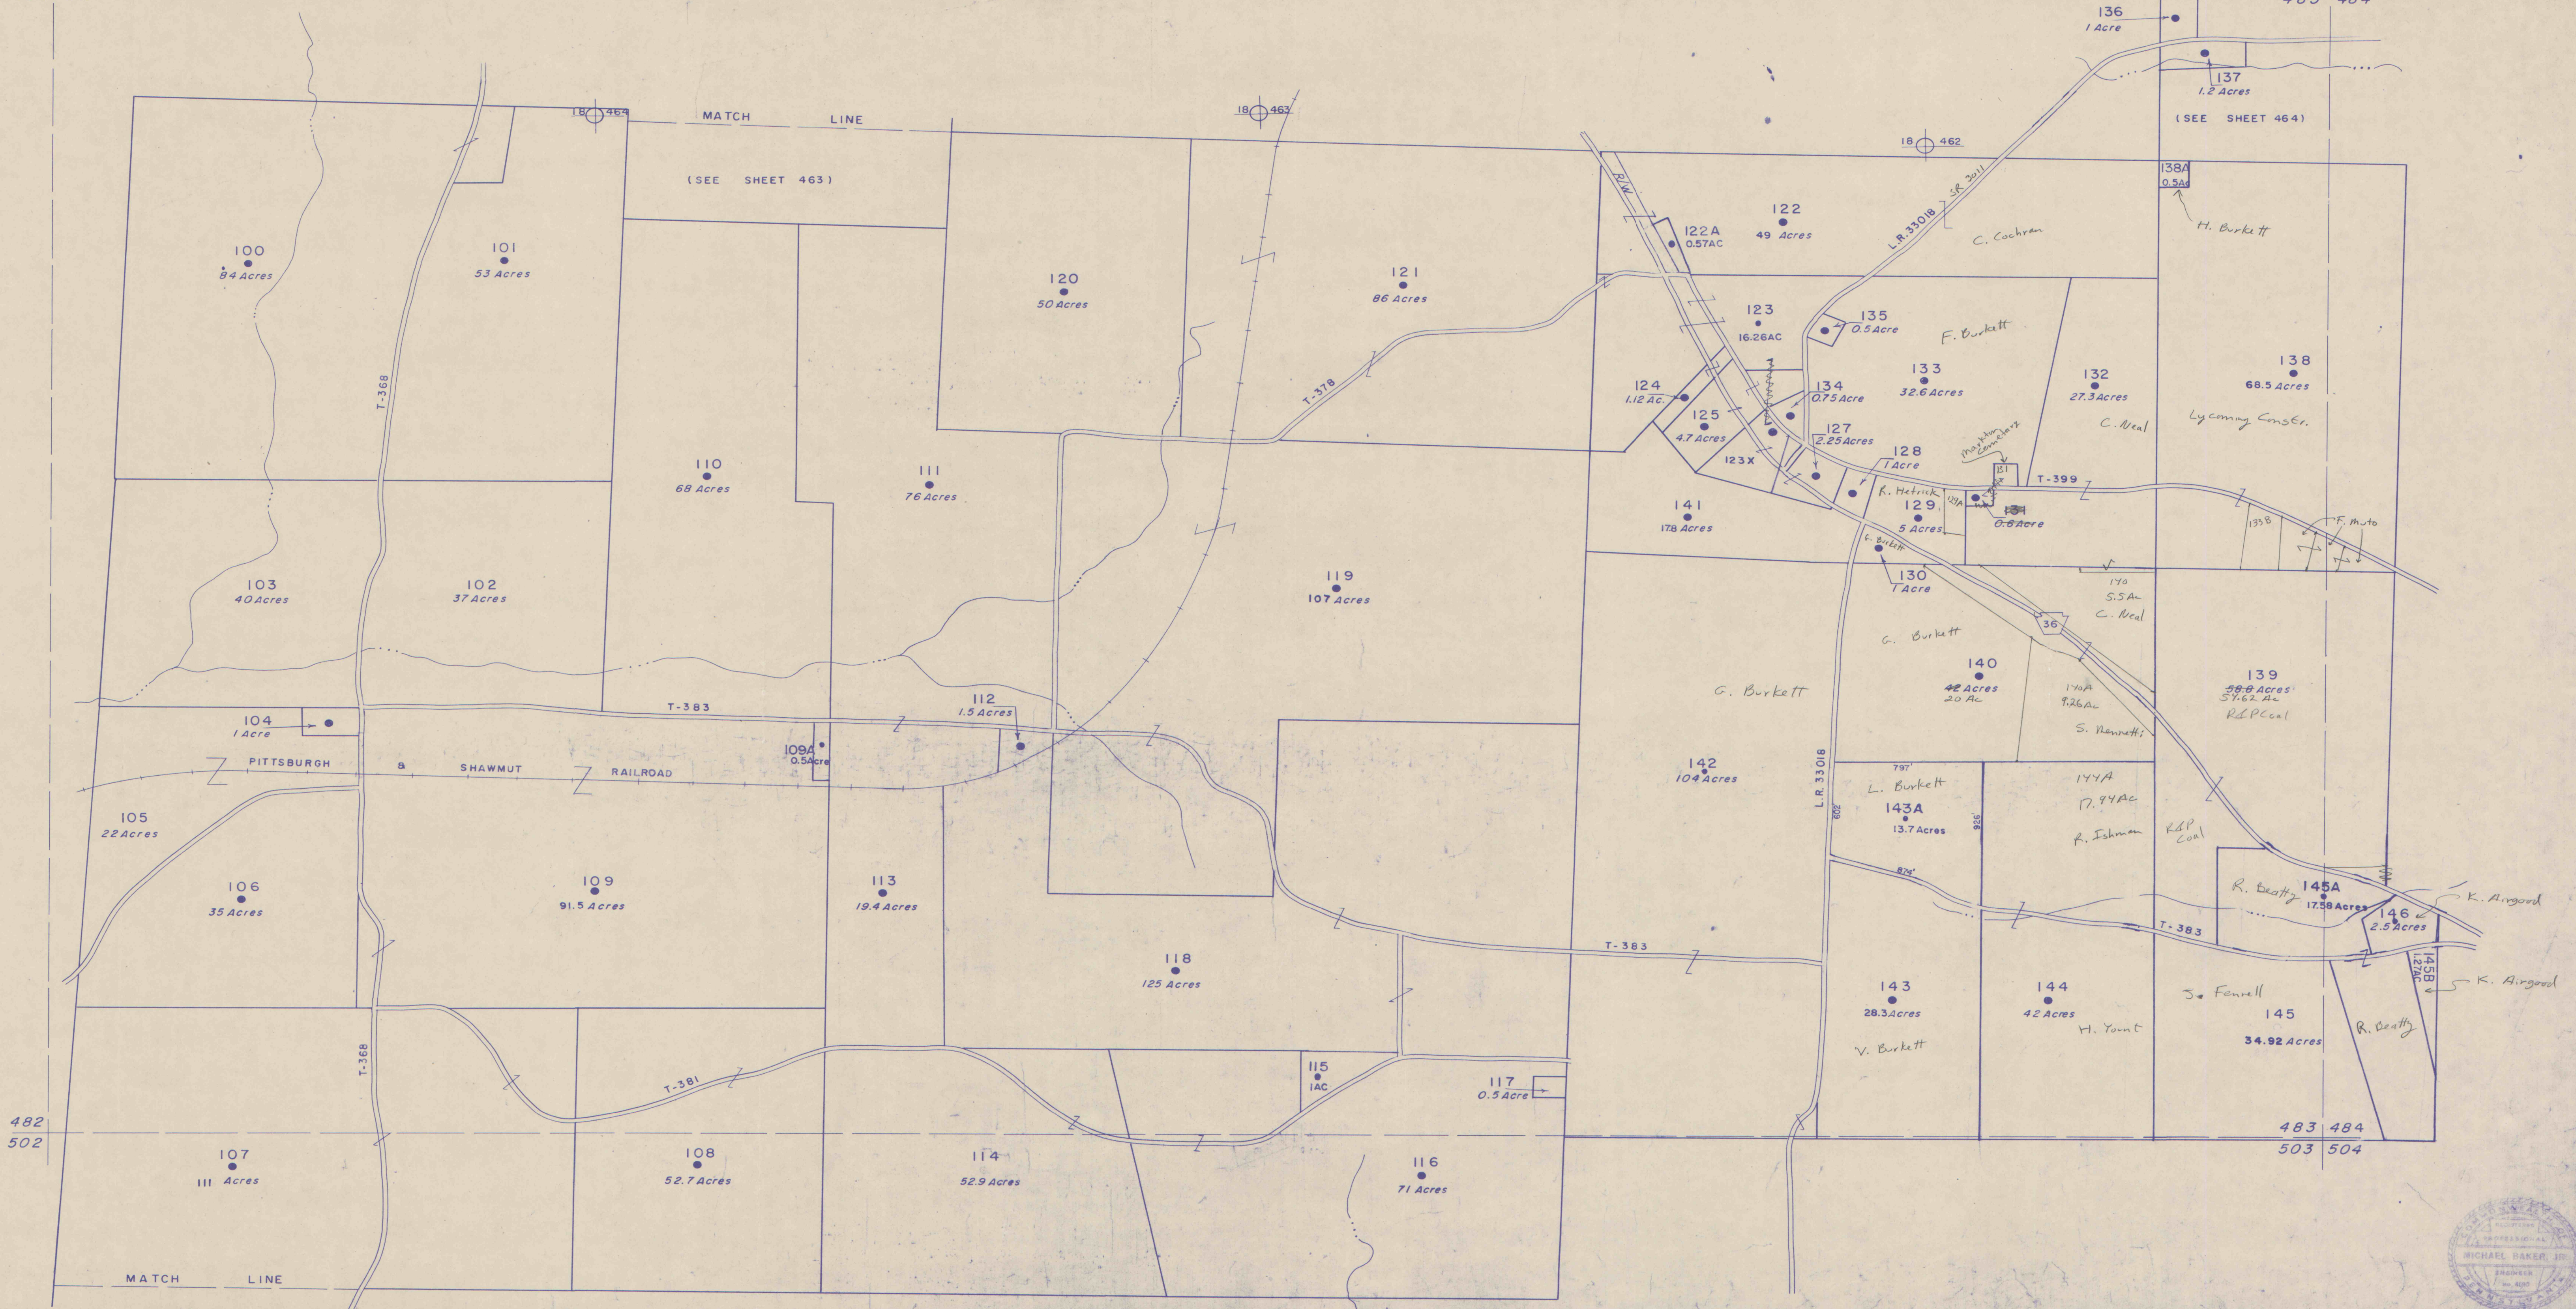
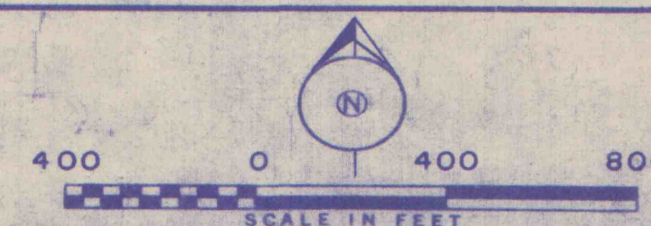


[illegible]

MICHAEL BAKER, JR., INC.
Consulting Engineers
ROCHESTER, PENNSYLVANIA

KEY MAP		
	463	
482	483	48
	503	

JEFFERSON COUNTY
Pennsylvania
1957

10556-85
OLIVER TOWNSHIP

DISTRICT NO.
16
SHEET NO.
483