


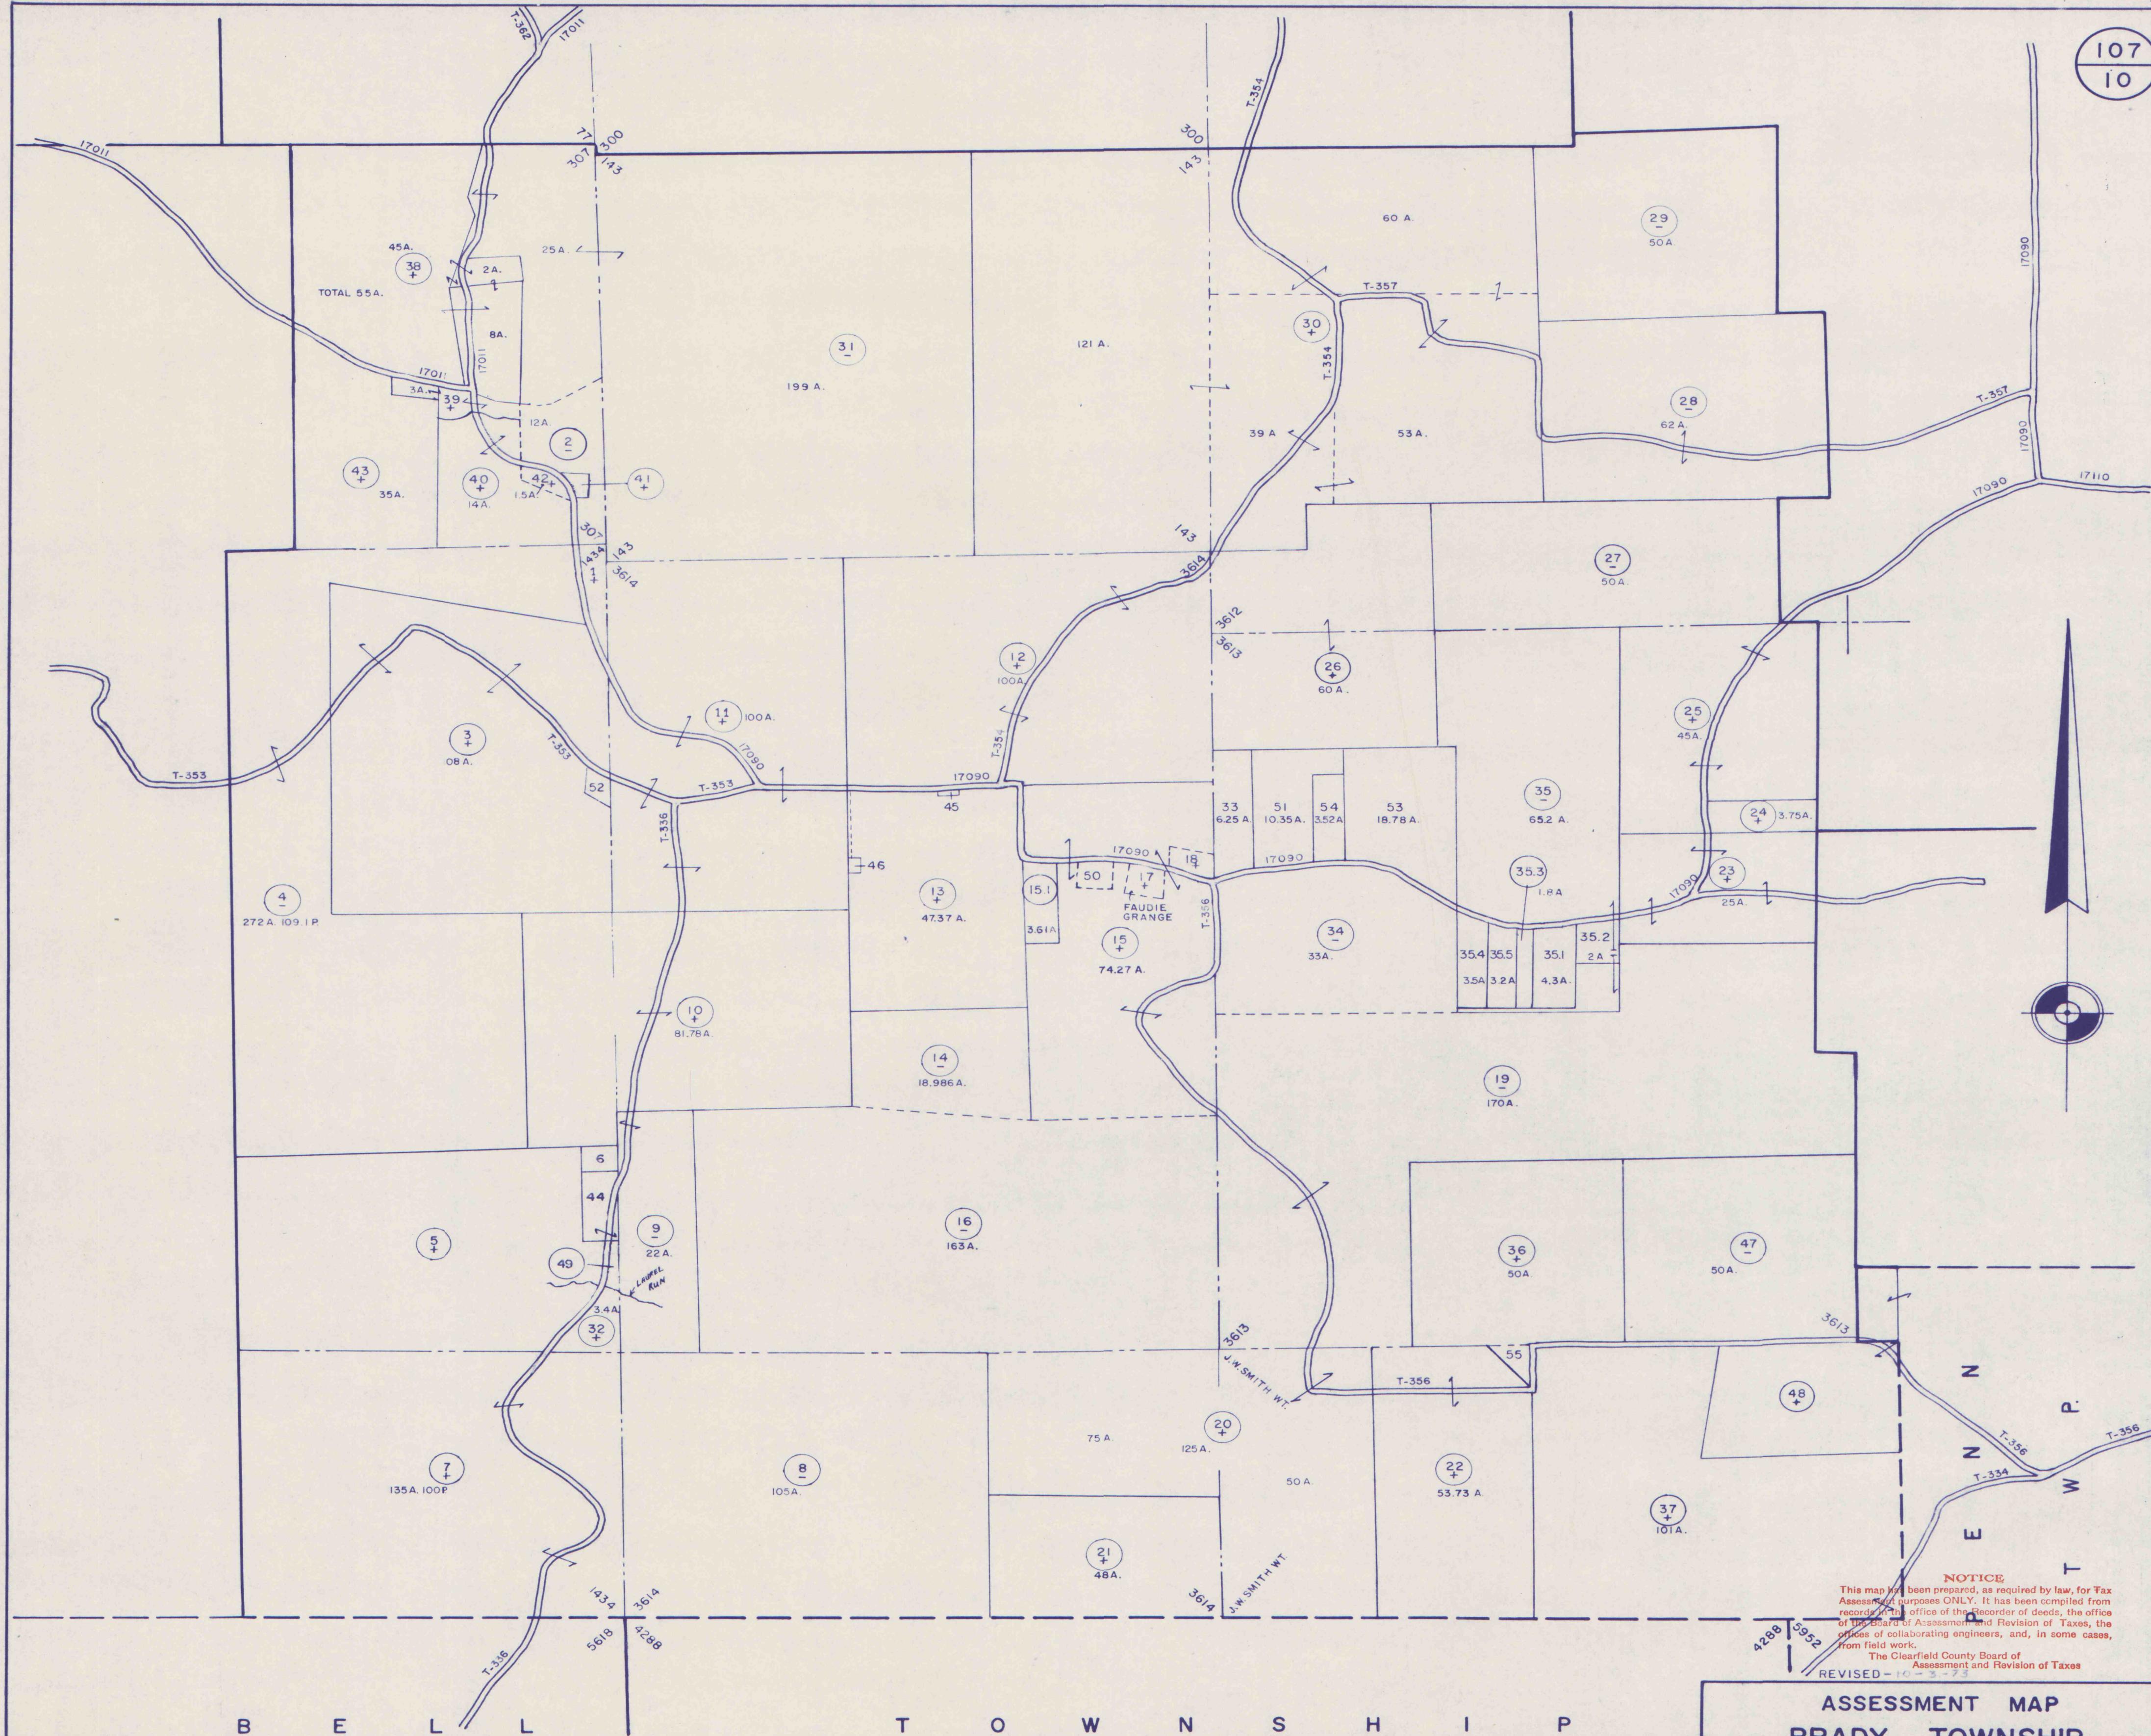

ASSESSMENT MAP
BRADY TOWNSHIP
CLEARFIELD COUNTY
PENNSYLVANIA

SCALE 1"=660' AD-1957

MAP NO.

C7

C7

1. Swartzlander, Joseph L.
2. Swartzlander, Joseph L.
3. Rimer, Douglas.
4. Bruno, Thomas & Anita
5. Galentine, George W. Jr. & Lydia
6. Galentine, George Jr.
7. Fleming, Don & H. Faye
8. Bean, Calvin
9. Marshall, Jos.
10. Price, Ed
11. Donahue, Carl & Nellie H.
12. Miknis, Peter Hairs
13. Hartzfeld, Eugene
14. Hartzfeld, Eugene E. & Arvilla N.
15. Gontero, Clyde
- 15A Gontero, Clyde
- 15.1 Keagle, Sheldon & Virginia
16. Buterbaugh Bros. Land & Timber
17. Faudie Grange
18. Faudie School
19. Buterbaugh Bros. Land & Timber
20. Swope, Grace L.
21. Beam, Wm. A., Elizabeth
Gertrude & Harry A.
22. Selester, Michael H. & Alyce E.
23. Galetine, Harry
24. Marshall, Clair
25. Swope, Ronald F. & Mary M.
26. Korb, Jesse
27. Korb, Jesse
28. Hannawell, Everett
29. Hartzfeld, Grace
30. Marshall, Orville R. & Mary Louise
31. Stahlman, Mont & Regis Ochs
32. Folser, George L. et al
33. Zilleox, Clifford E.
34. Bogle, Mary E.
35. Hartzfeld, Bryce F. & Yvonne M.
- 35.1 *NICKSON, JAMES E. SR. & JAMES E. NICKSON JR.*
36. Long, Paul L. & Helen L.
37. Nelson, Raymond & Margaret
38. Donahue, Norman E. &
Robert W. Liebeck
39. Donahue, Leo
40. Hunter, Laurence A. & Betty L.
- 40A Hunter, Laurence A. & Betty L.
41. Haag, Charles M. & Rosena L.
42. Frantz, Ester Peace
43. ~~Donahue, Carl & Nellie~~
43. Donahue, Kenneth E. & Margaret C.
43. Donahue, Lloyd & Emma Jean
43. Donahue, Sylvester & Virginia
44. Kashella, James & Lola
47. Berghoff, Bernard
48. Crowley, Joseph Trustee,
Corliss Hunting & Fishing Lodge
49. Galentine, Jack & Violet

NOTICE

This map has been prepared, as required by law, for Tax Assessment purposes ONLY. It has been compiled from records in the office of the Recorder of deeds, the office of the Board of Assessment and Revision of Taxes, the offices of collaborating engineers, and, in some cases, from field work.

The Clearfield County Board of
Assessment and Revision of Taxes