


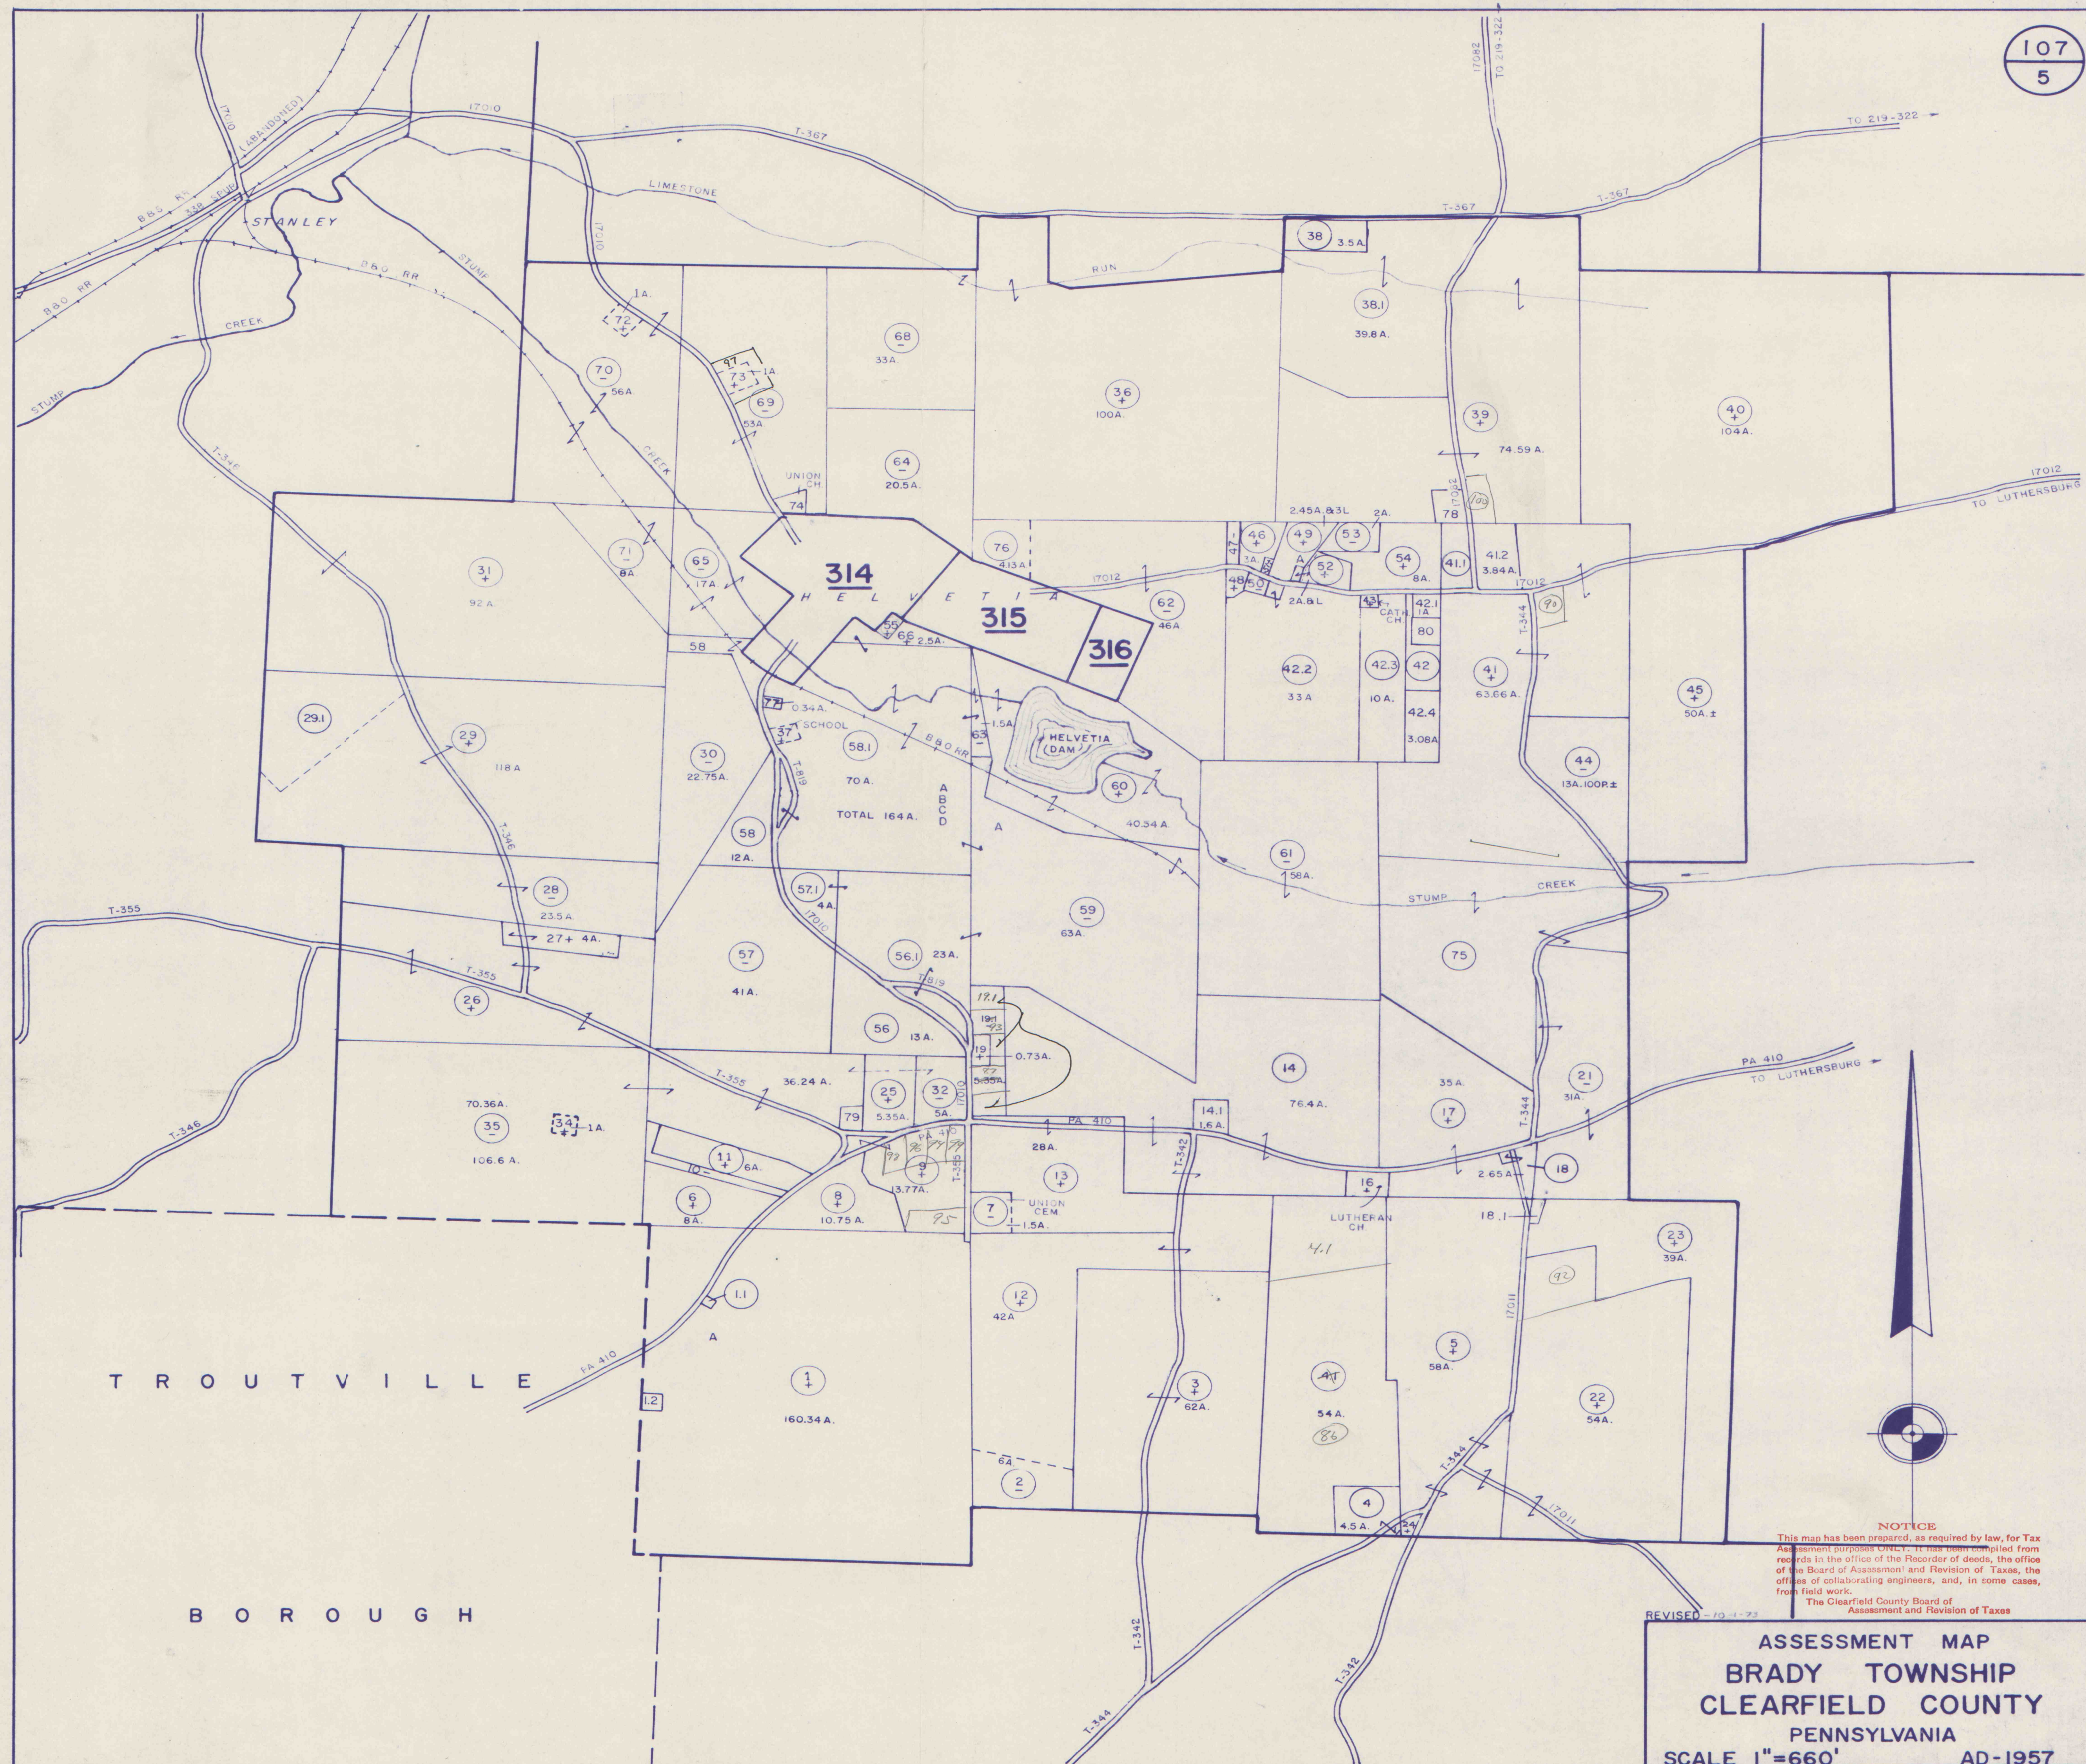

- James
A-C
1. Bonsall, A-C.
1A. Bonsall, A. C.
2. Bonsall, A-C.
3. Amundson, Roald S. & Jane F.
4. Marshall, Merle V. & Arvilla J.
4.1 ^{Bundy} Marshall, Merle V. & Patricia Ann
Bundy, Merle V. & Terrie
5. Kinderman, John Jr.
6. Poida, John
7. Union Cemetery
8. Cousins, Richard W. & Alice E.
9. Conway, Richard H. & Mary Ellen
10. ~~Douglas, John~~ } Noah Y. & Lydia Jane Yoder
11. ~~Douglas, John~~ } RD 4 Dubois
12. Barabas, Joseph
13. Barabas, Joseph
13. Barabas, John
* 14. Chernesky, Henry & Joe Barabas
14.1 Chernesky, Henry & Mary Barabas
15.
16. Salem Lutheran Church
17. Schindley, William L. & Smily J.
18. Askey, Ira D. Jr. & Jessie M.
19. Shugarts, Harry
19.1 Chernesky, Henry W. & Mary E.
20.
21. Marshall, Irvin C.
22. Marshall, Irvin C.
23. Marshall, Roy
24. Kinderman, John
25. McAninch, Lerry C. & Connie J.
26. Haag, Arthur L. & Dorothy L.
27. Scribe, John B. & Beverly P.
28. Haag, Amos G. & Melissa Jane
29. Haag, Melissa Jane
29.1 Srock, Richard A. & Margaret
30. Haag, Amos G. & Melissa Jane
31. Srock, Richard August & Leah
Margaret
32.
33.
34. Rochester & Pittsburgh Coal Co.
35. Haag, Arthur L. & Dorothy L.
36. Harvey, William T.
37. Helvetia School
38. Peterson, Renis E. & Helen W.
38.1 Mann, Conrad L. & Linda J.
39. Clinchcock, Joseph Jr. & Bertha
40. Schindley, Victor L. & Martha
41. Schindley, Victor D. & Martha
41.1 Turner, James L. & Shirley M.
42. Campbell, Henry B. & Sarah H.
42.1 Campbell, Henry B. Jr. & Lieselotte
42.2 Langham, John R. & Margaret F.
43. Catholic Church
44. Phillips, Albert J. & John J.
45. Phillips, Albert J. & John J.
46. Brown, Fred J.
47. Leis, Victor P.
48. Bloom, Orvis W.
49. Sekula, Paul & Cecelia
49A Sekula, Paul & Cecelia
50. Sekula, Paul & Cecelia
51. Gardner, Donald D.
52. Heffner, Benjamin & Ruby
53. Kopnitsky, Victor
54. Gardner, Donald D.
- * 55. Kozloski, Charles et al
56. Rochester & Pittsburgh Coal Co.
57. Rochester & Pittsburgh Coal Co.
58. Rochester & Pittsburgh Coal Co.
58A Rochester & Pittsburgh Coal Co.
58B Rochester & Pittsburgh Coal Co.
58D Rochester & Pittsburgh Coal Co.
59. Rochester & Pittsburgh Coal Co.
59A Rochester & Pittsburgh Coal Co.
60. Kovalchick, Salvage Co.
61. Rochester & Pittsburgh Coal Co.
62. Rochester & Pittsburgh Coal Co.
63. Rochester & Pittsburgh Coal Co.
64. Rochester & Pittsburgh Coal Co.
65. Rochester & Pittsburgh Coal Co.
66. Rochester & Pittsburgh Coal Co.
67. Schinley, W. L.
68. Rochester & Pittsburgh Coal Co.
69. Rochester & Pittsburgh Coal Co.
70. Rochester & Pittsburgh Coal Co.
71. Rochester & Pittsburgh Coal Co.
72. Kovalchick Salvage Co.
73. KOVALCHICK SALVAGE Co.
74. Helvetia Union Church
75. Lickey, Lulu N.
76. Helvetia Sportsmen's Club, Inc.
76.1 MINKSHALL, ROY S. & EVA B.
42.4 CAMPBELL, HENRY B. JR. & LIESELOTTE C.
1.1 BRADY TWP - TROUTVILLE BOR. WATER ASS.
1.2 BRADY TWP - TROUTVILLE BOR. WATER ASS.
42.3 GARDNER, DONALD A. & JOYCE A.
50.1 KOVALCHICK SALVAGE Co.
50.1 KOVALCHICK SALVAGE Co.
50.1 KOVALCHICK SALVAGE Co.
100
86 Hoover, William
4.1 Bundy
- 10143-85
- 5