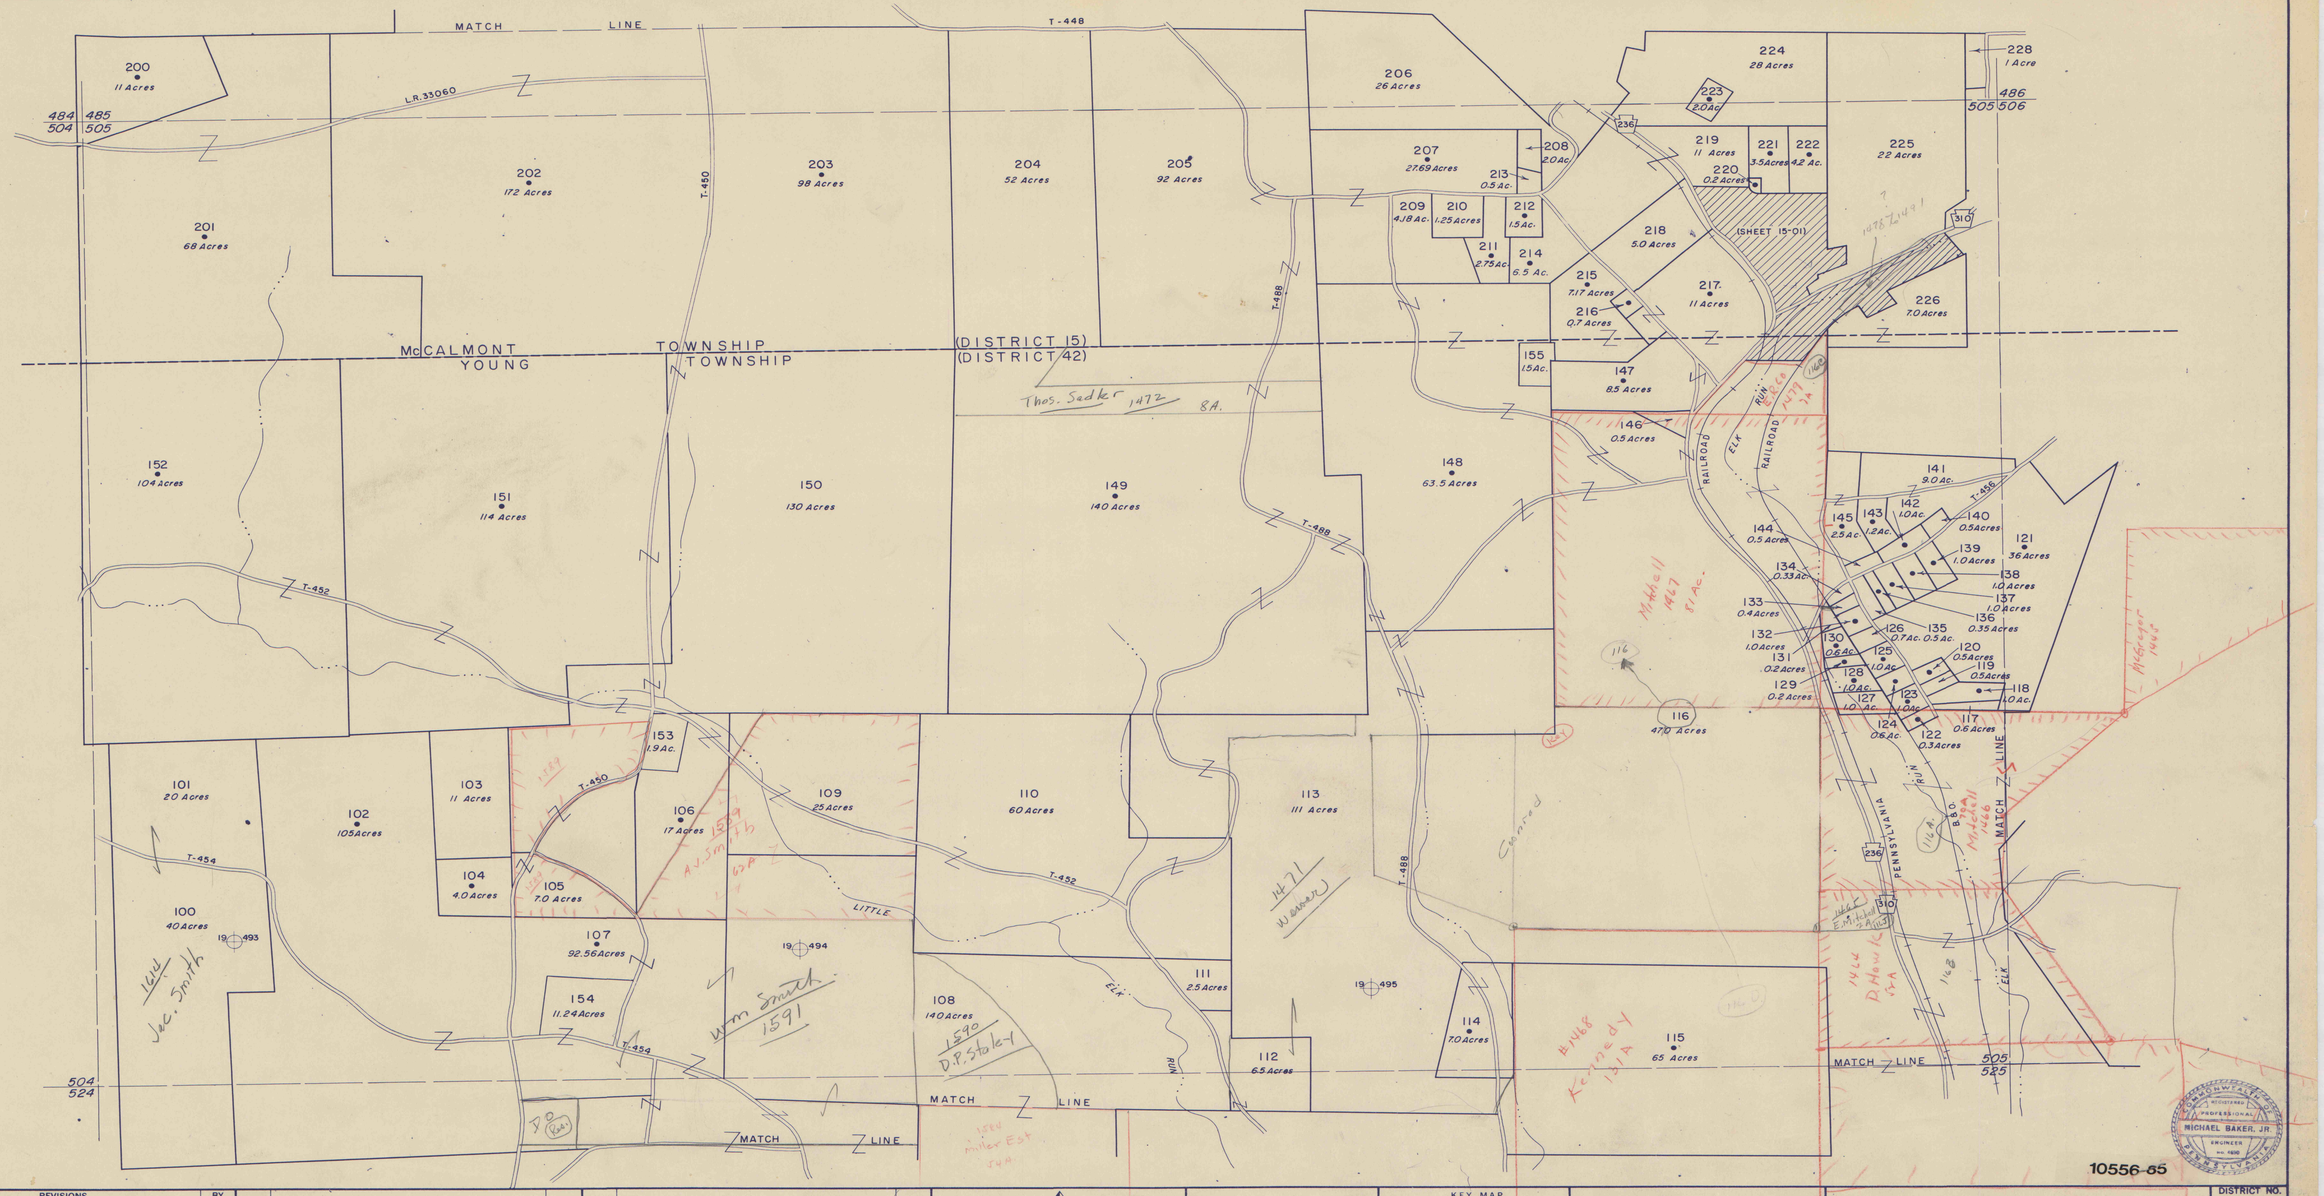

DATE	REVISIONS	BY

400 0 400 800
SCALE IN FEET

MICHAEL BAKER, JR., INC.
Consulting Engineers
ROCHESTER, PENNSYLVANIA

KEY MAP
485
505 506
525

JEFFERSON COUNTY
Pennsylvania
1957

McCALMONT TOWNSHIP
YOUNG TOWNSHIP

DISTRICT NO. 15-42
SHEET NO. 505