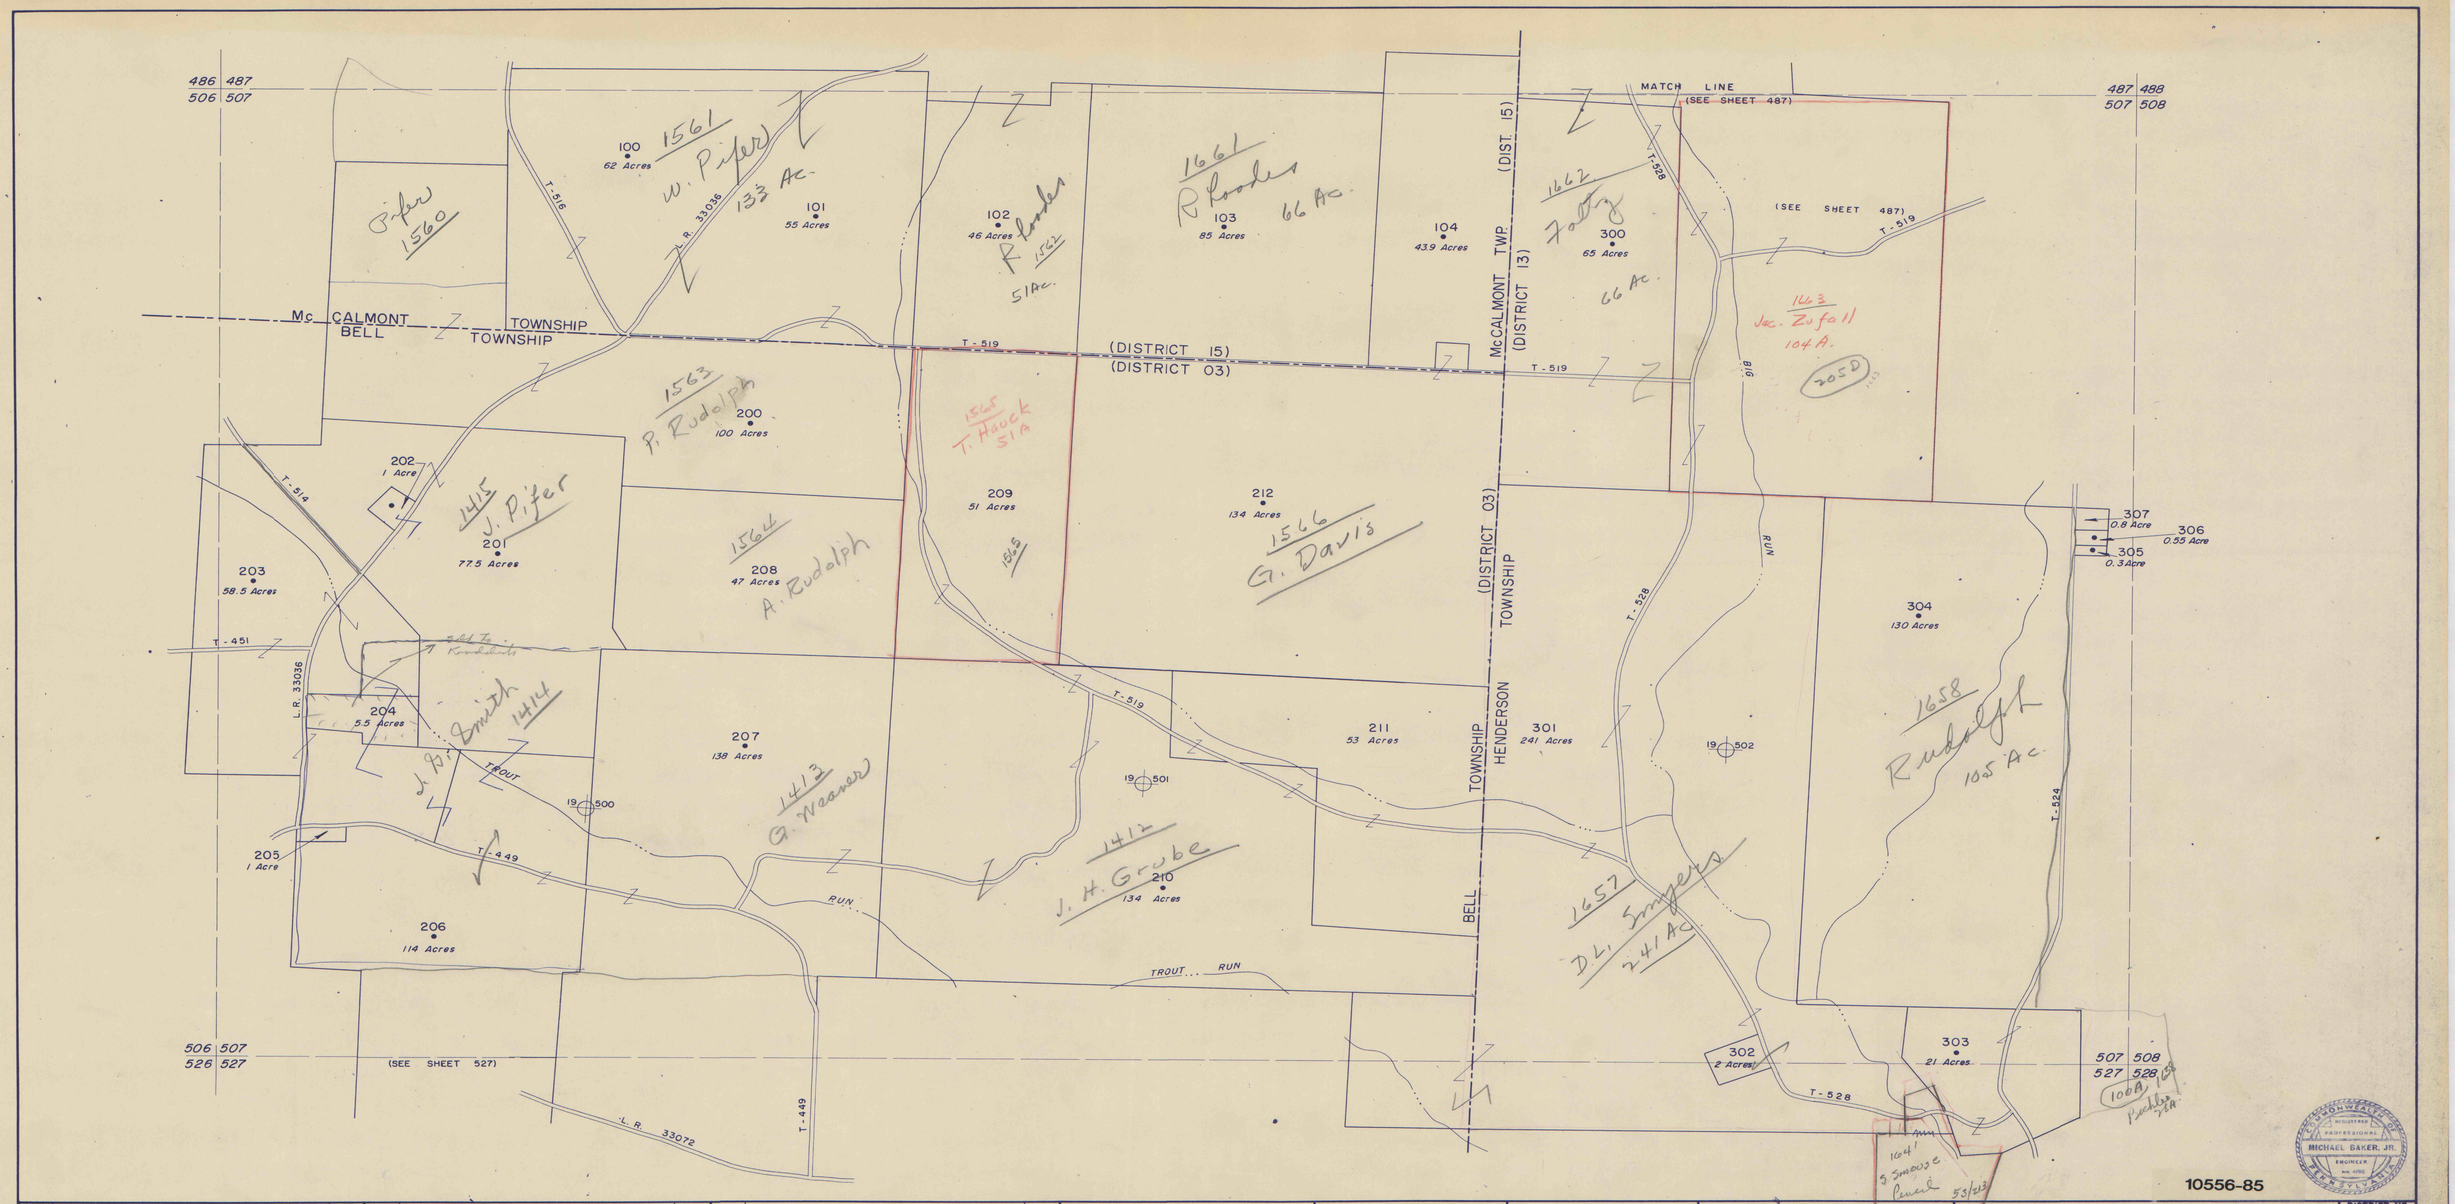

10556-85

DATE	REVISIONS	BY

SCALE IN FEET: 400 0 400 800

MICHAEL BAKER, JR., INC.
Consulting Engineers
ROCHESTER, PENNSYLVANIA

KEY MAP
487
506 507 508
527

JEFFERSON COUNTY
Pennsylvania
1957

Mc CALMONT TOWNSHIP
BELL TOWNSHIP
HENDERSON TOWNSHIP

DISTRICT NO. 15,03,13

SHEET NO. 507