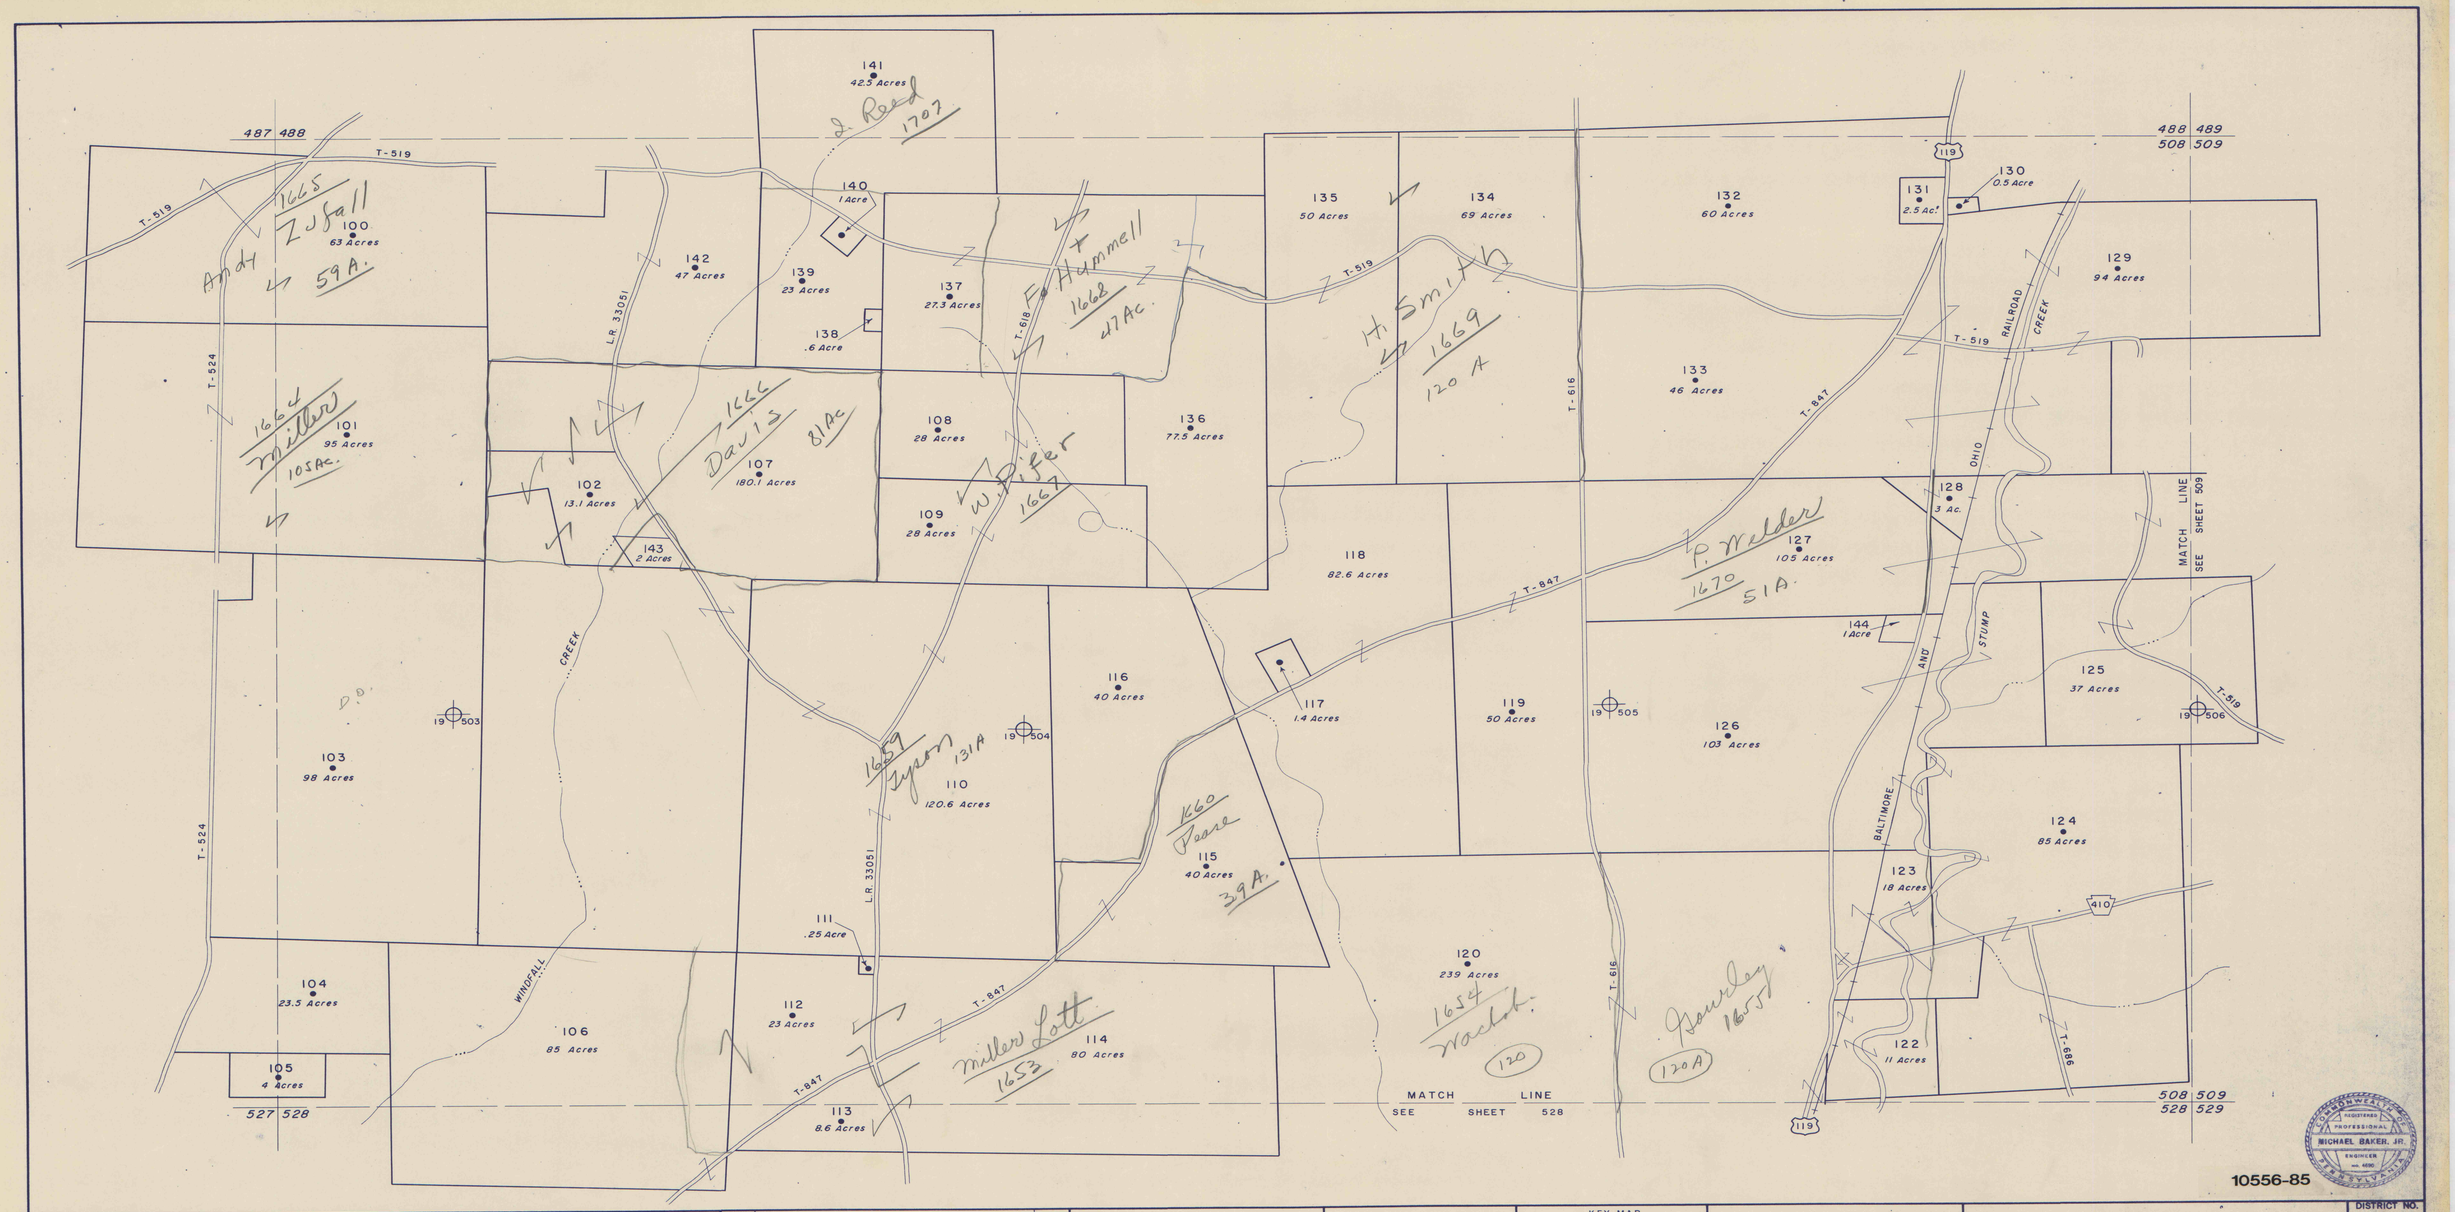

DATE	REVISIONS	BY

400 0 400 800
SCALE IN FEET

MICHAEL BAKER, JR., INC.
Consulting Engineers
ROCHESTER, PENNSYLVANIA

KEY MAP
488
507 508 509
528

JEFFERSON COUNTY
Pennsylvania
1957

HENDERSON TOWNSHIP

DISTRICT NO. 13
SHEET NO. 508