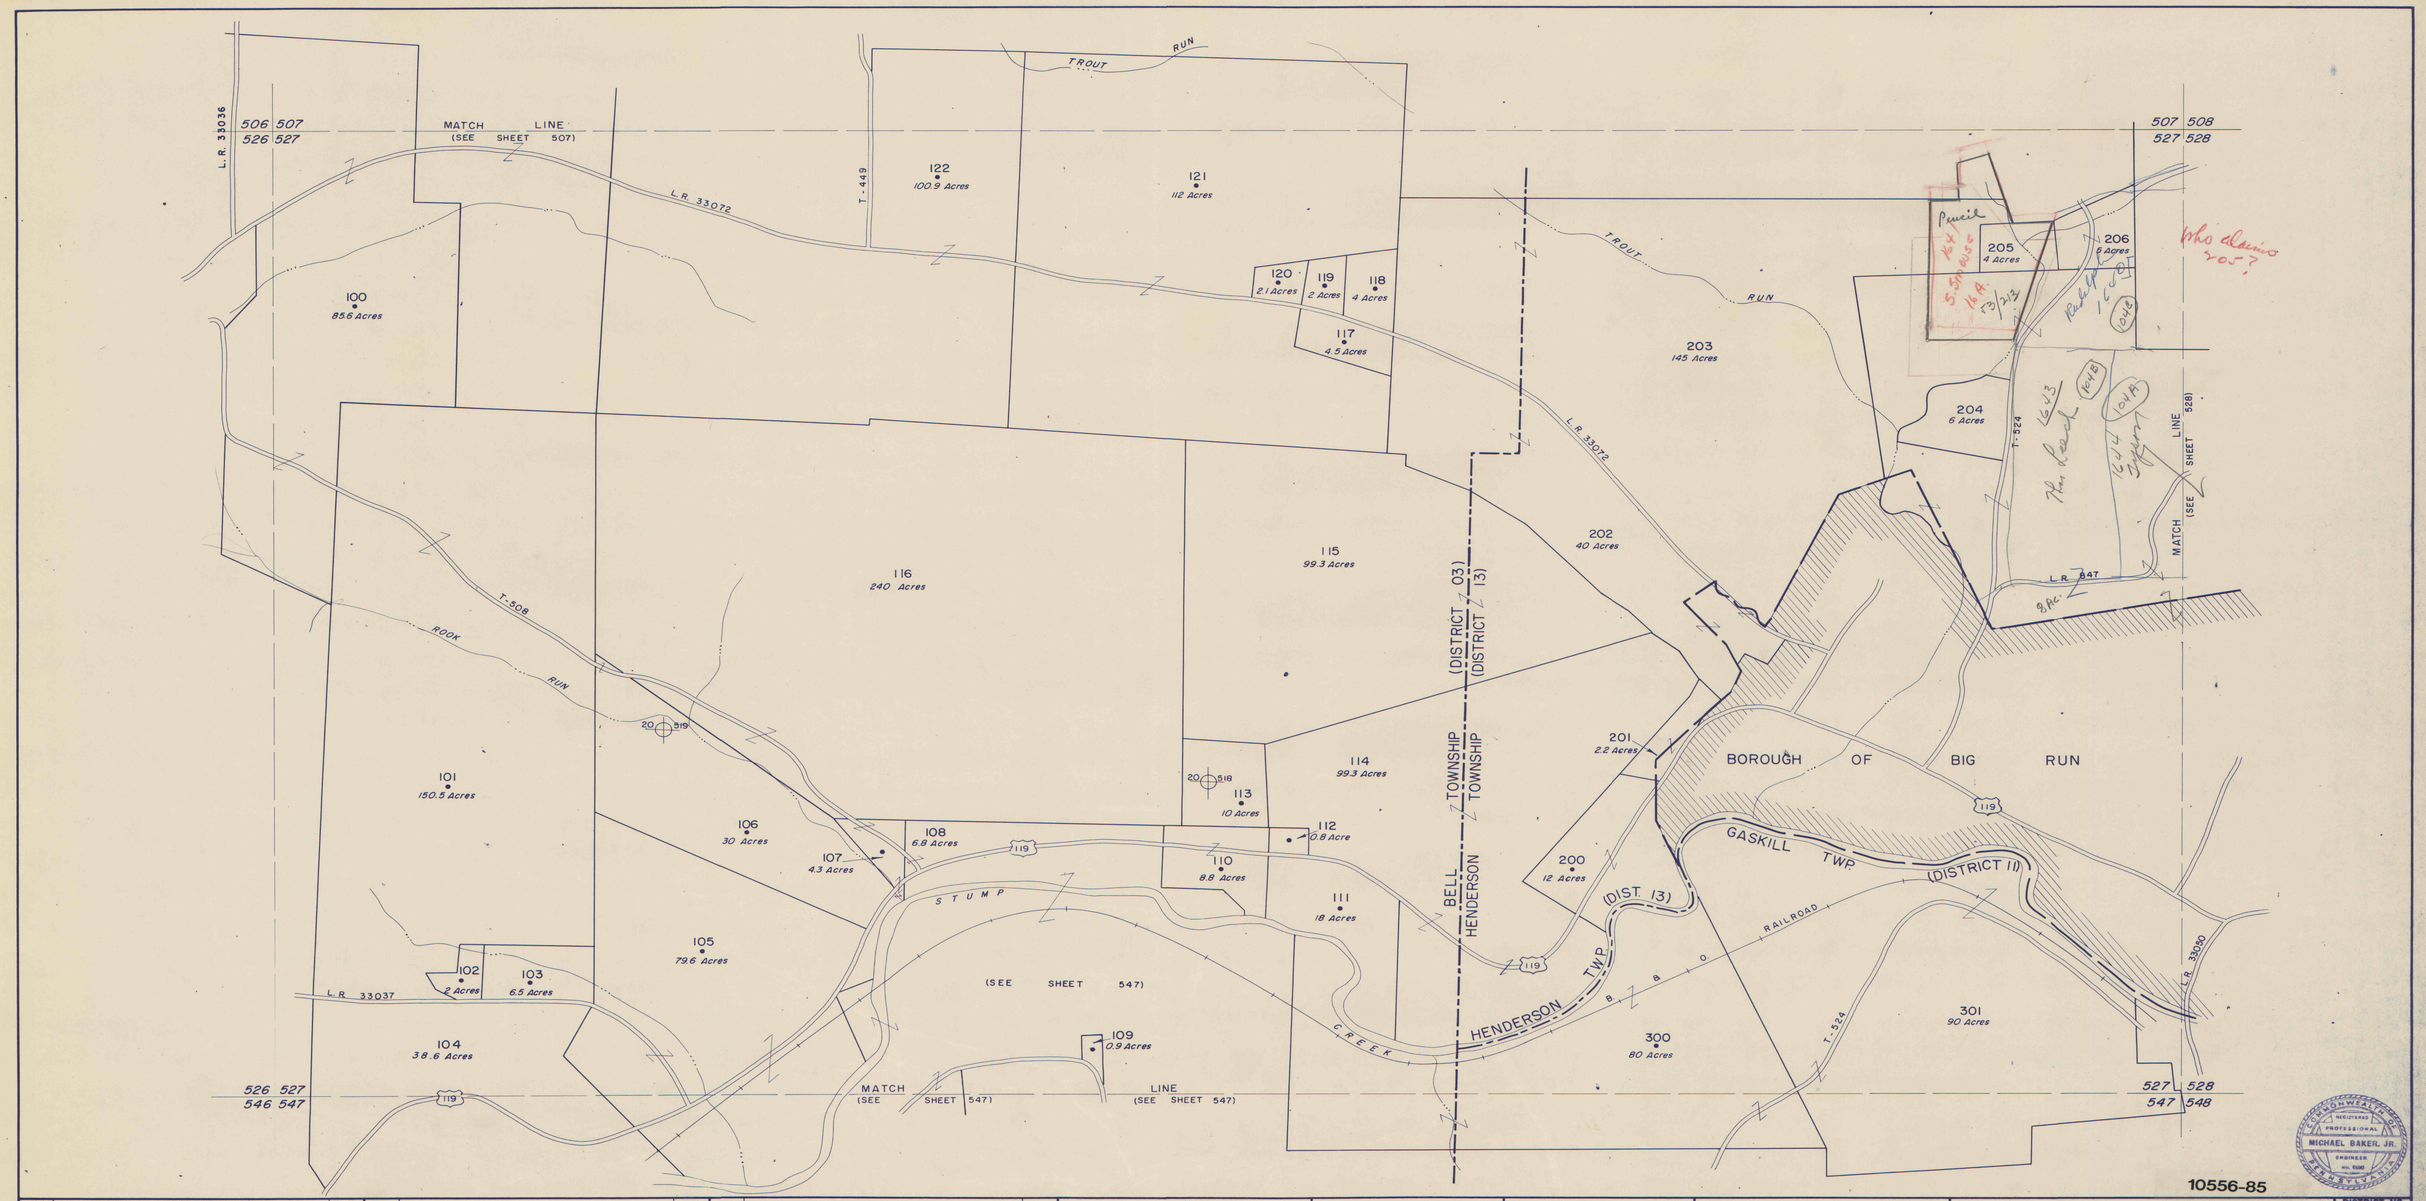

10556-85

DATE	REVISIONS	BY

400 0 400 800
SCALE IN FEET

MICHAEL BAKER, JR., INC.
Consulting Engineers
ROCHESTER, PENNSYLVANIA

KEY MAP

	507	
526	527	528
	547	

JEFFERSON COUNTY
Pennsylvania
1957

BELL TOWNSHIP
HENDERSON TOWNSHIP
GASKILL TOWNSHIP

DISTRICT NO. 03,13,11

SHEET NO. 527