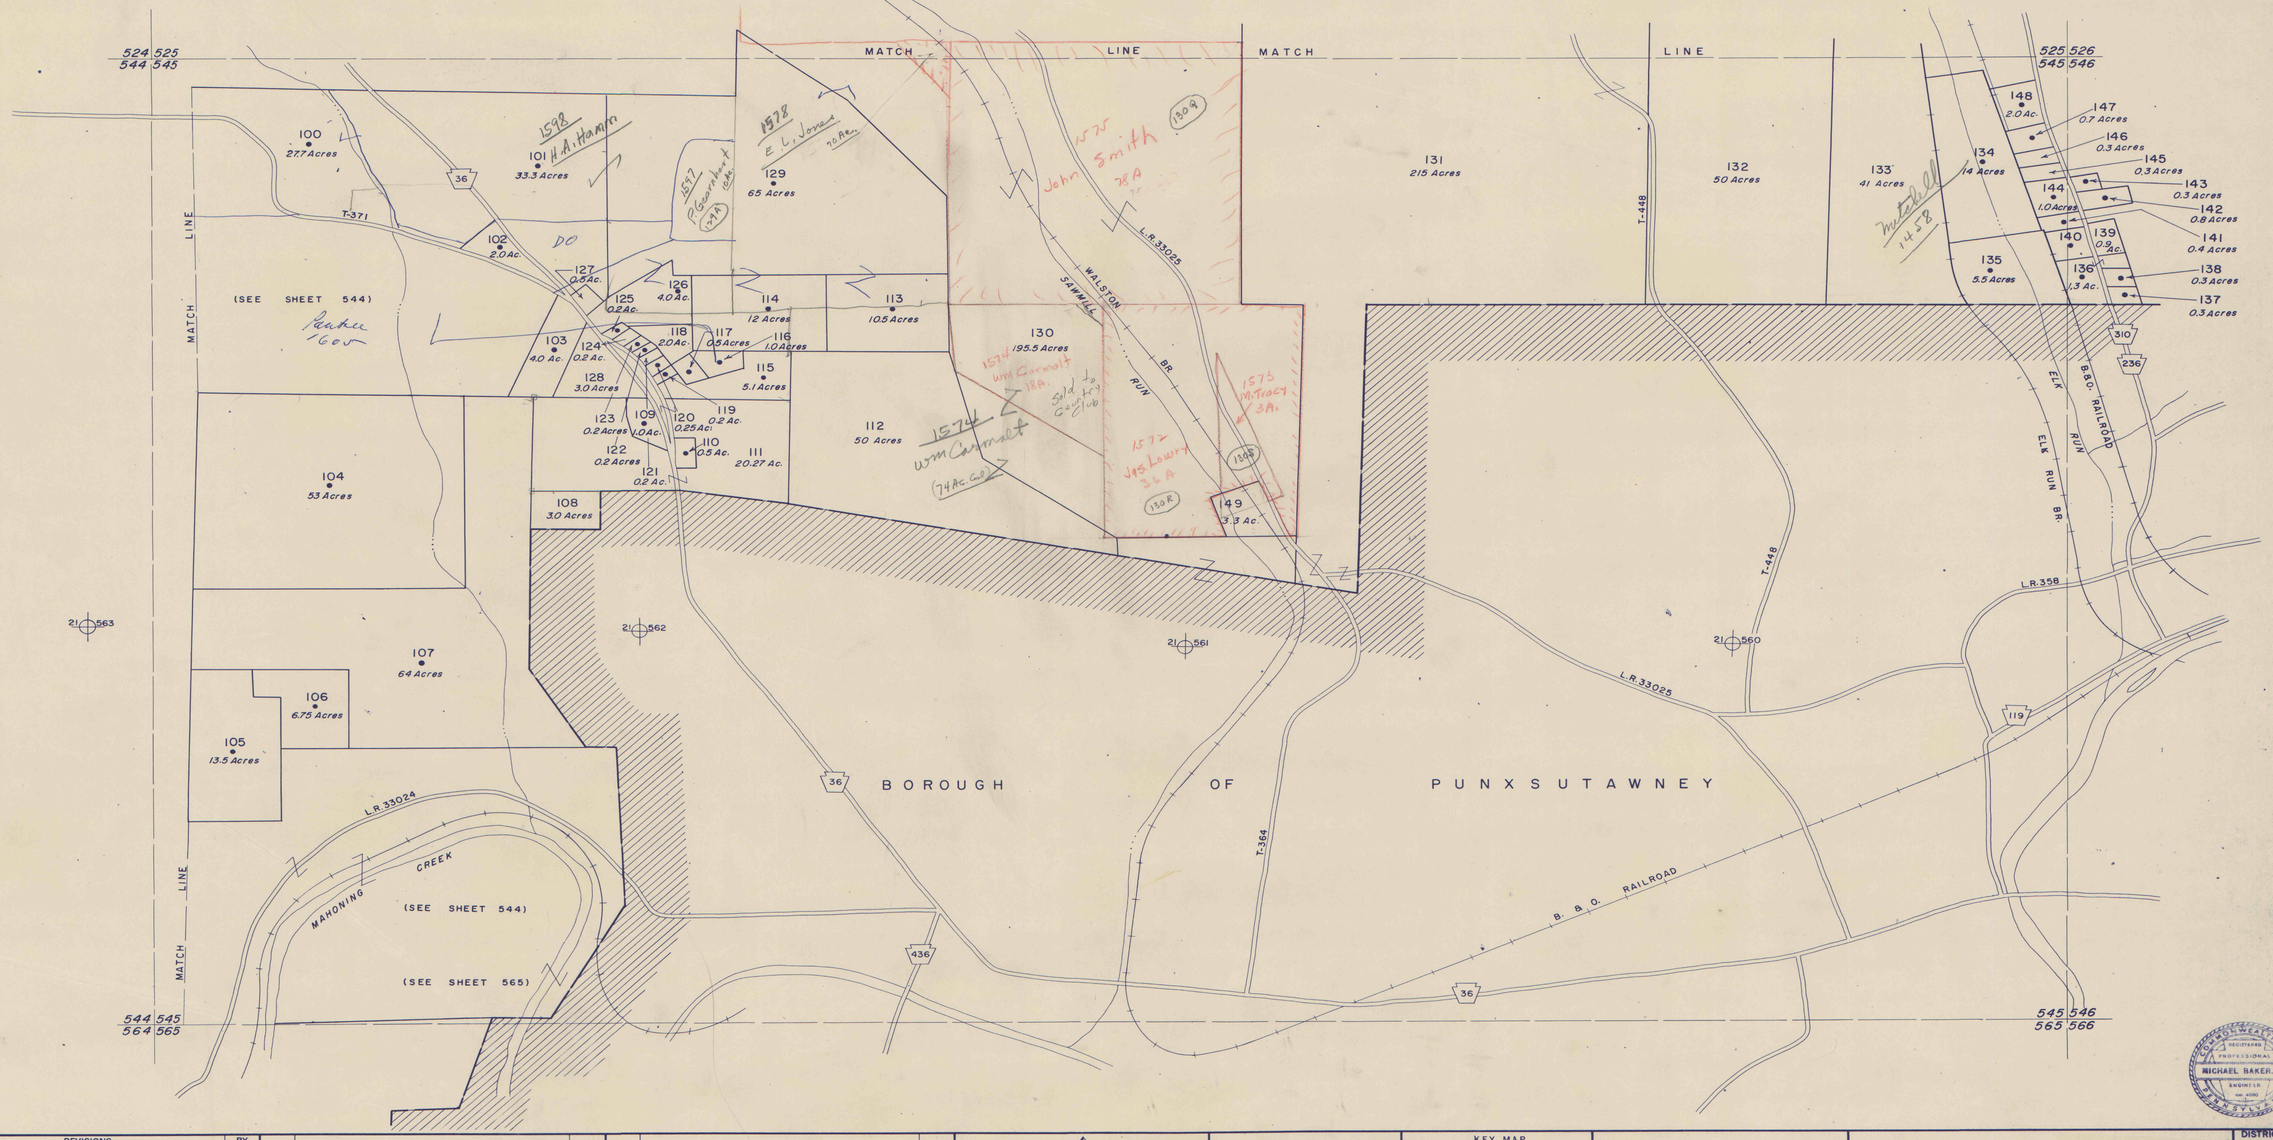

DATE	REVISIONS	BY

400 0 400 800
SCALE IN FEET

MICHAEL BAKER, JR., INC.
Consulting Engineers
ROCHESTER, PENNSYLVANIA

KEY MAP
525
544 545 546
565

JEFFERSON COUNTY
Pennsylvania
1957

YOUNG TOWNSHIP

10556-85

DISTRICT NO. 42

SHEET NO. 545