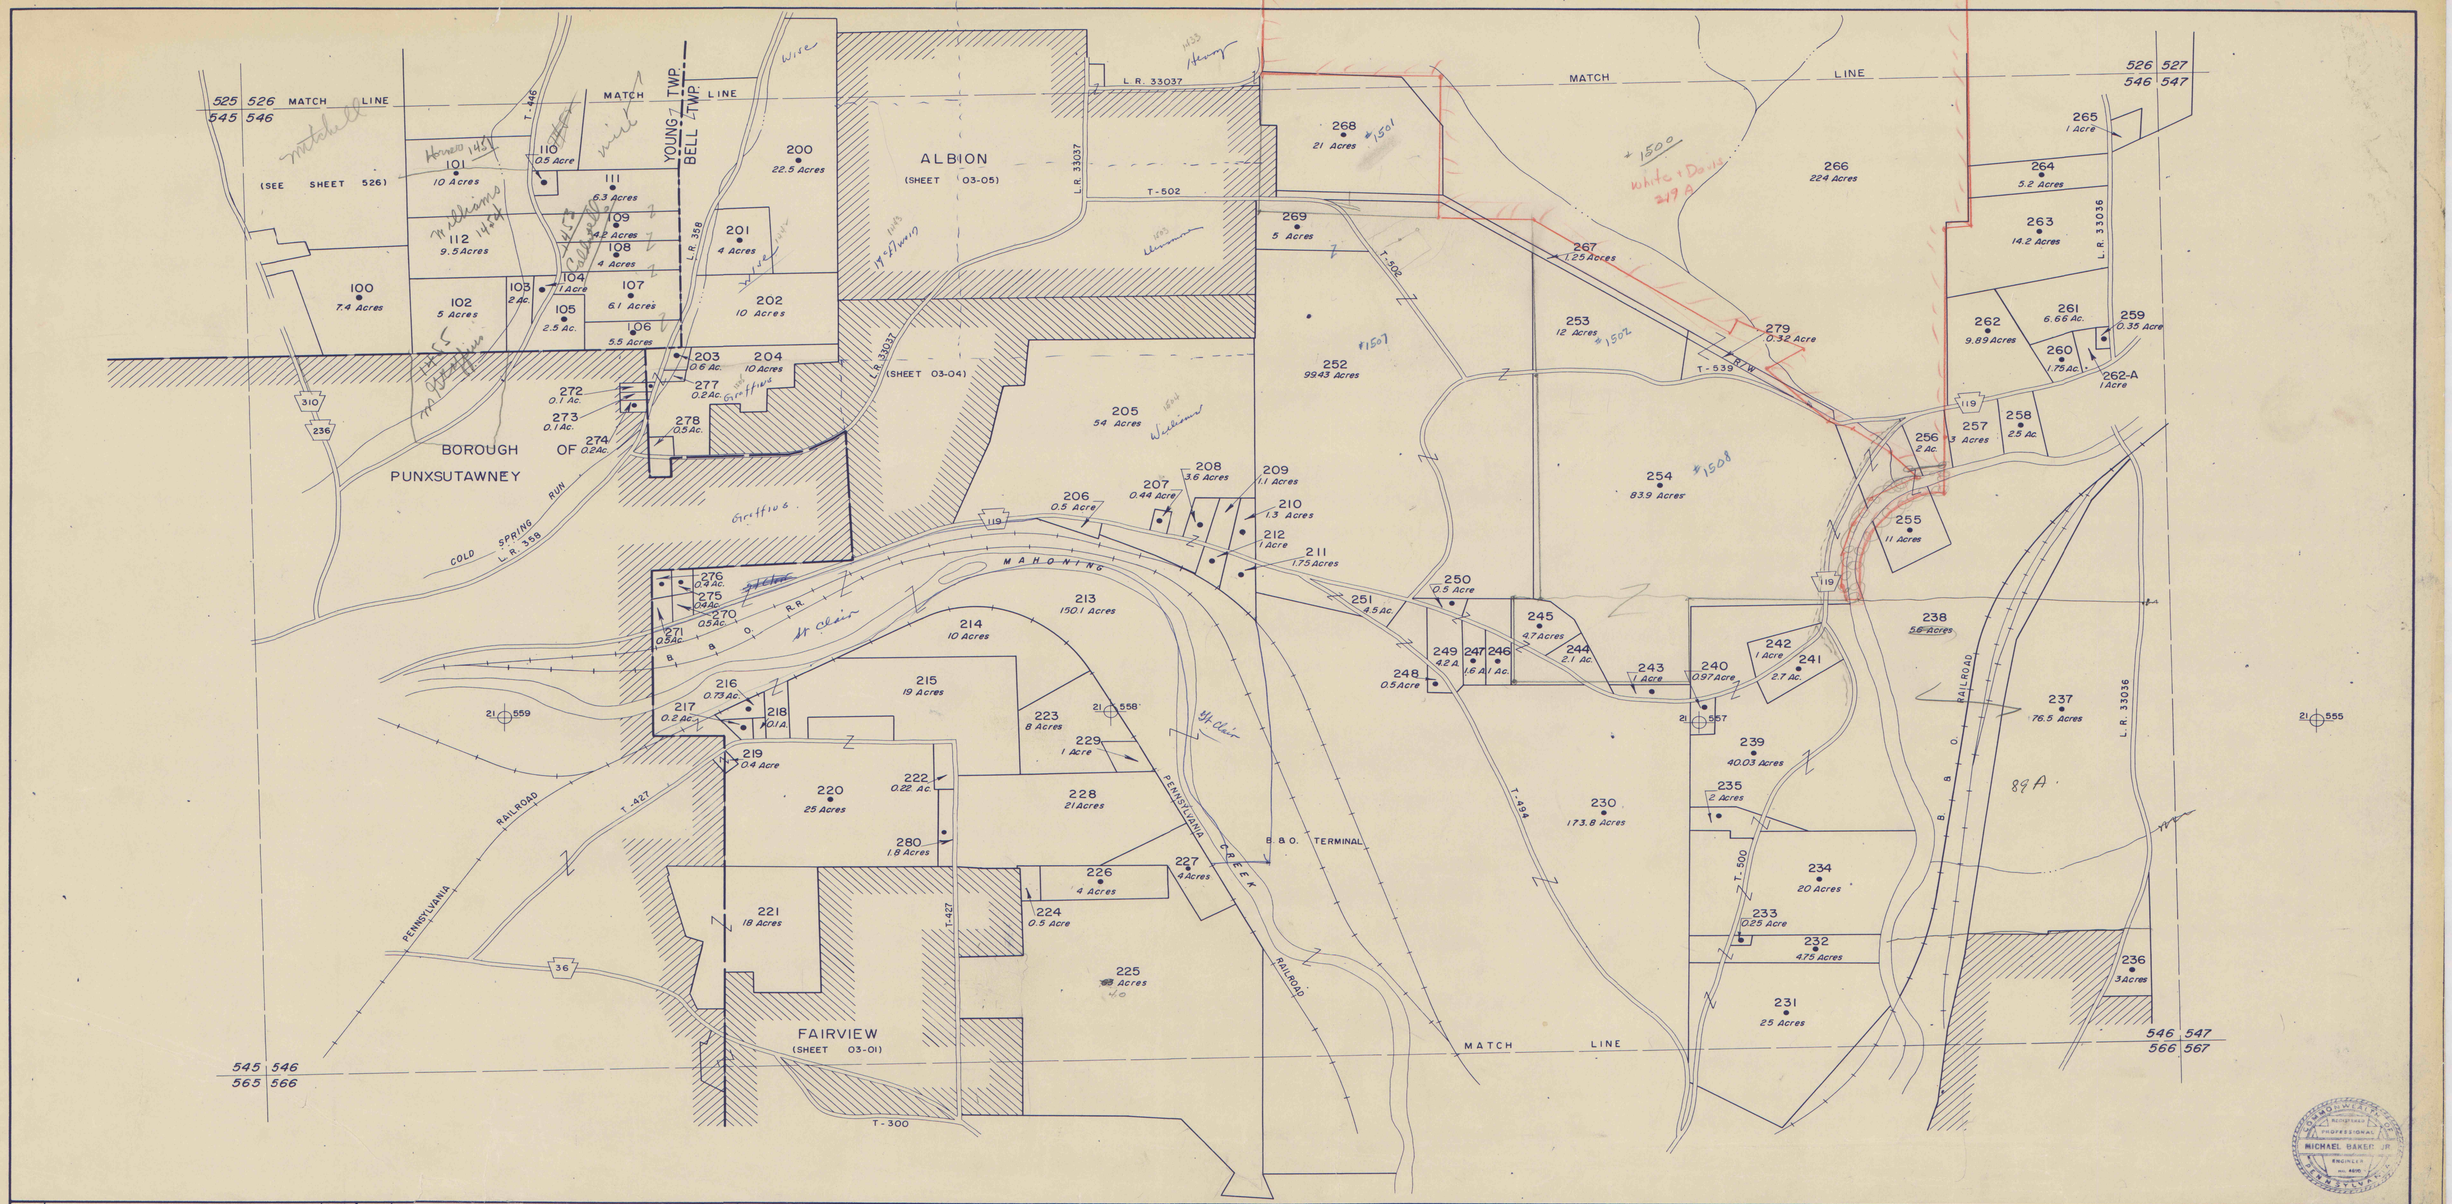

DATE	REVISIONS	BY

400 0 400 800
SCALE IN FEET

MICHAEL BAKER, JR., INC.
Consulting Engineers
ROCHESTER, PENNSYLVANIA

KEY MAP
526
545 546 547
566

JEFFERSON COUNTY
Pennsylvania
1957

YOUNG TOWNSHIP
BELL TOWNSHIP

DISTRICT NO. 42-03
SHEET NO. 546