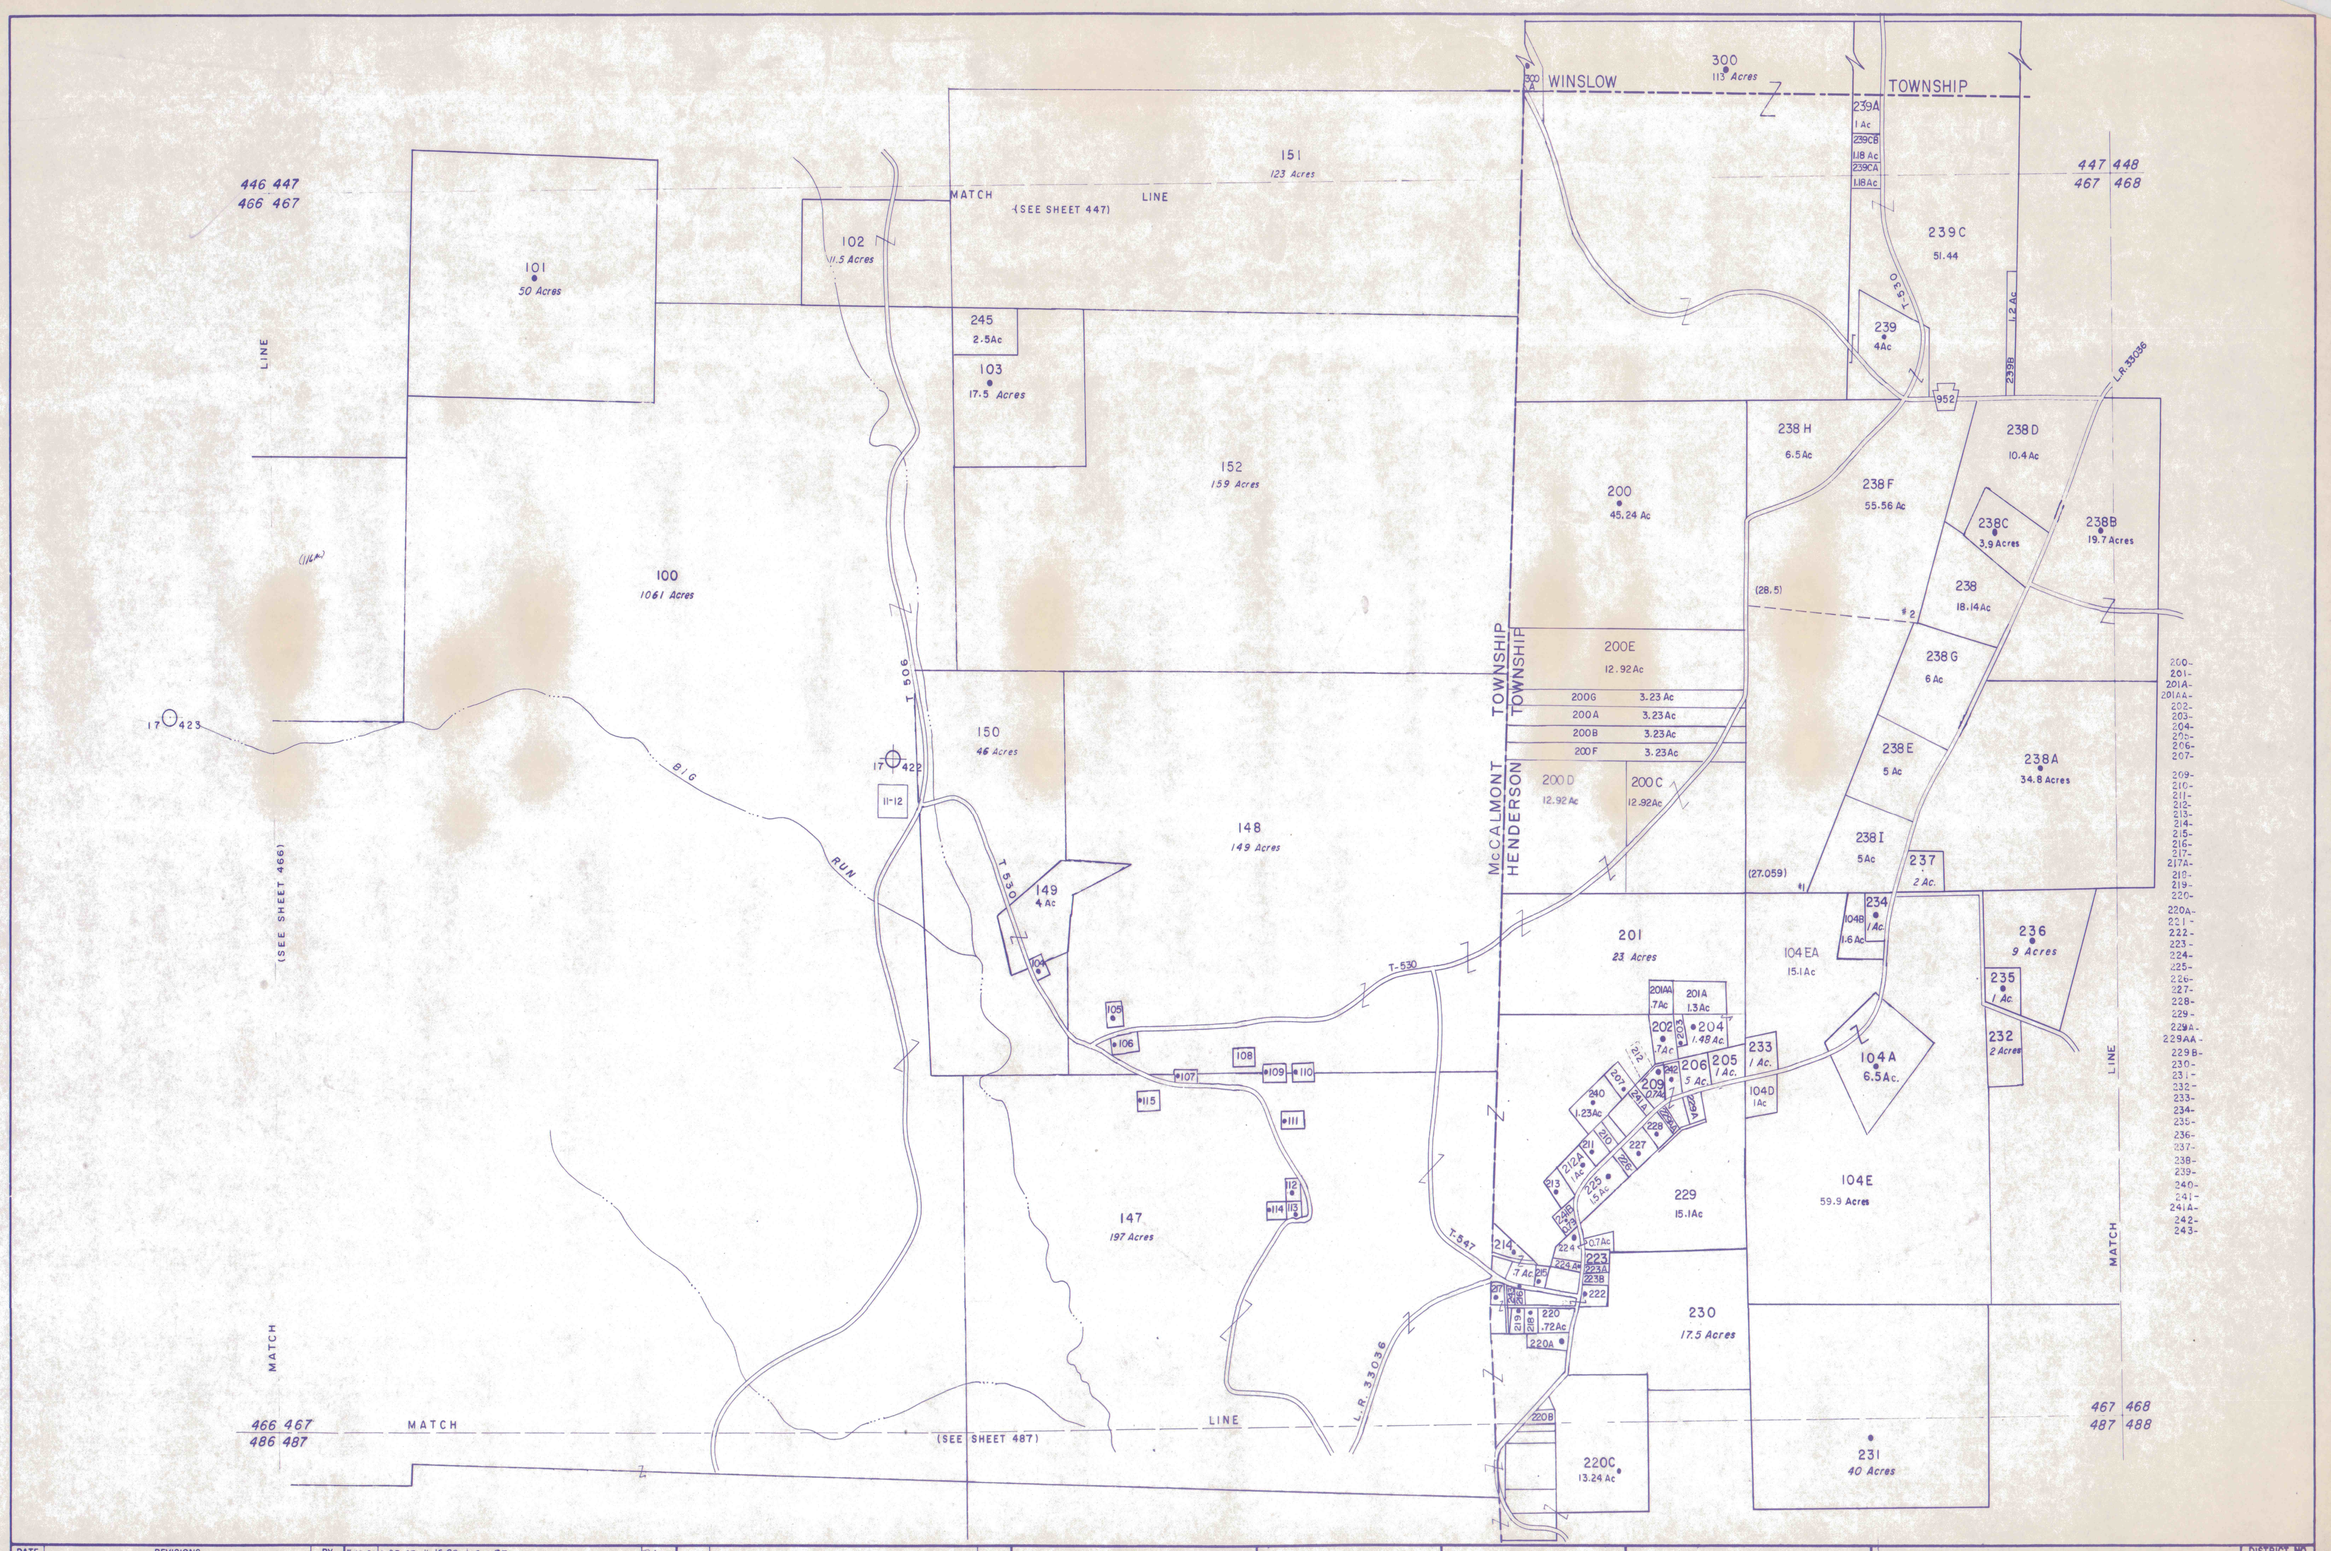

DATE	REVISIONS	BY
2-26-62		JE
12-12-75		WJS
2-1-77		GG
1-30-79		JS
4-23-81		RG
2-24-83		SCM

7-13-82 1-25-83 11-15-83 1-25-85 BJS

400 0 400 800
SCALE IN FEET

MICHAEL BAKER, JR., INC.
Consulting Engineers
ROCHESTER, PENNSYLVANIA

KEY MAP

	447	
466	467	468
	487	

JEFFERSON COUNTY
Pennsylvania
1957

McCALMONT TOWNSHIP
HENDERSON TOWNSHIP
WINSLOW TOWNSHIP

DISTRICT NO. 15 13 40

SHEET NO. 467