


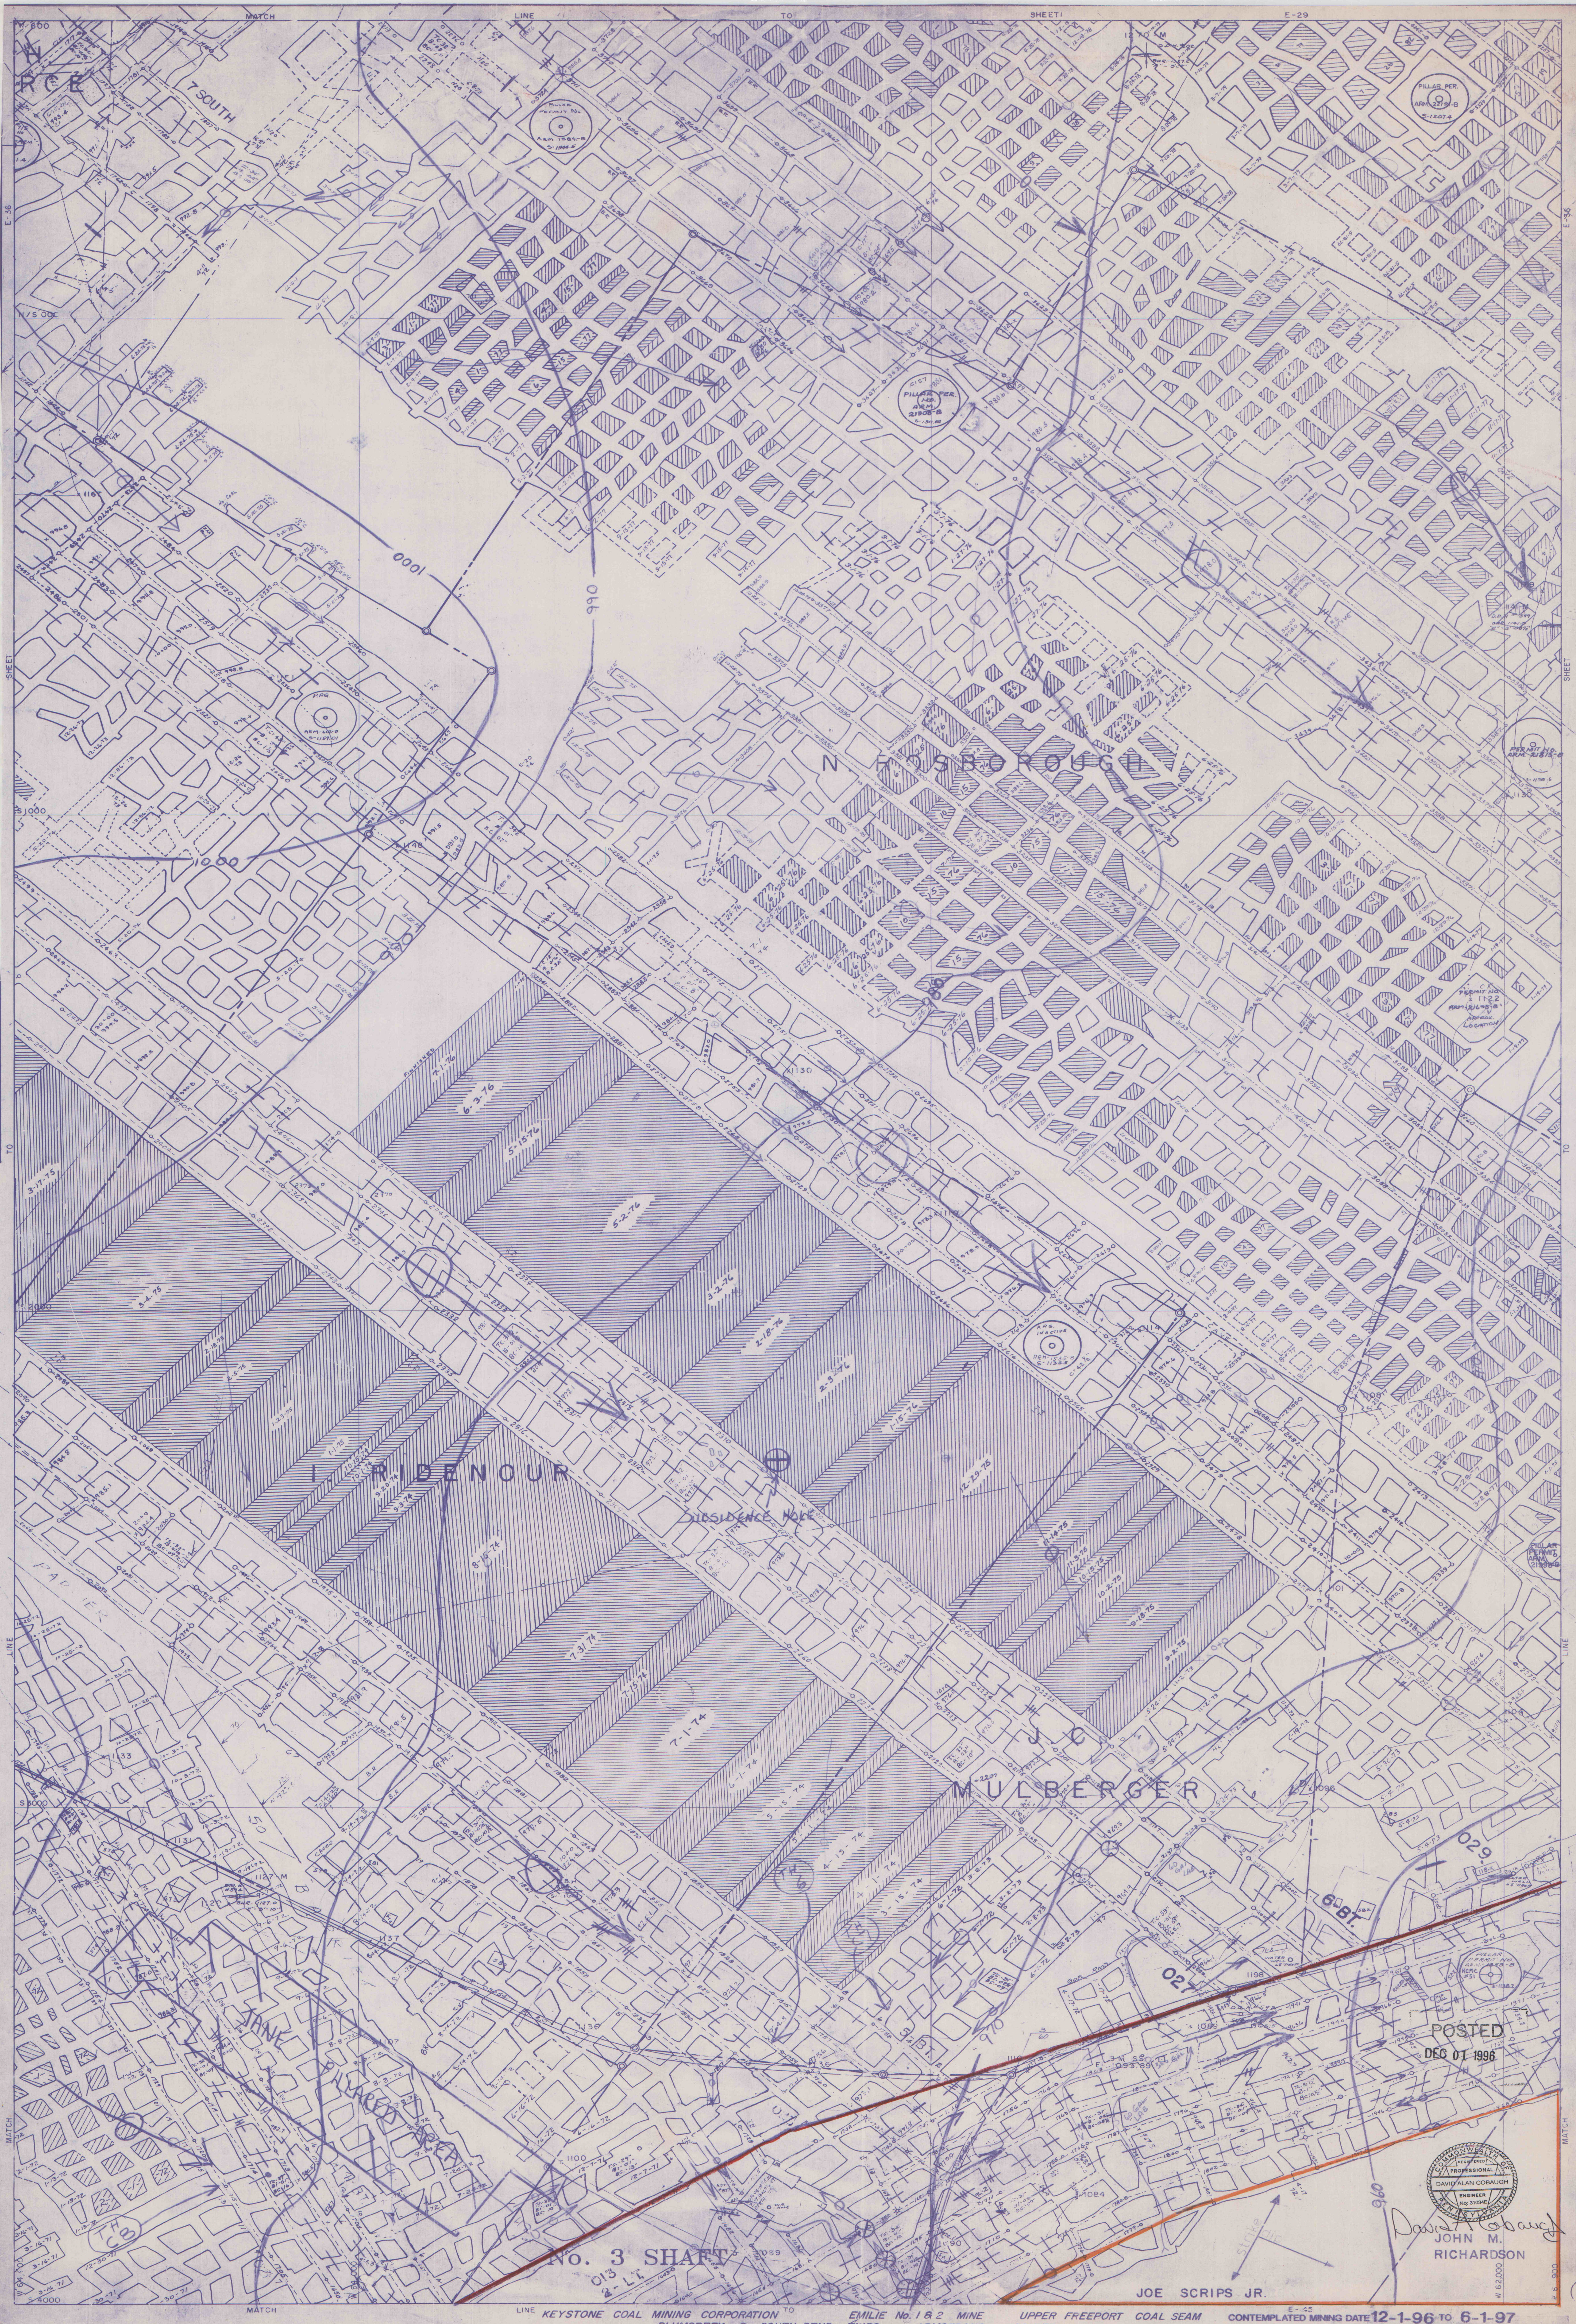

POSTED
DEC 01 1996



JOHN M.
RICHARDSON

JOE SCRIPS JR.

KEYSTONE COAL MINING CORPORATION
EMILIE No. 1 & 2 MINE
PLUMCREEK & SOUTH BEND TWP.
ARMSTRONG COUNTY
UPPER FREEPORT COAL SEAM
CONTEMPLATED MINING DATE 12-1-96 TO 6-1-97

Scale: 1"=100'