




KEYSTONE COAL MINING CORPORATION
PLUMCREEK & SOUTH BEND TOWNSHIPS
EMILIE NO. 1 & 2 MINE
ARMSTRONG COUNTY
UPPER FREEPORT COAL SEAM

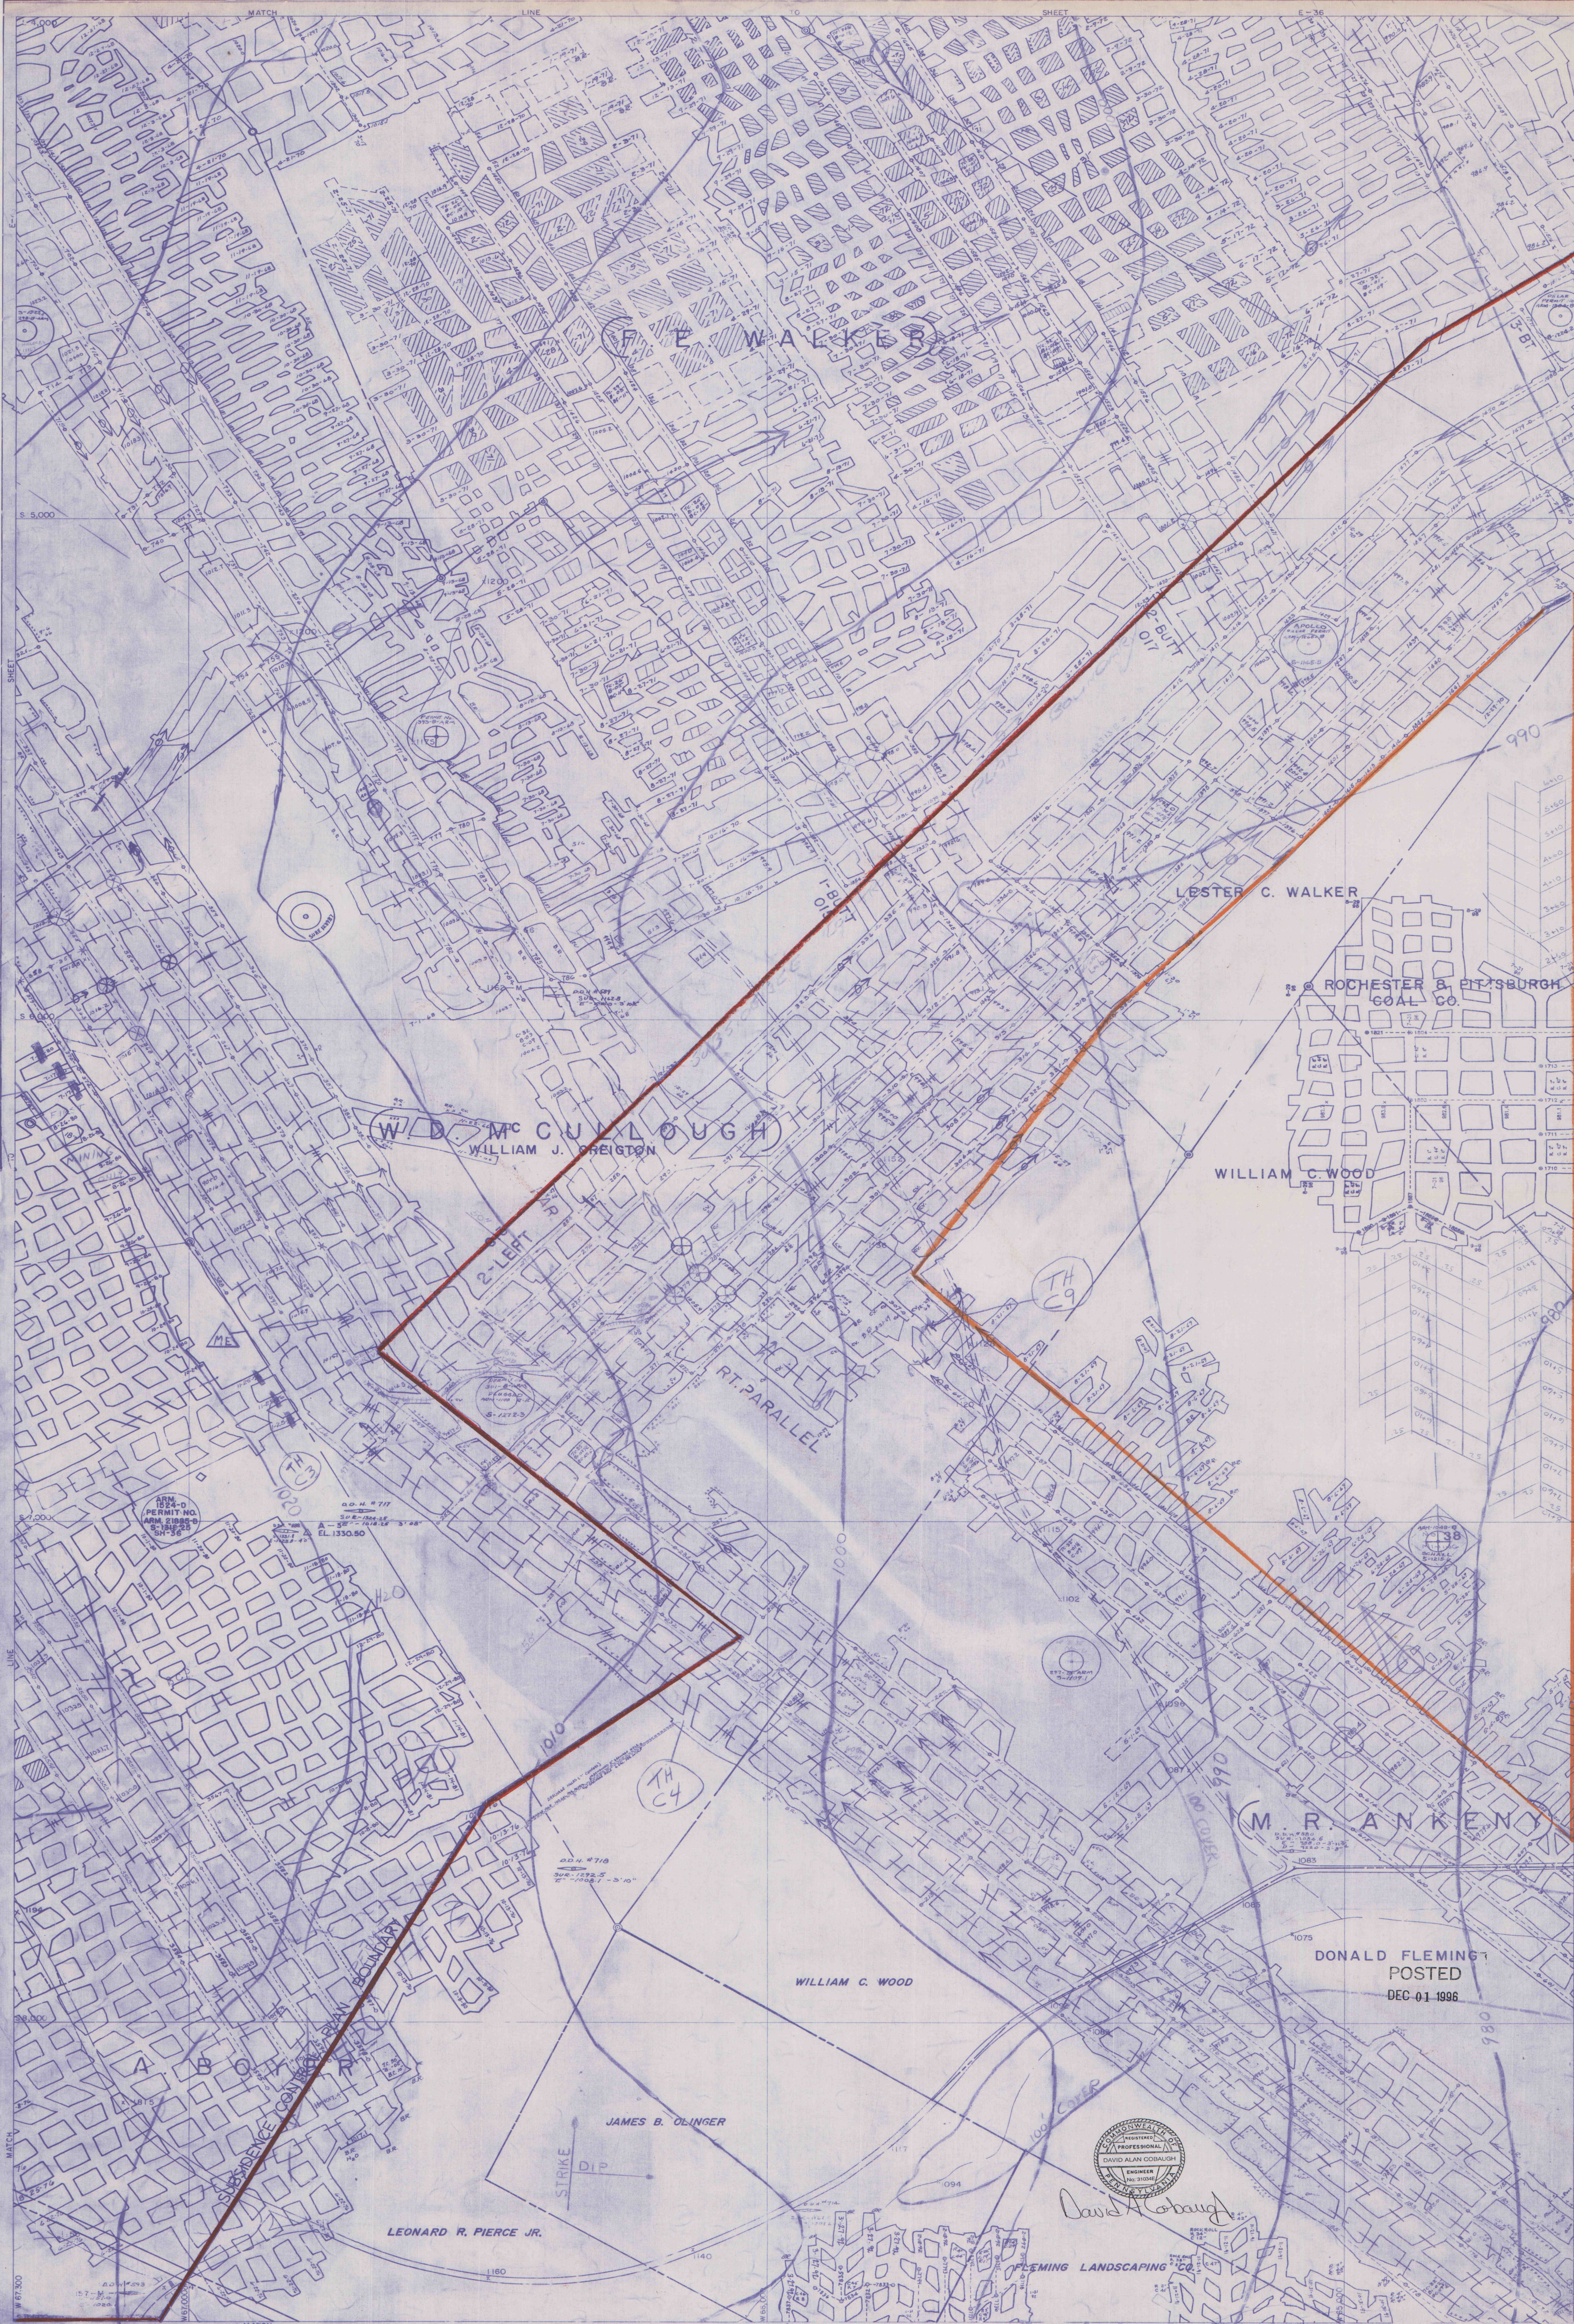

David A. Cobough

FLEMING LANDSCAPING CO.

DONALD FLEMING
POSTED
DEC 01 1996

CONTEMPLATED MINING FROM 12-1-96 TO 6-1-97

1"=100' scale