


Tremont West (F) - new B-B'

Outcrop to be checked with map - cross + and check around outcrop rough, and hand mechanical drawing

Only the colored areas to be included in underground maps, but to understand published sections - do published section

Tremont West (F) - new B-B' 1:25,000
map to be reduced to 1:25,000
New 1:25,000
can be reduced to 1:48,000 (2) more on at 1:36,000 more probably

Tremont West (F) - new B-B' 1:25,000

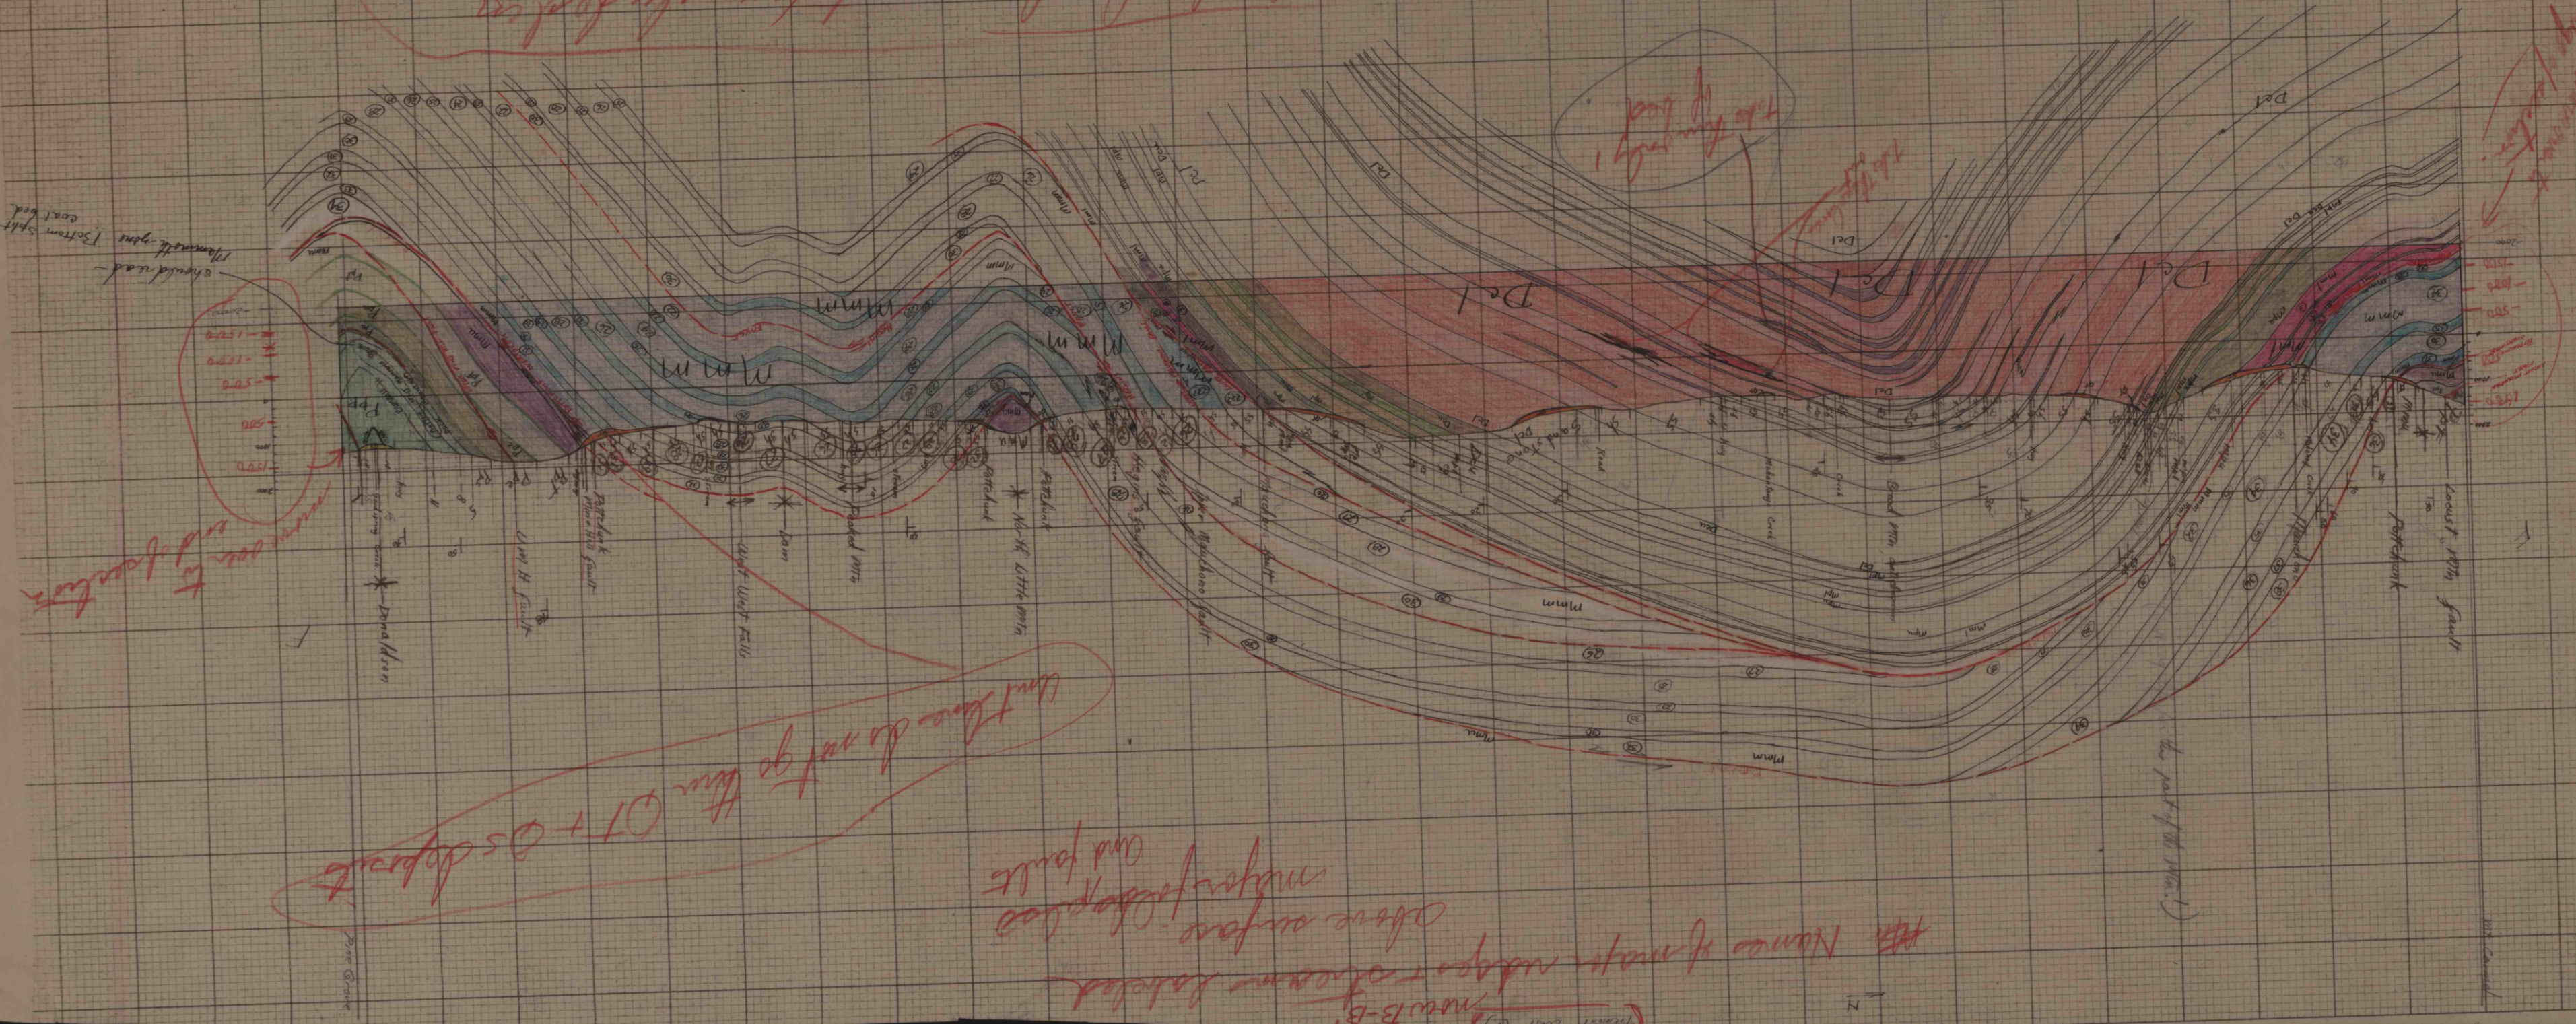

Don't have to not go thru DT + CS deposits

new B-B' above surface of map adapt stream labeled and fault