


Valley View east

Valley View east

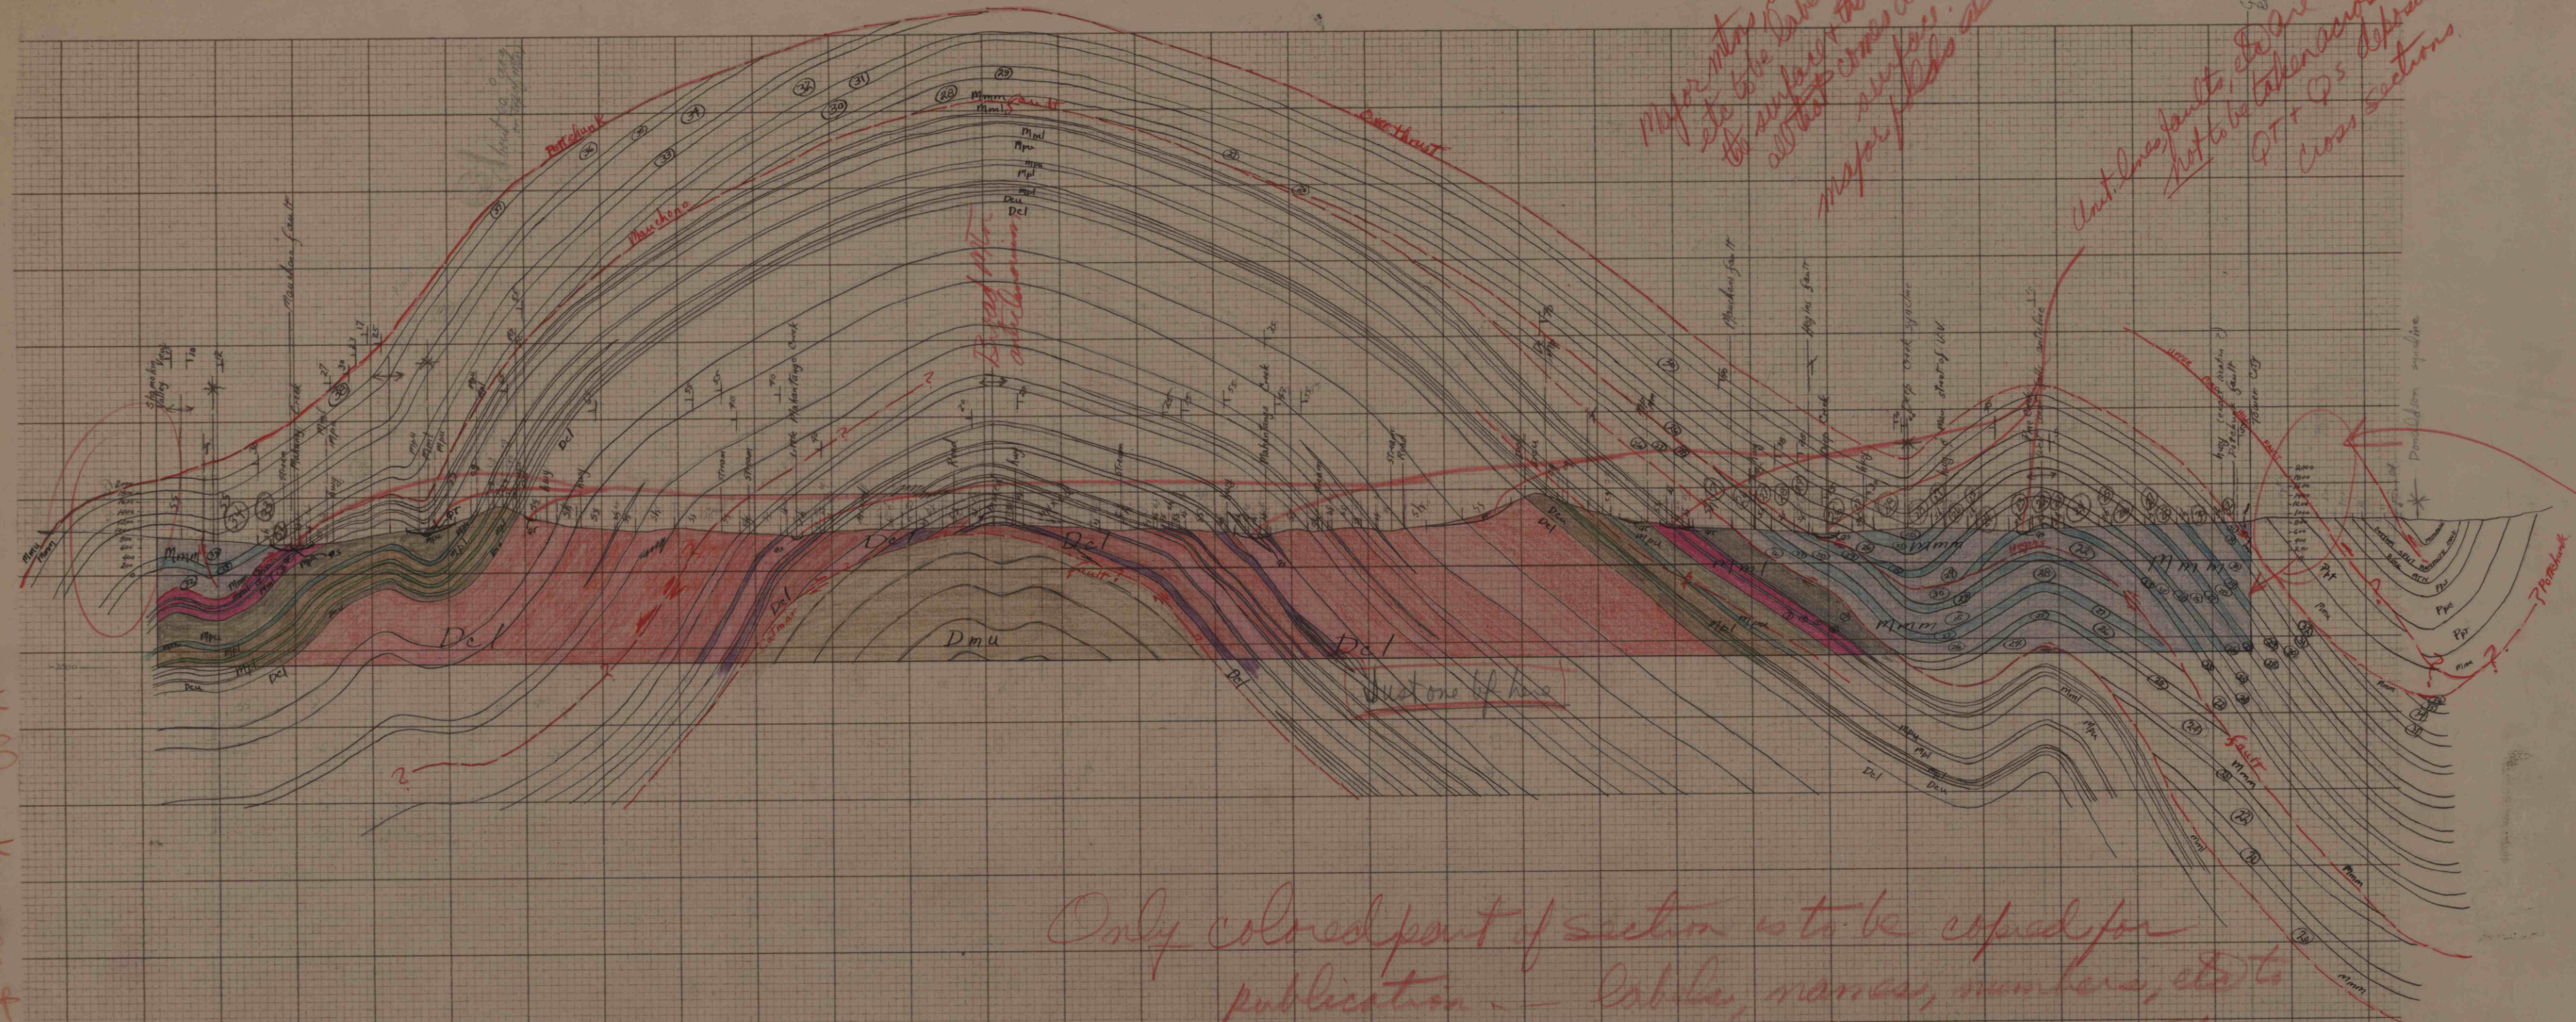

Major river streams, etc. to be labeled above the surface that is to be all that crosses above the major faults also

Ant. line faults, etc. are not to be taken across the QT + P's dip into on cross sections.

0, 500, 1000, 1500, 2000 ± elev at both ends of section

Valley View east

Only colored part of section is to be copied for publication. - Labels, names, numbers, etc. to be condensed into that area - Smooth out lines, unit thicknesses, etc. from my field hand drawing. Outcrops must be checked against surface map.

Scale 1:20,000 - probable publication scale
1:36,000 or possibly, 1:28,000
Publication scale of map 1:28,000

(Valley View east)

A-A'