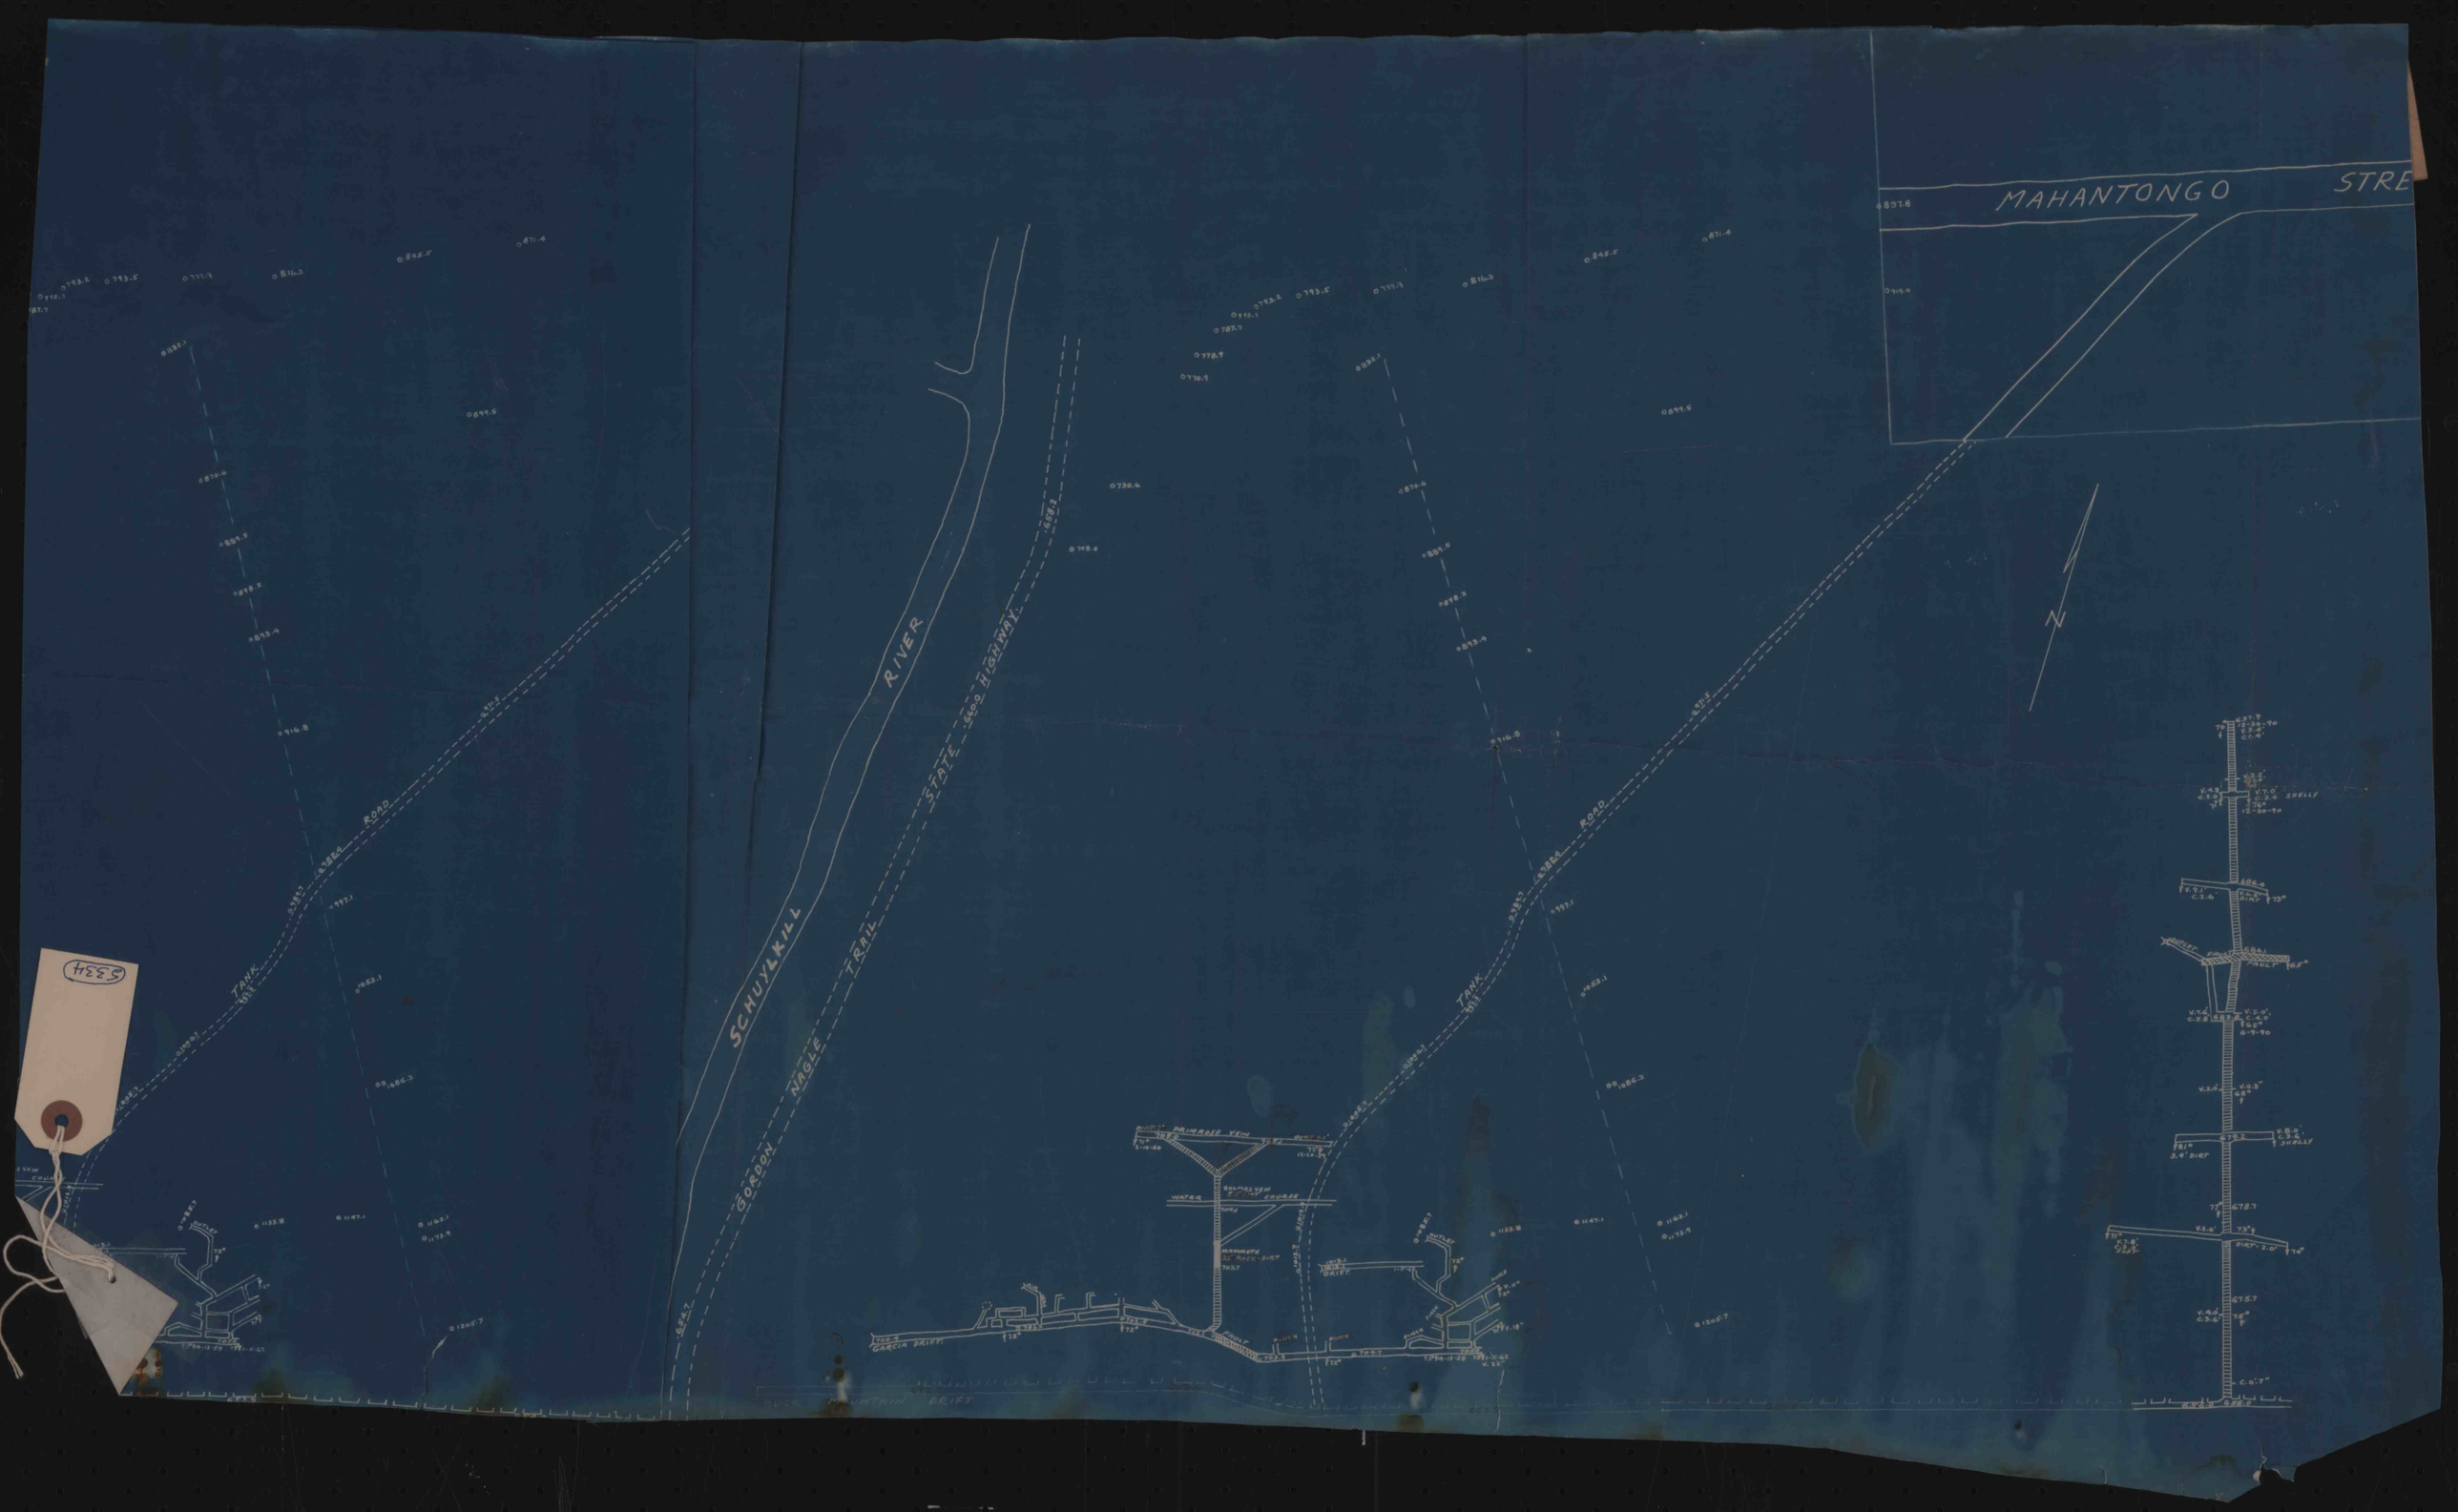
MAHANTONGO
STRE
SCHUYLKILL
RIVER
GORDON
NAGLE
TRAIL
STATE
HIGHWAY
ROAD
TANK
PRIMROSE VEIN
WATER
HOLMES VEIN
MAHANOY
GARCIA DRIFT
N