


T H O M A S W I L D B A H N T R A C T

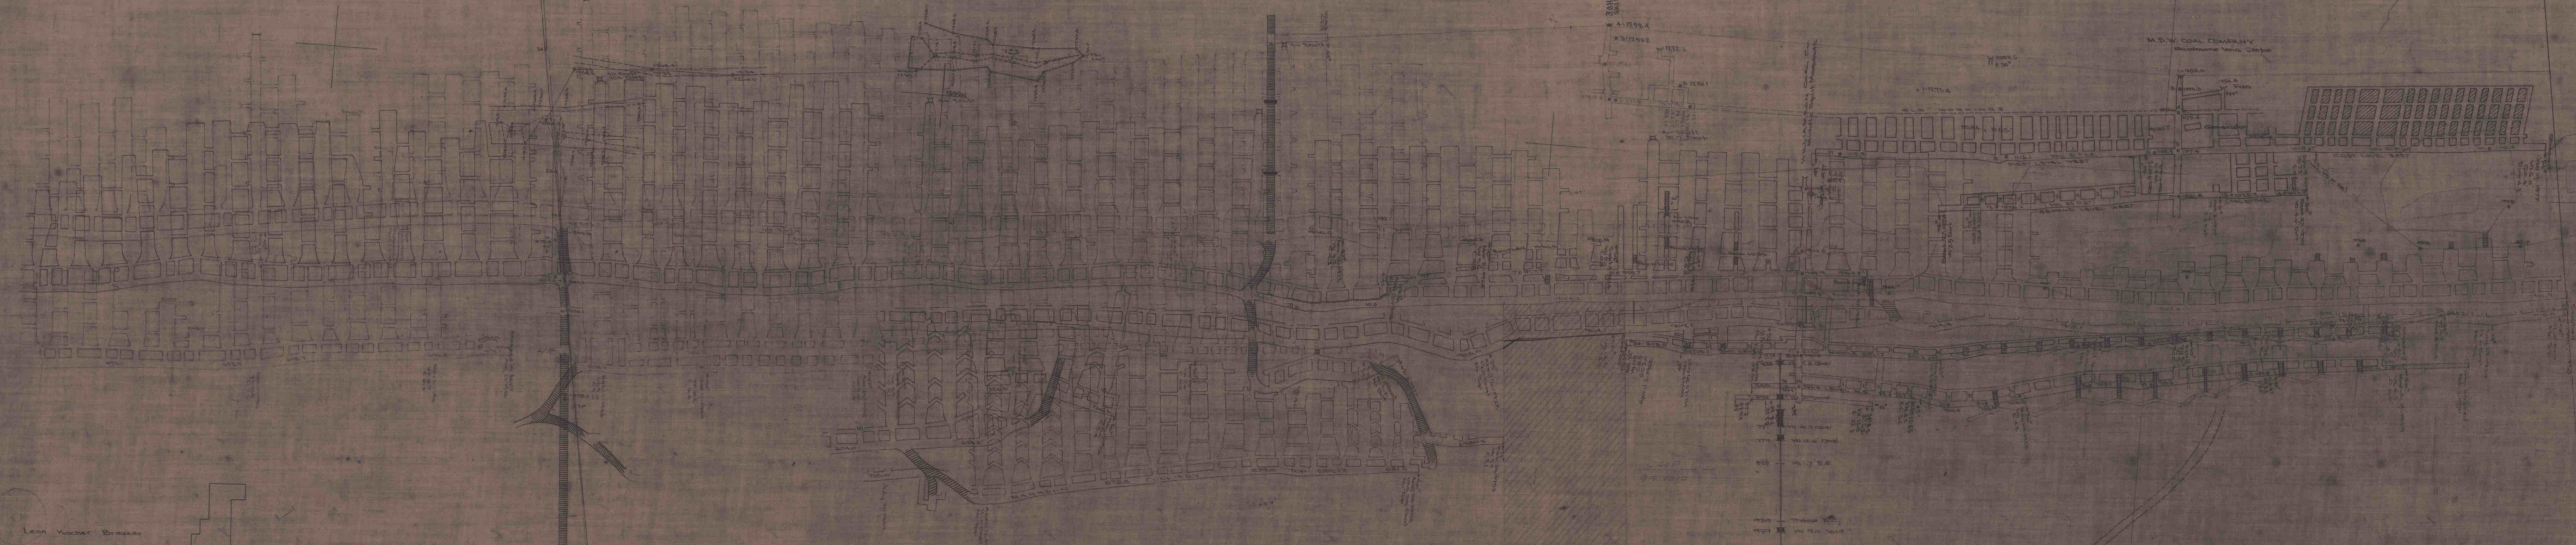

C O A L M I N E S I N C
H E G I N S T O W N S H I P
C O R T E R T O W N S H I P