


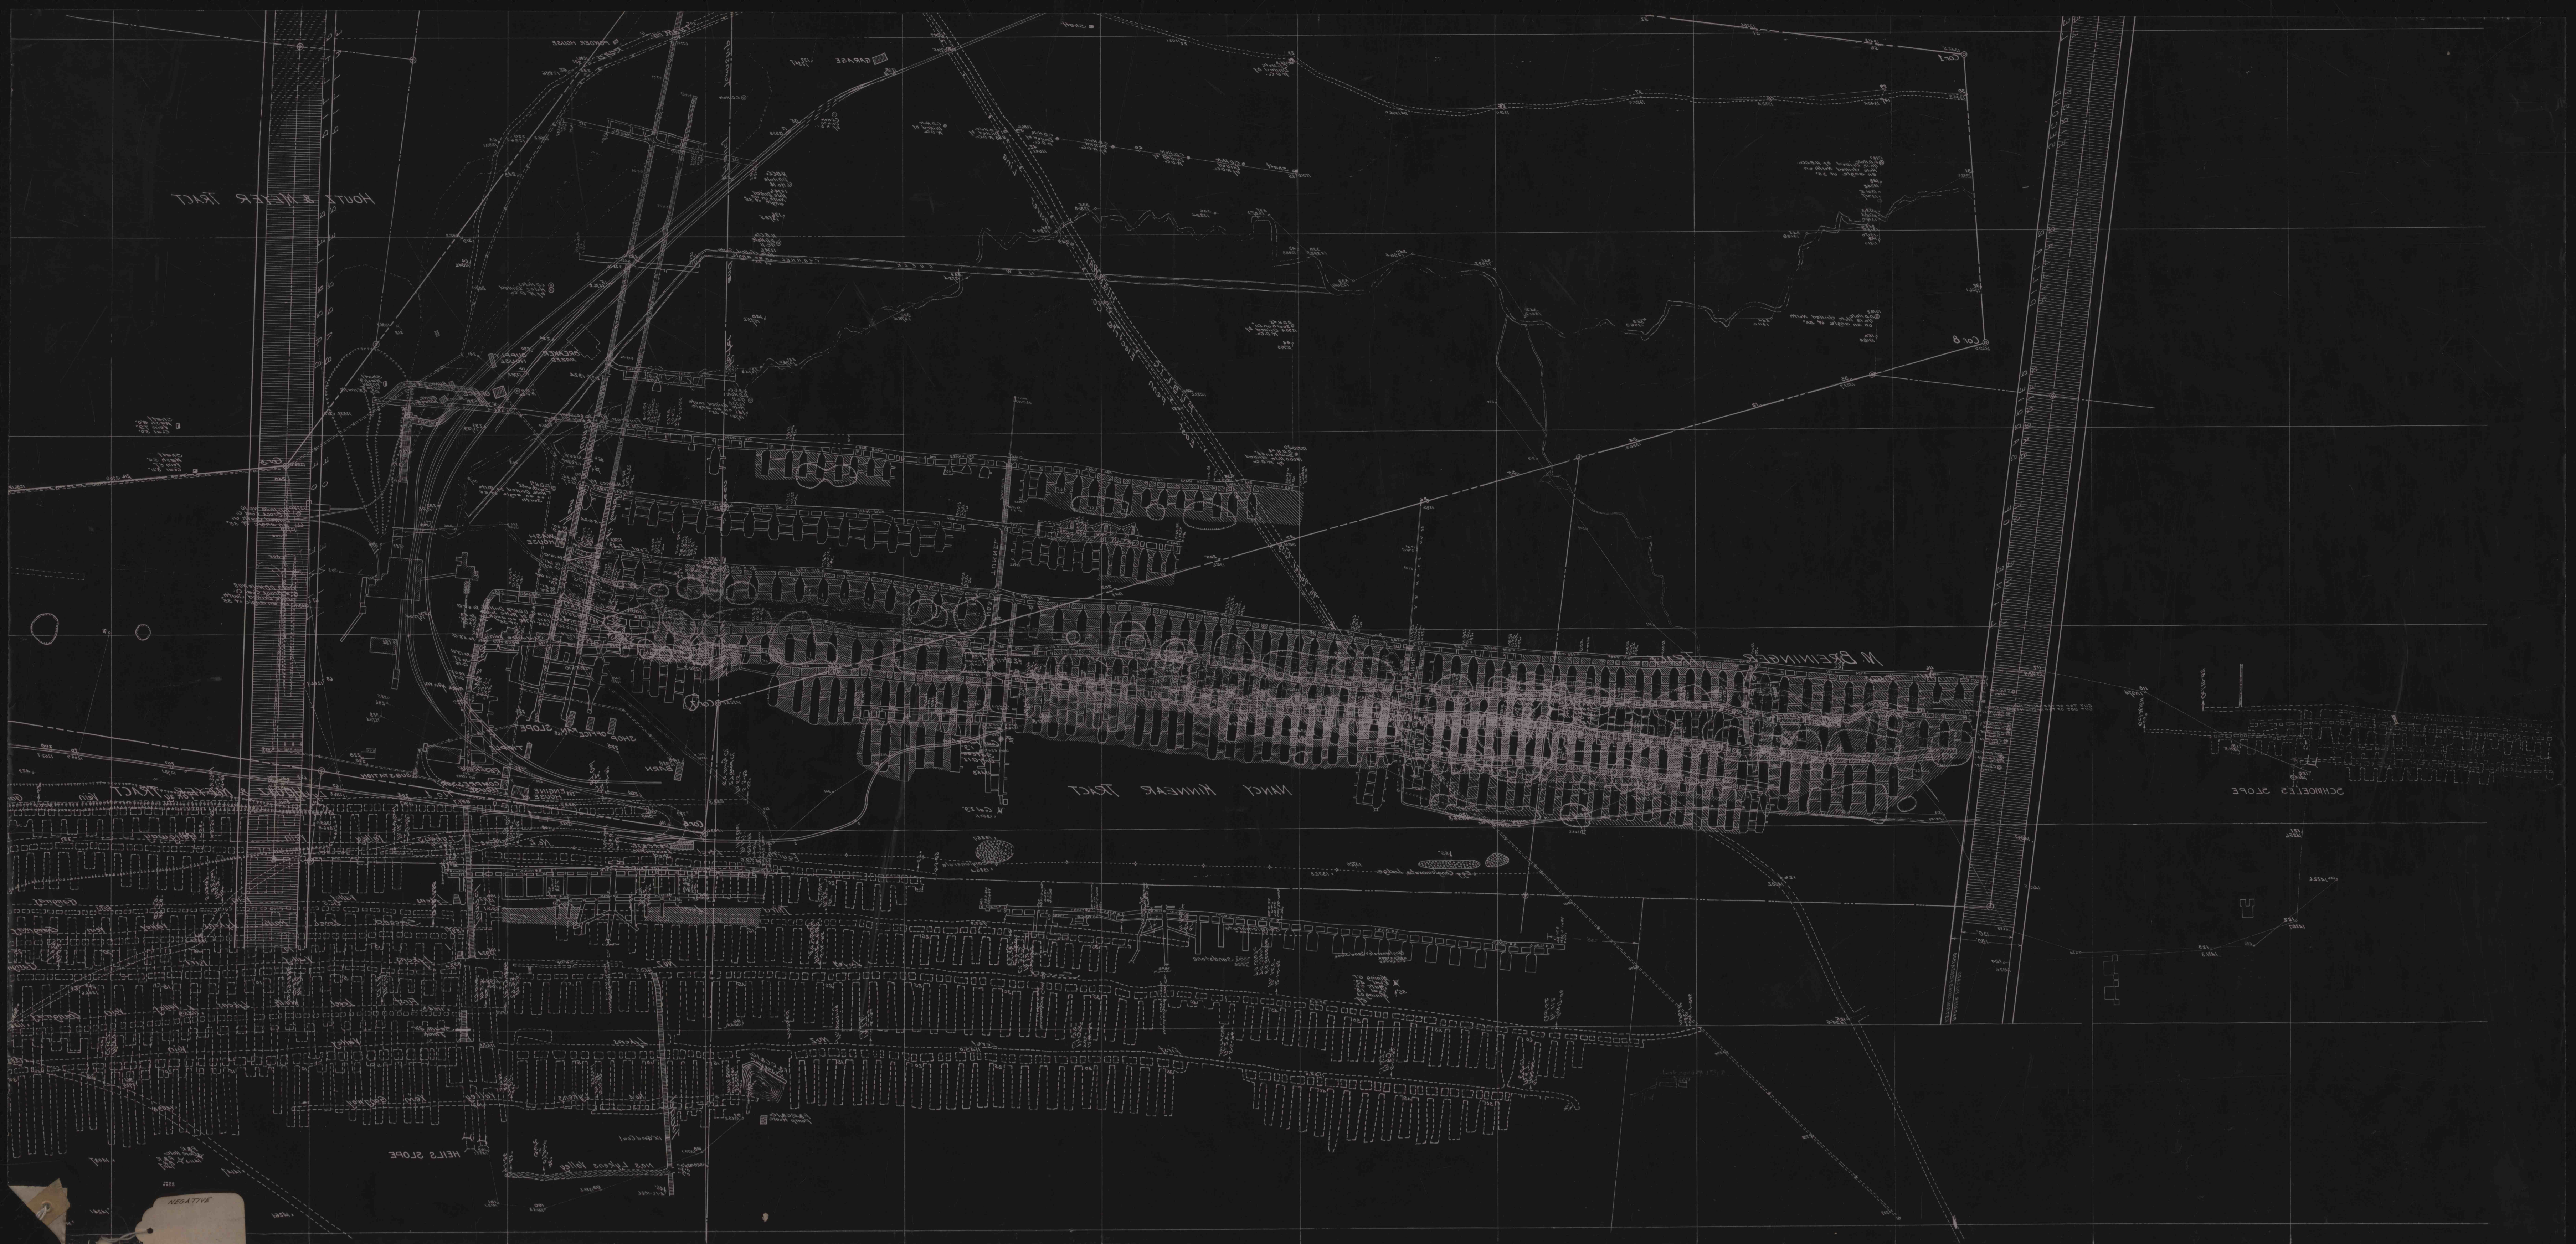






NEGATIVE

SCALE 1"=200'

(530)