
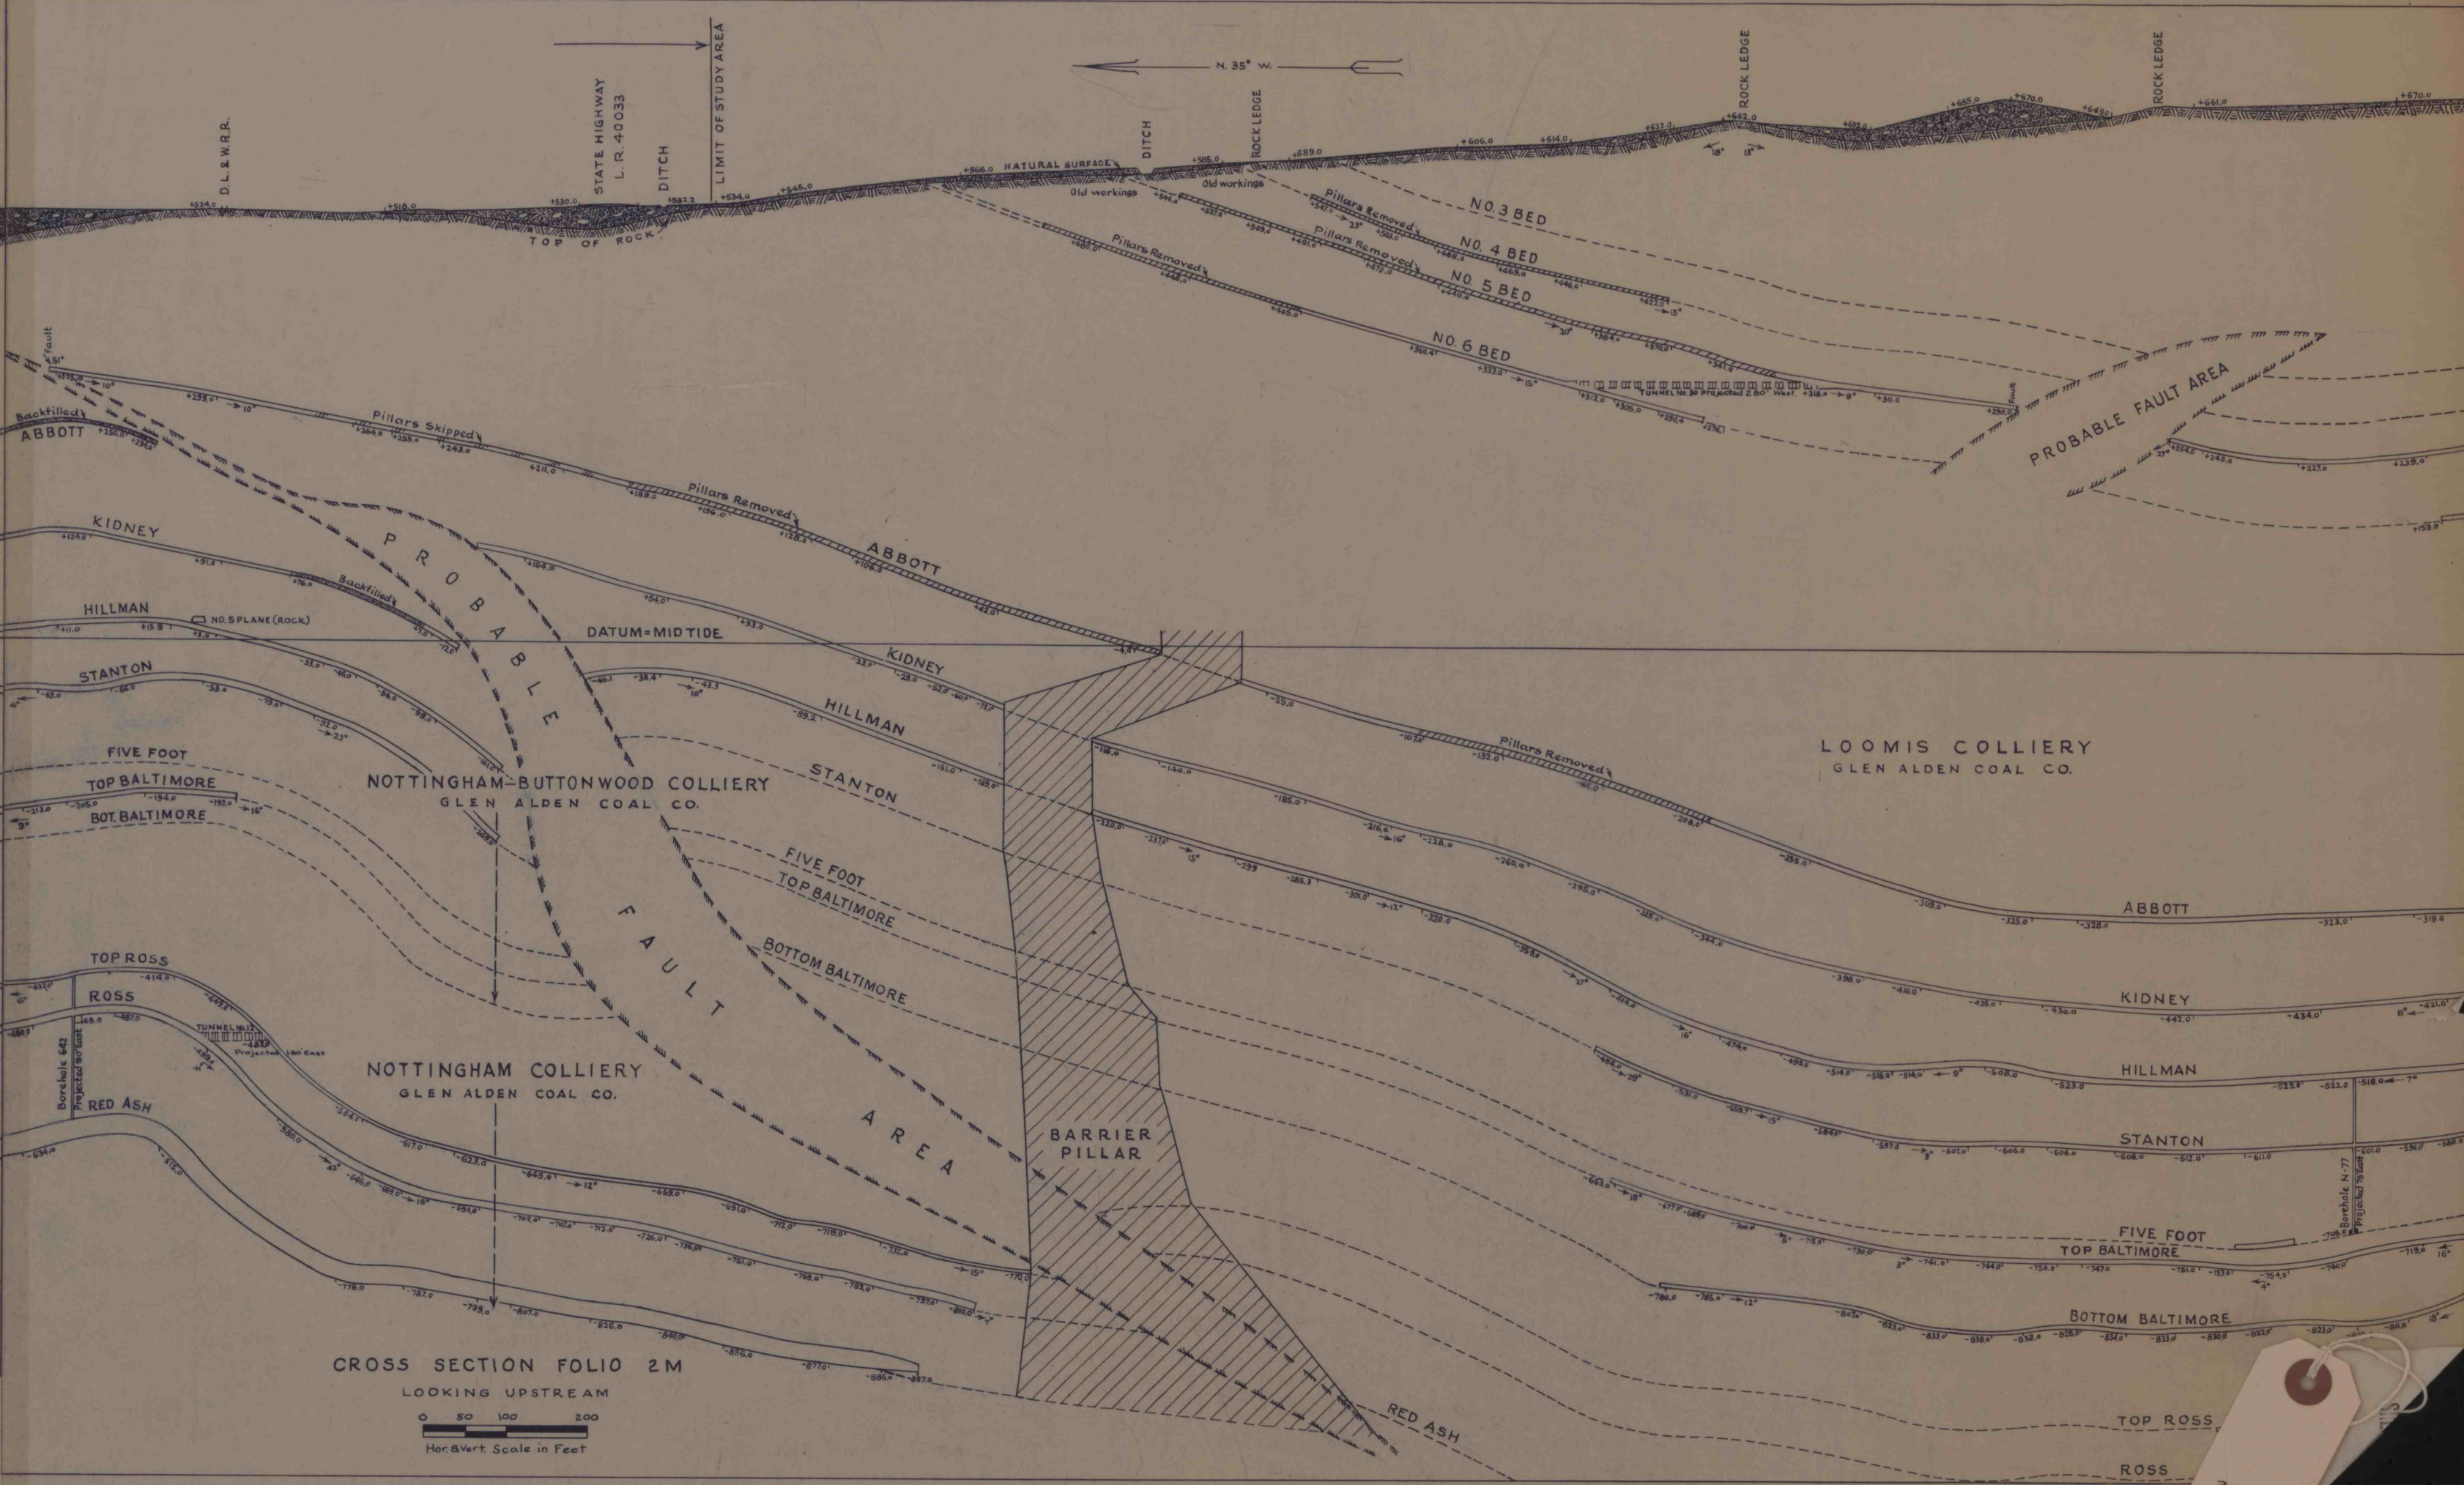


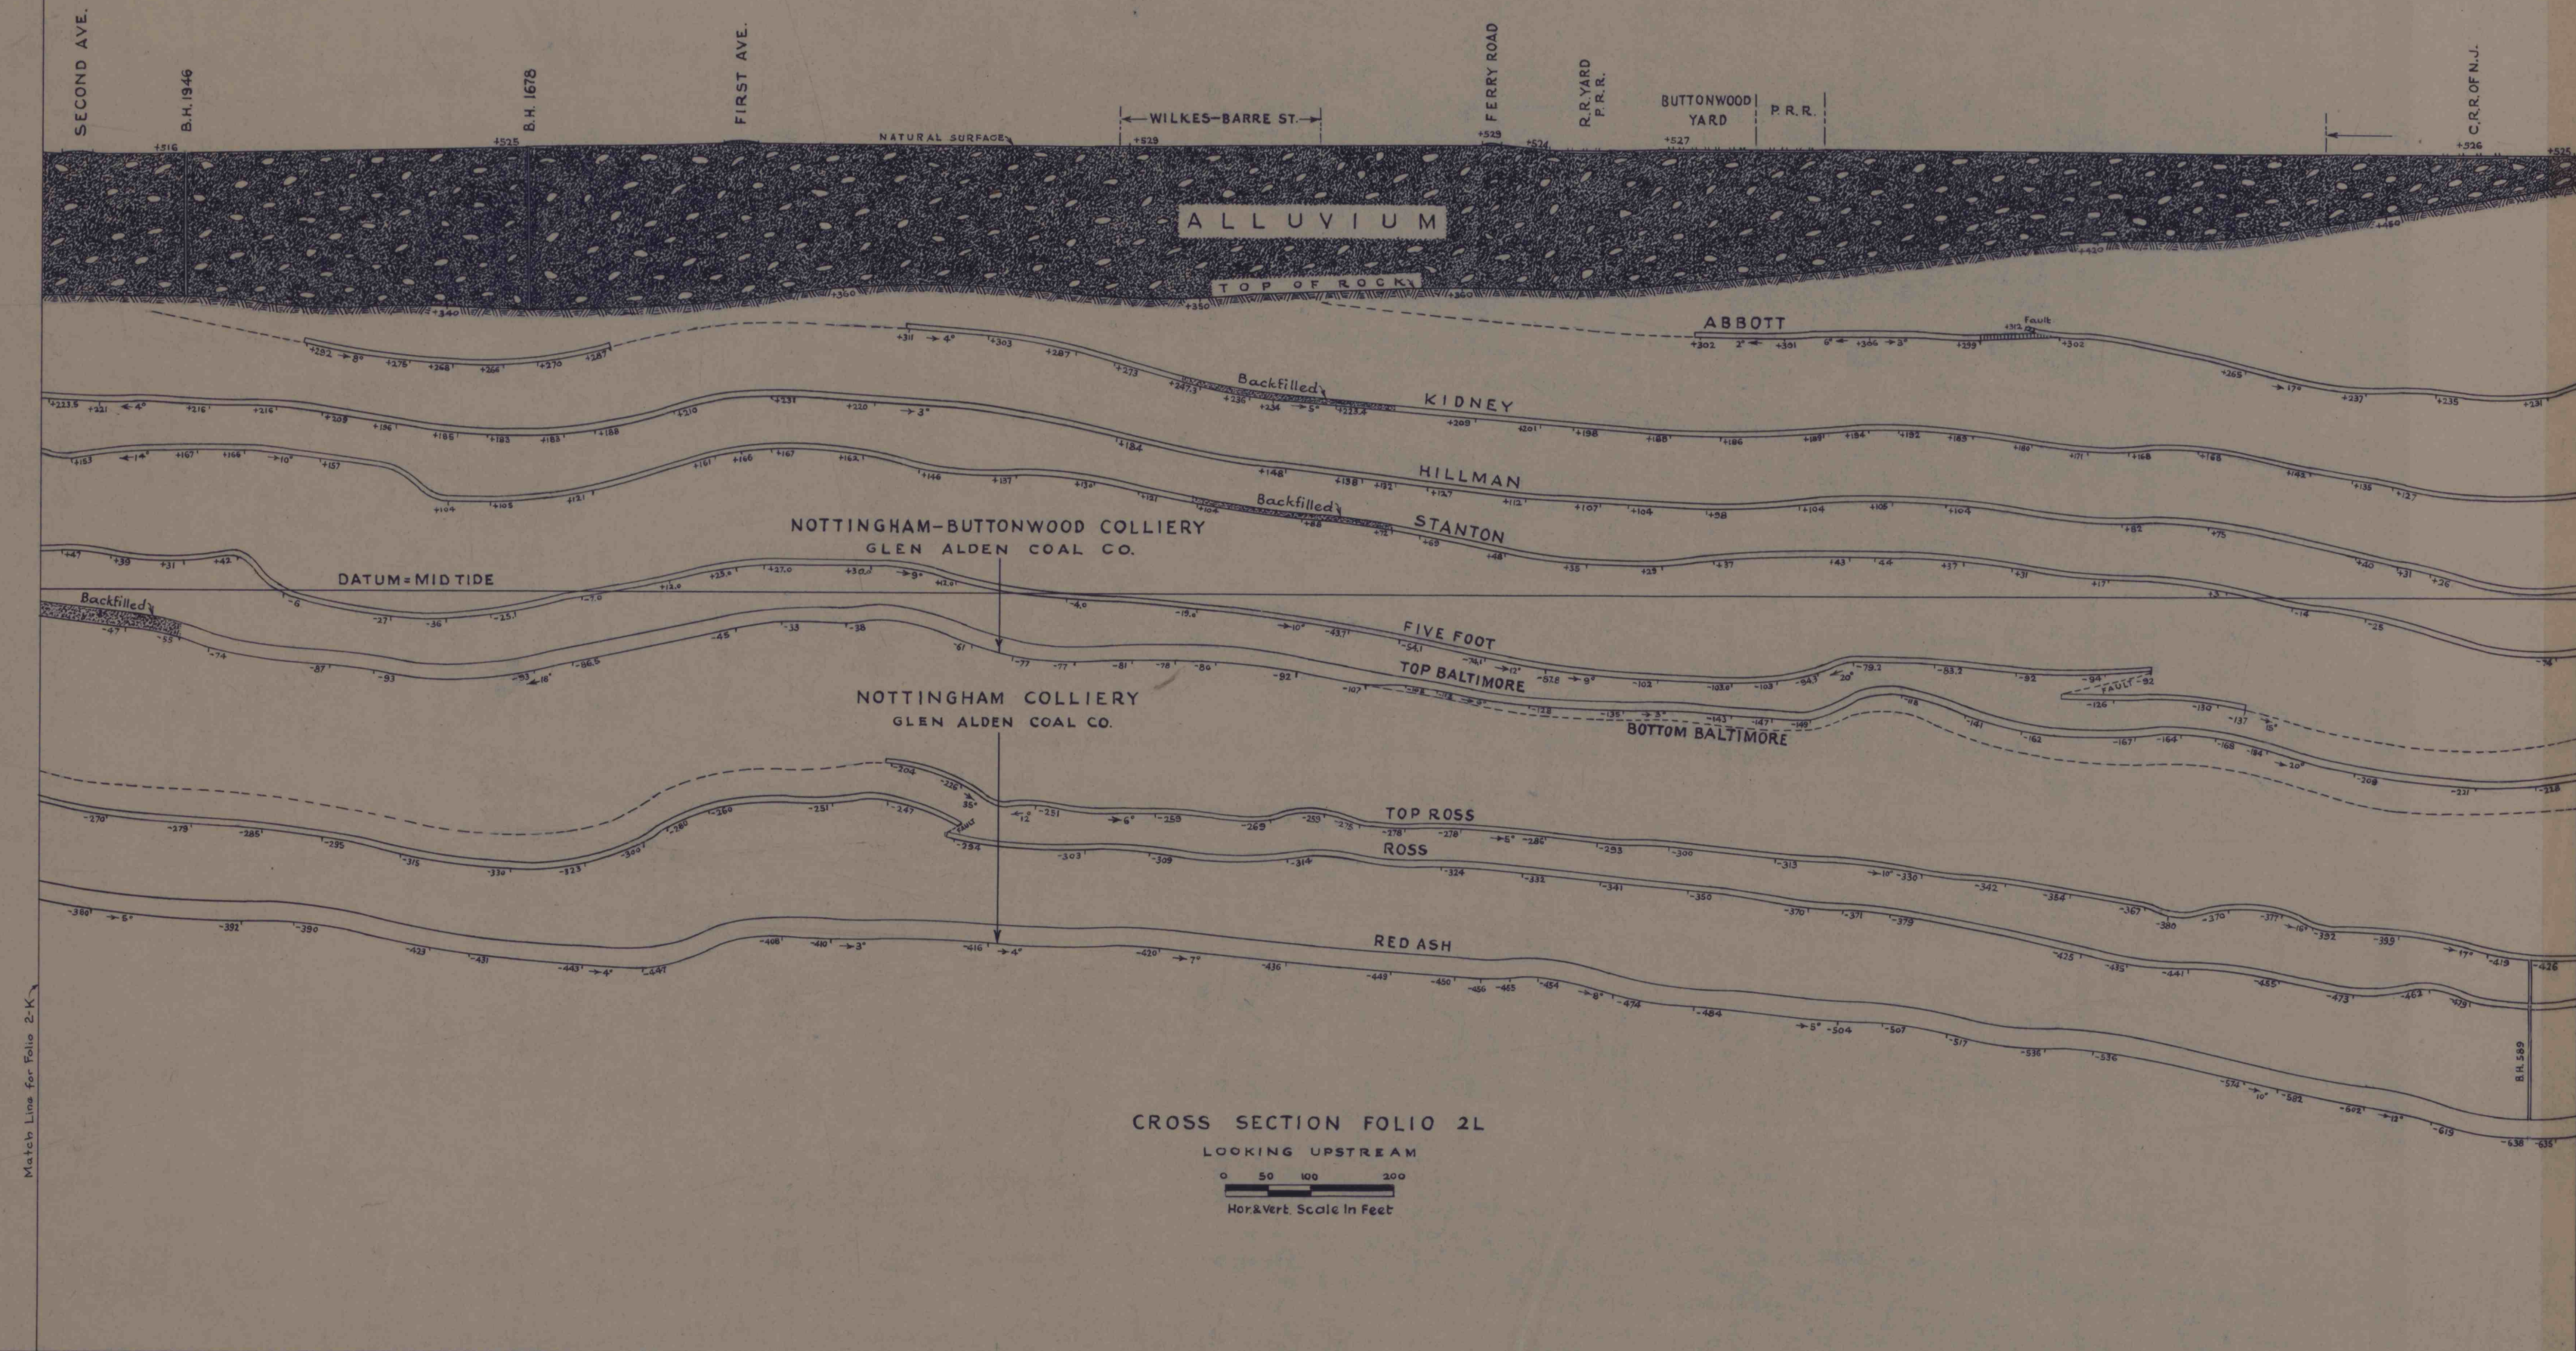

CROSS SECTION FOLIO 2M

37 MIN
5322
A. H. H. 100