



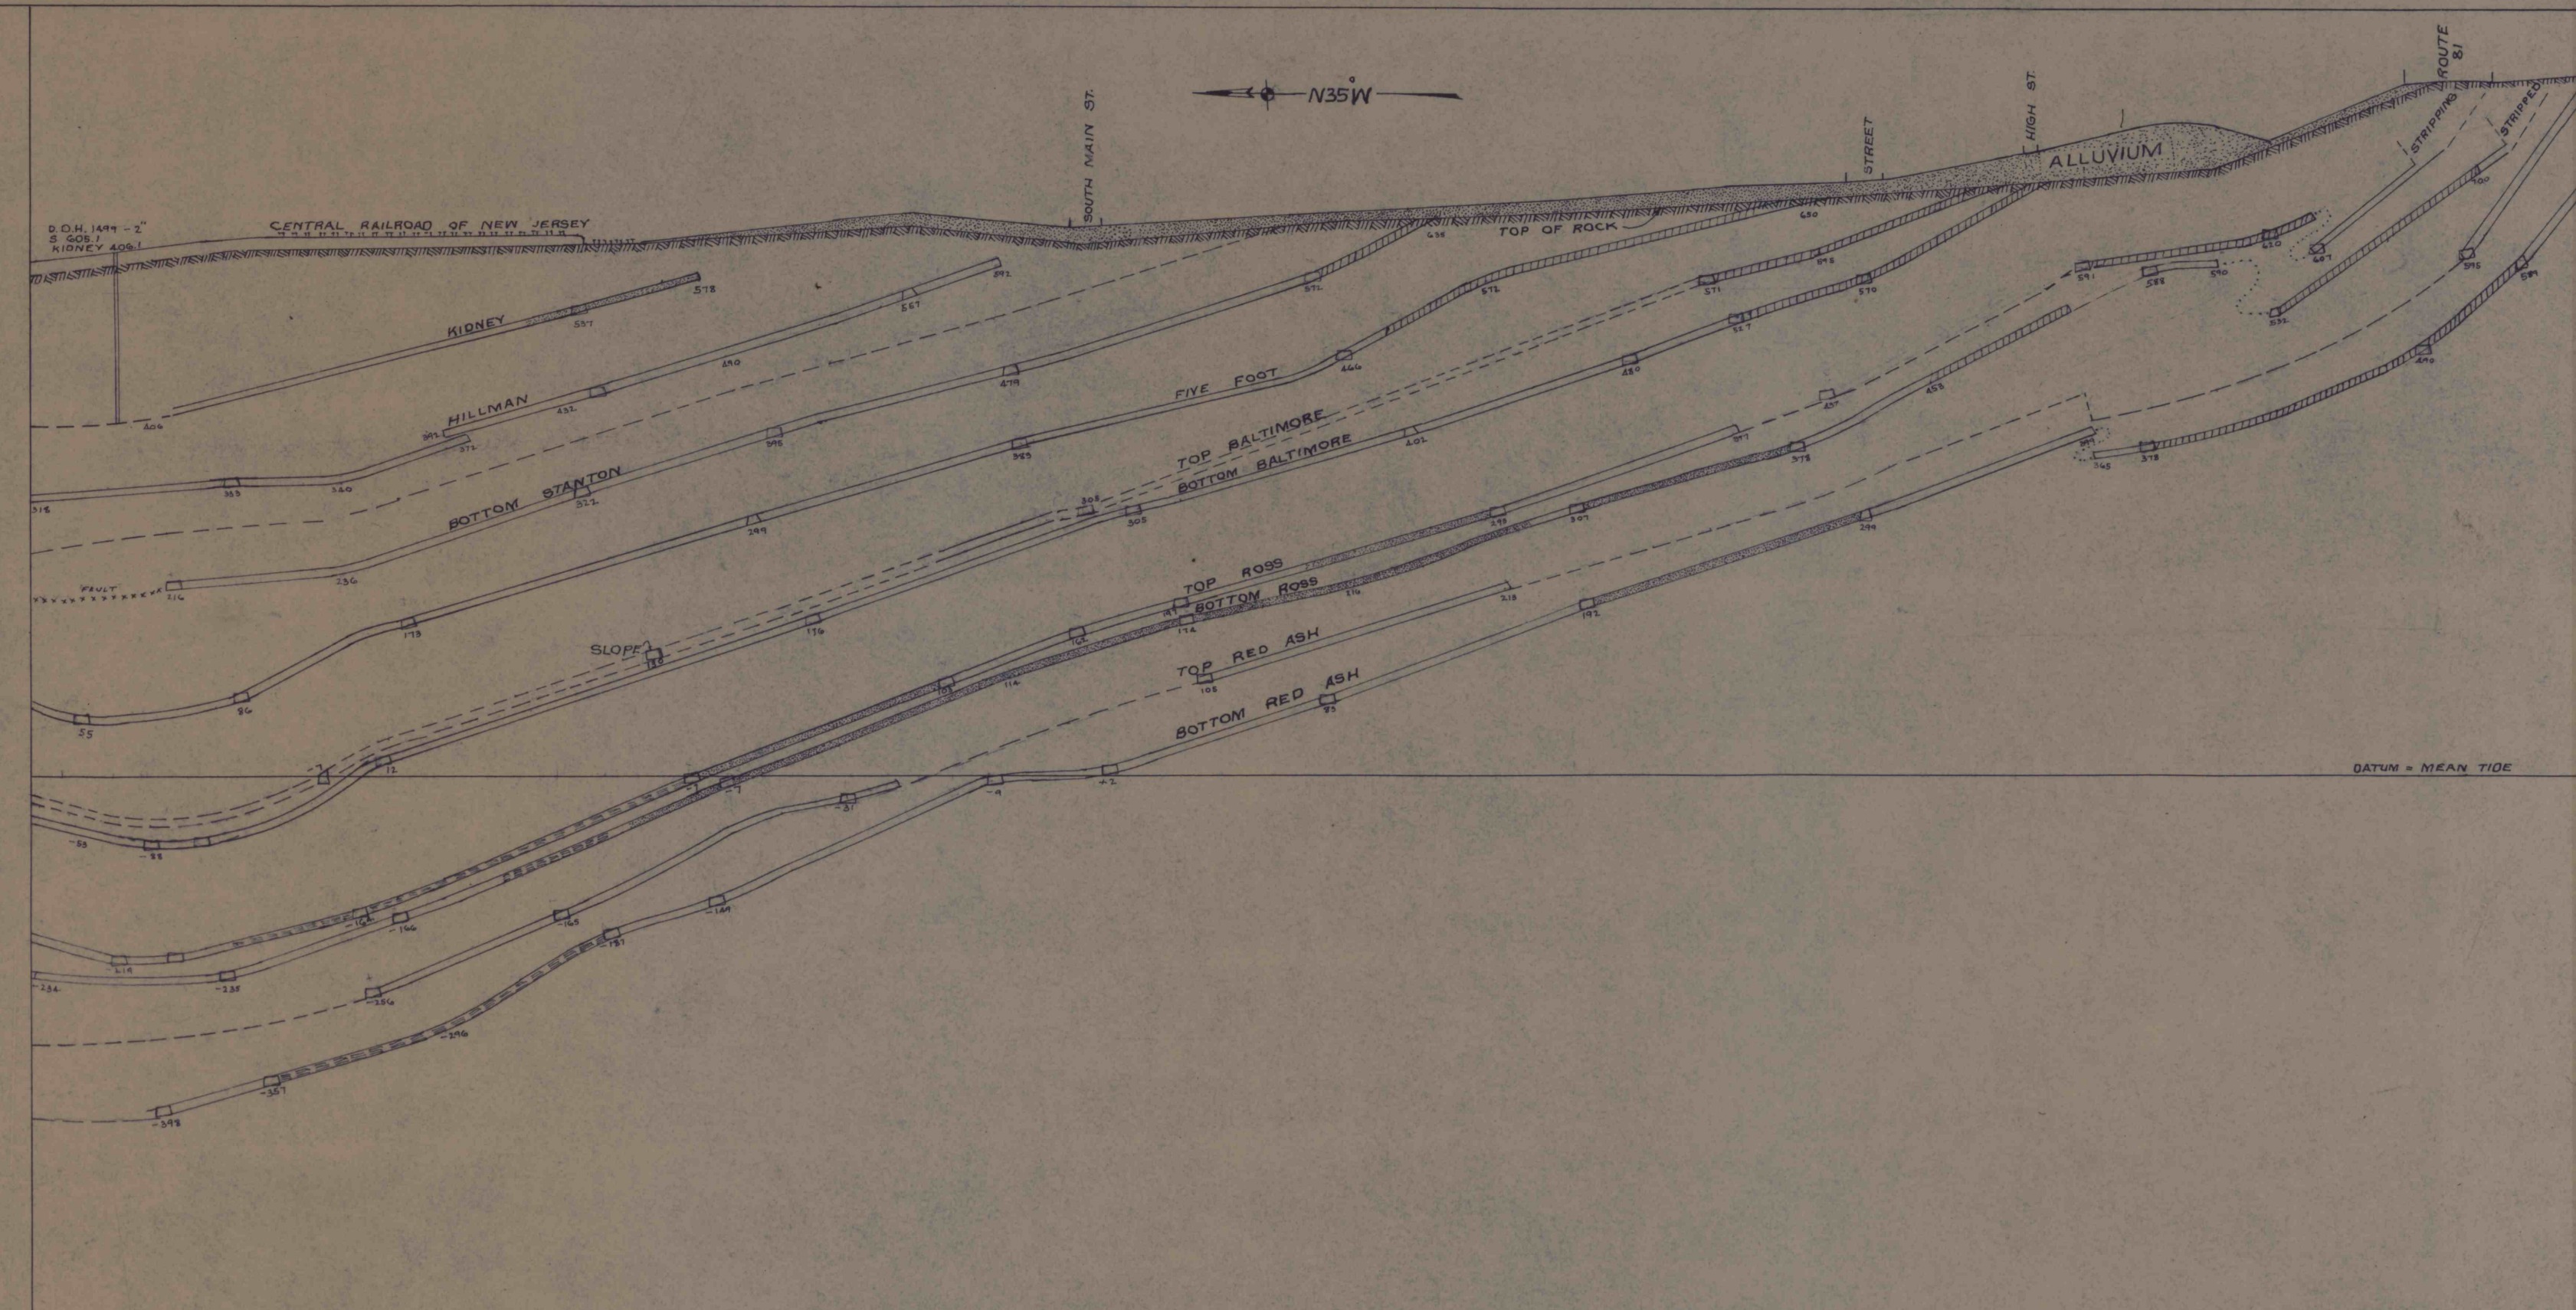

CROSS SECTION FOLIO 2XX
LOOKING UPSTREAM
HORIZONTAL & VERTICAL SCALE IN FEET

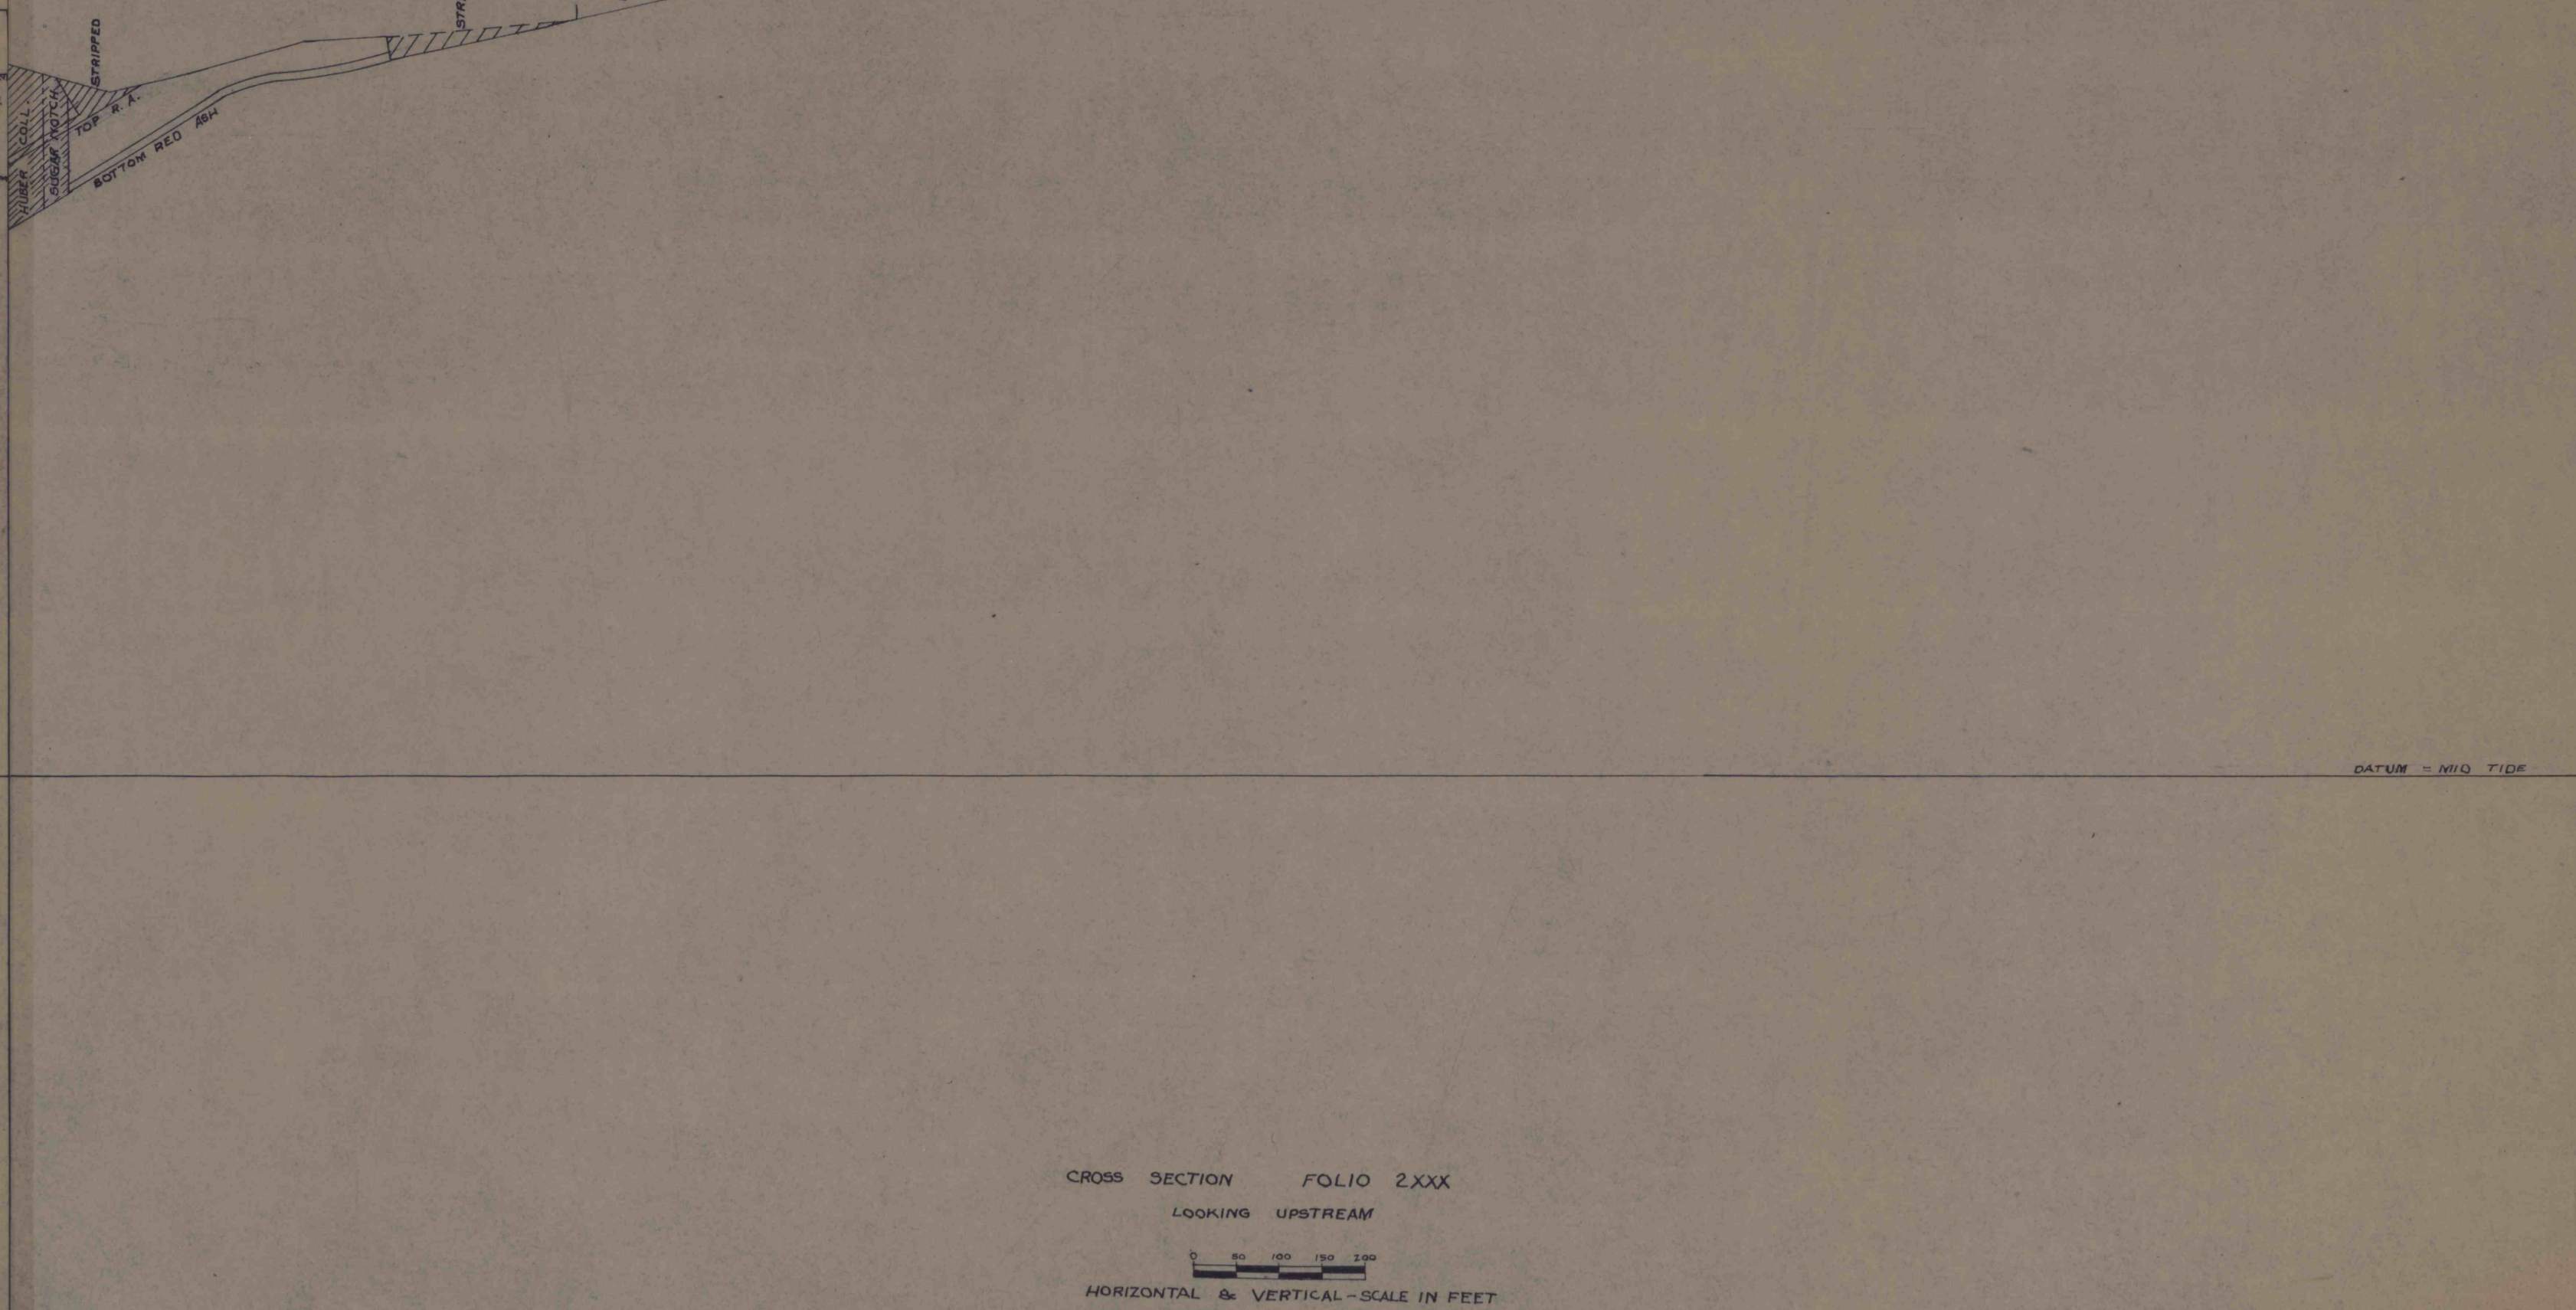

CROSS SECTION FOLIO 2XXX
LOOKING UPSTREAM
HORIZONTAL & VERTICAL SCALE IN FEET