


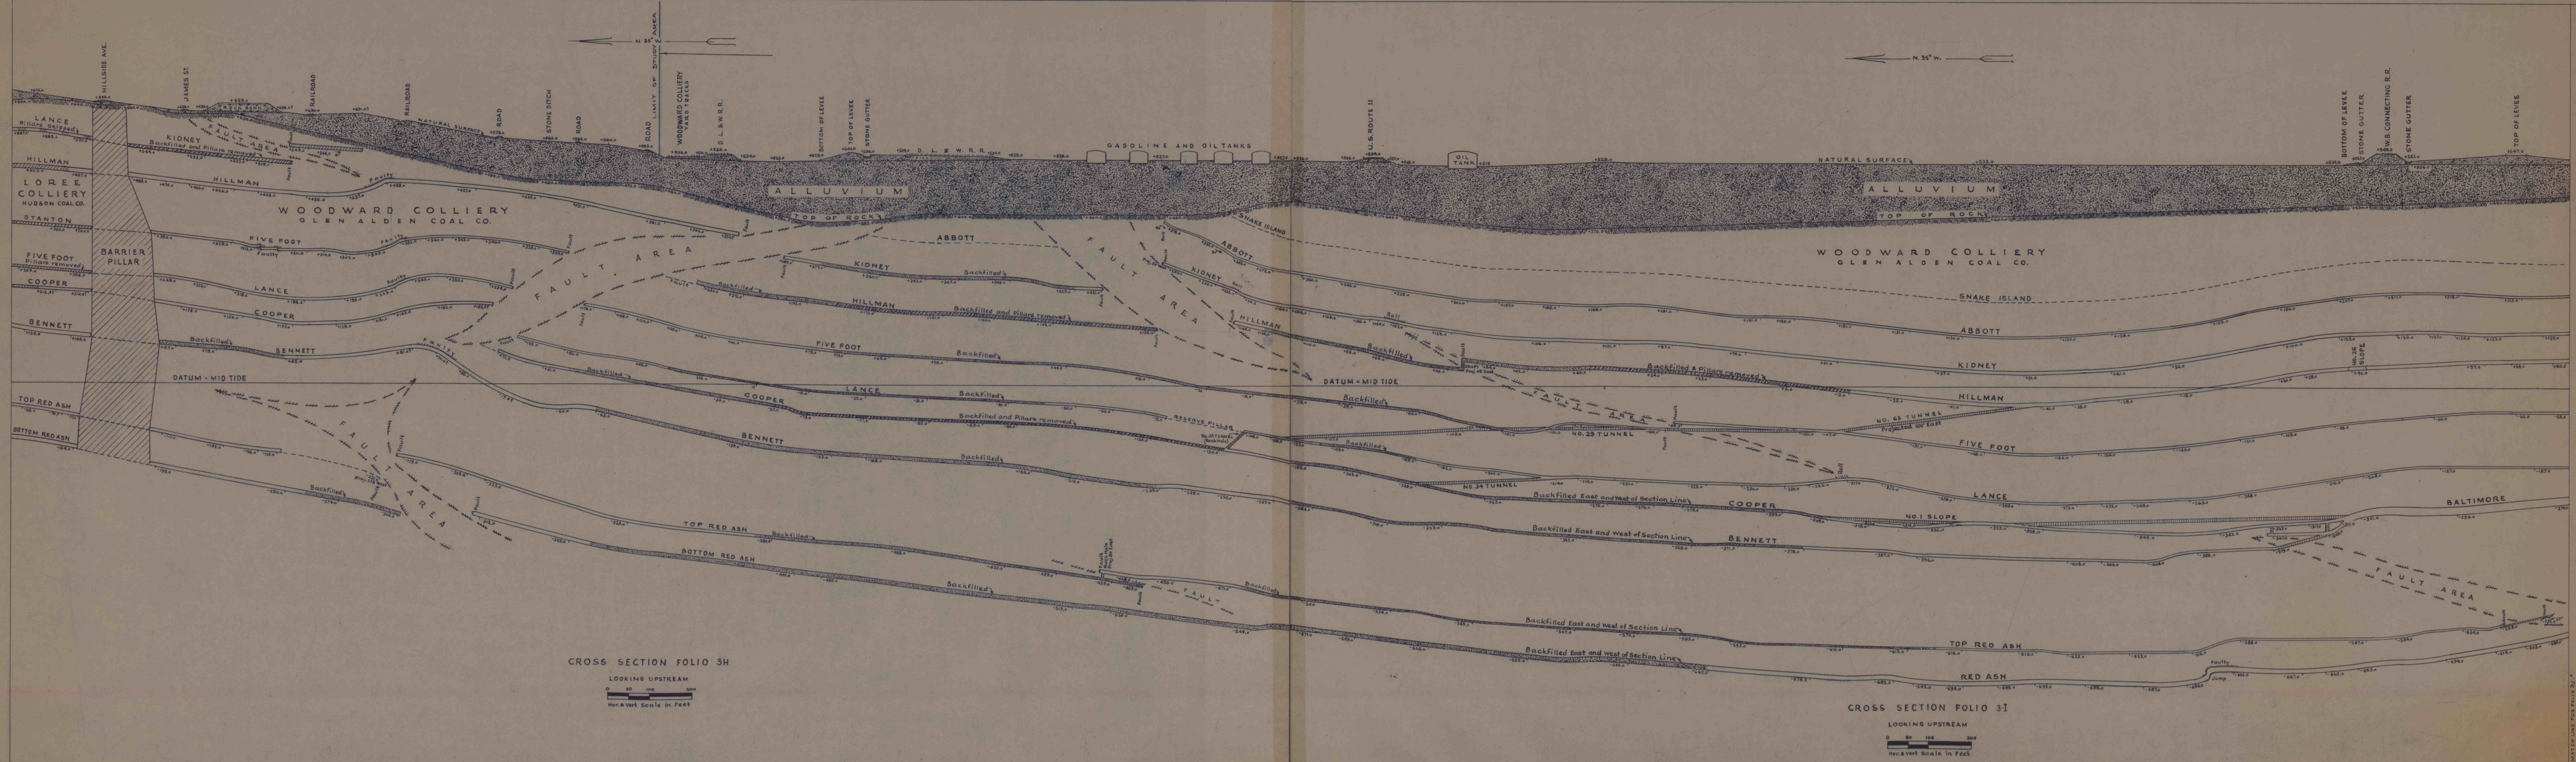

CROSS SECTION FOLIO 3H
LOOKING UPSTREAM
Horizontal Scale in Feet
0 50 100 200

CROSS SECTION FOLIO 3I
LOOKING UPSTREAM
Horizontal Scale in Feet
0 50 100 200