


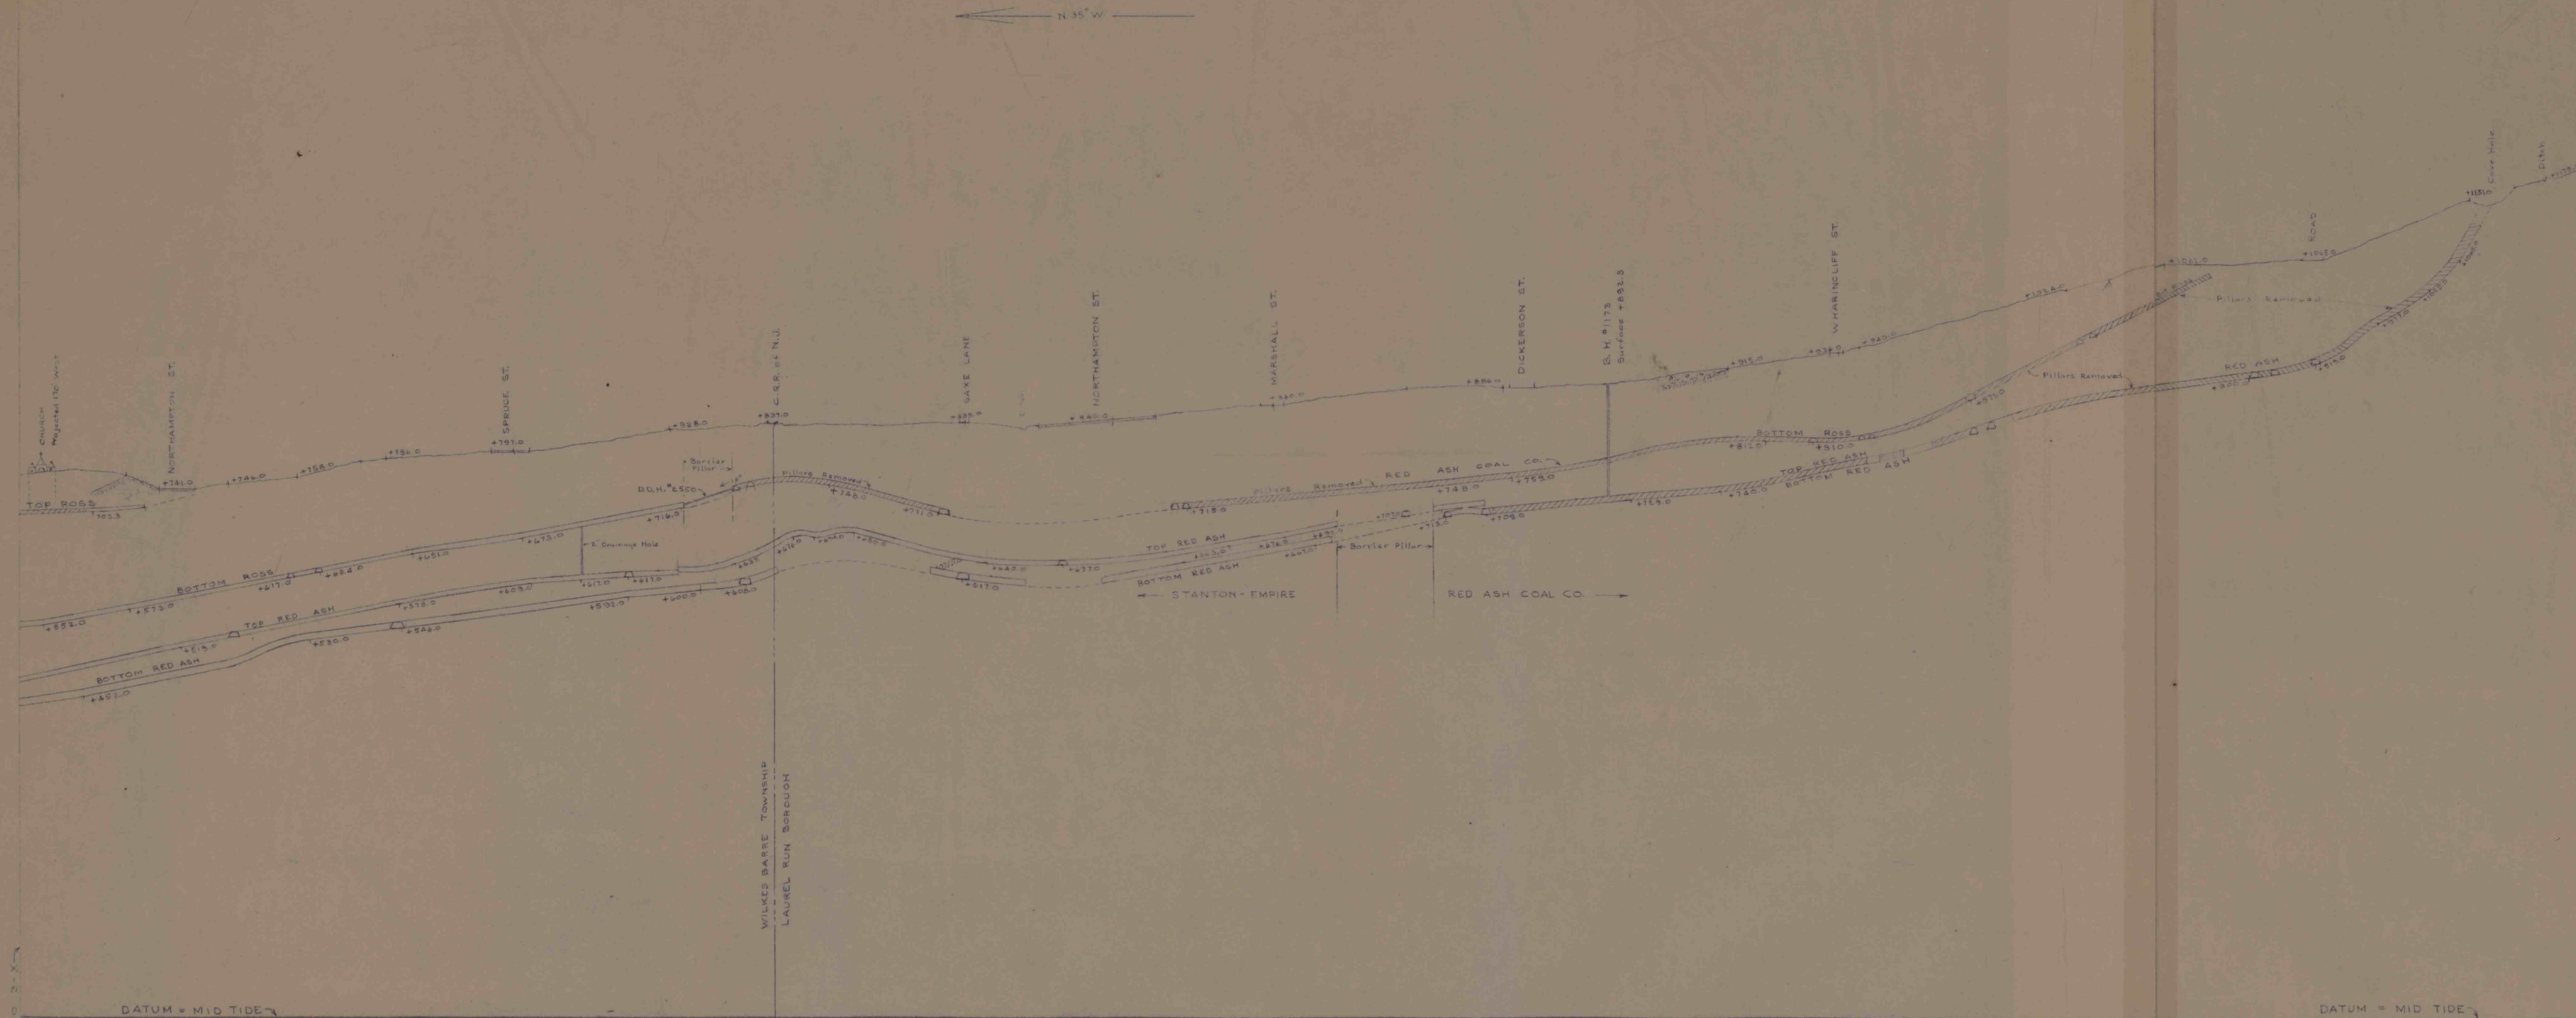

CROSS SECTION FOLIO 3-XX

LOOKING NORTHEAST
0 50 100
Horizontal Scale in Feet

N 35° W

DATUM = MID TIDE

CROSS SECTION FOLIO 3-XXX

LOOKING NORTHEAST
0 50 100
Horizontal Scale in Feet