CRS #4 ← → CRS #5

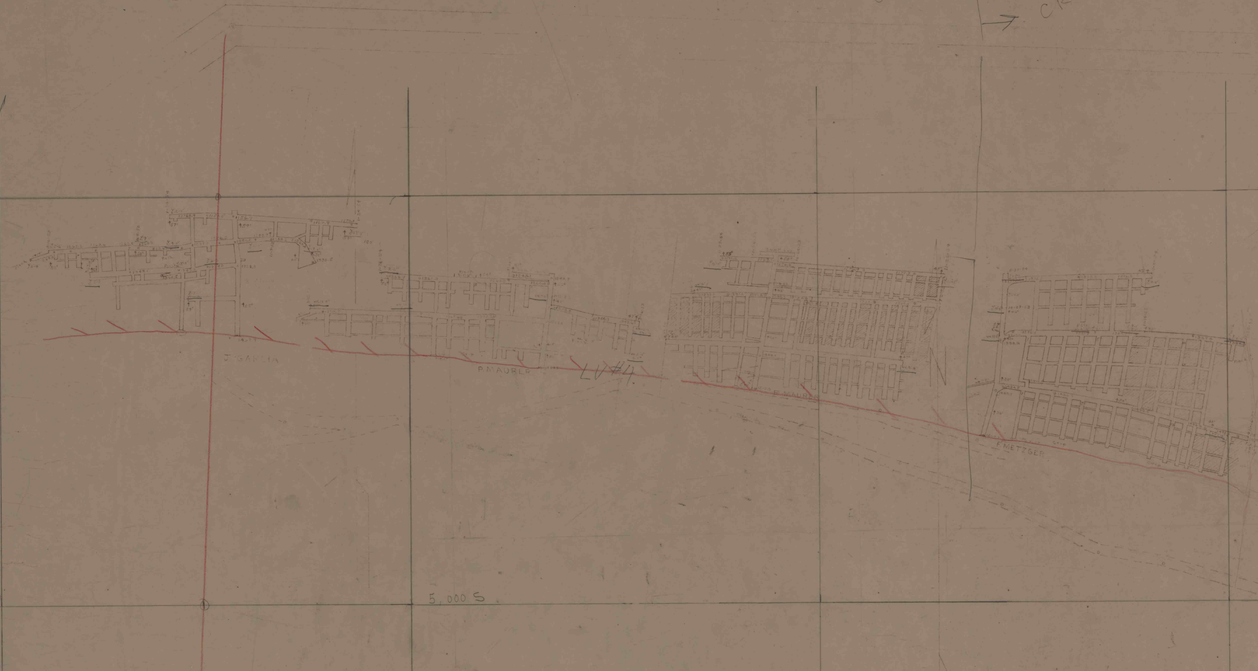

Lykens Workings
Shamokin West

Lykens Workings
Shamokin West