


6872

11

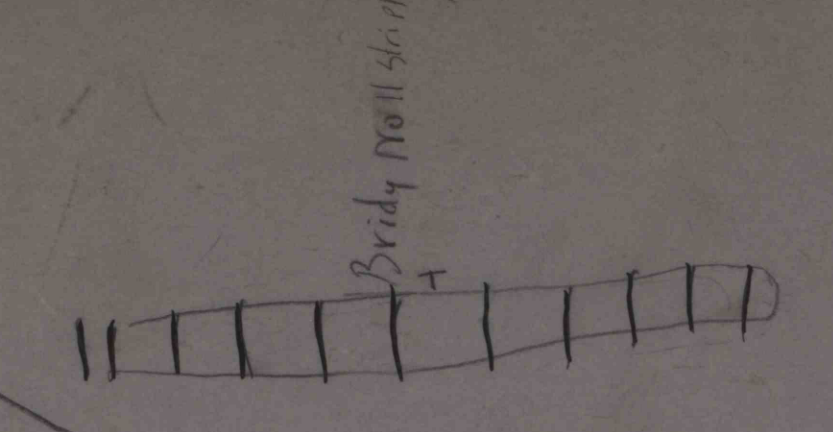

13000E

13000E

15000E

18000E

13

2000S

2000S

9 3/4

10 1/2

10

12

12

12

JOHN WHITE TRACT

4000S

10 1/2

John White tract

10

9 1/2

9

5000S

13000E

\$1

\$3

\$5

\$6

\$7

18000E

\$9

\$10



Spring Creek

Thompson Tract

9 1/2

4 1/2

10 1/2

10

9 1/2

4 1/2

18

18

18

18

18