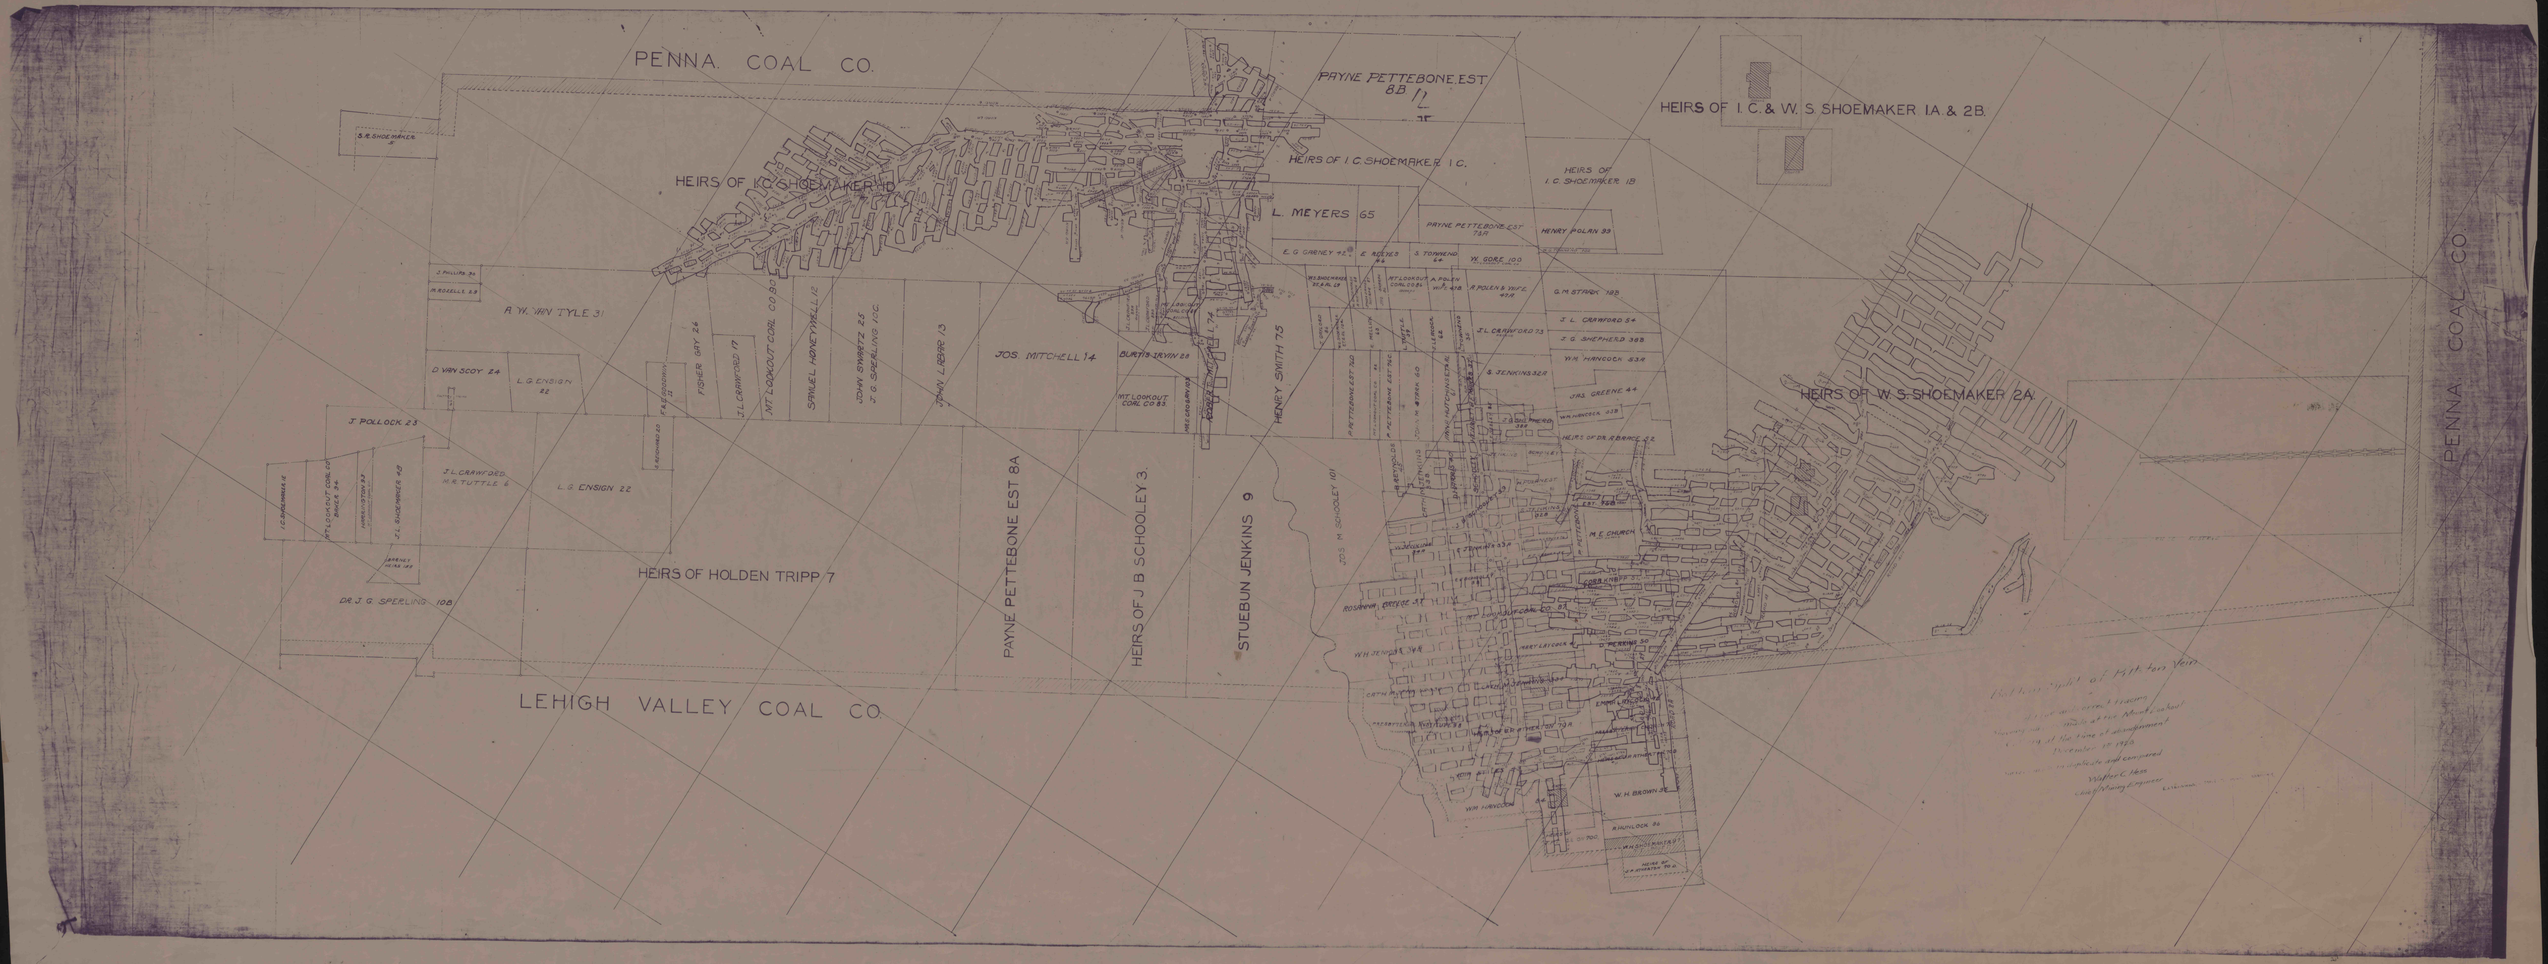
PENNA. COAL CO.
PAYNE PETTEBONE EST 8B
HEIRS OF I. C. & W. S. SHOEMAKER 1A & 2B.
HEIRS OF I. C. SHOEMAKER 1D
HEIRS OF I. C. SHOEMAKER 1C.
HEIRS OF I. C. SHOEMAKER 1B
L. MEYERS 65
PAYNE PETTEBONE EST 7B
HENRY POLAN 93
E. G. GARNEY 42
E. ROBERS 84
S. TOWNEND 64
W. GORE 100
R. W. VAN TYLE 31
D. VAN SCOY 24
L. G. ENSIGN 22
J. POLLOCK 23
FISHER GRY 24
J. L. CRAWFORD 17
WT. LOOKOUT CORL CO 80
SAMUEL HONEYWELL 12
JOHN SWARTZ 25
J. G. SPEELING 10C
JOHN LEBRE 13
JOS. MITCHELL 14
BURTIS IRVIN 28
WT. LOOKOUT CORL CO 85
HENRY SMITH 75
A. POLEN 47A
A. POLEN & WIFE 47A
J. L. CRAWFORD 73
S. JENKINS 32B
G. M. STRAUB 18B
J. L. CRAWFORD 54
J. G. SHEPHERD 39B
WM. HANCOCK 53A
JAS. GREENE 44
HEIRS OF DR. R. BRINCE 5A
HEIRS OF W. S. SHOEMAKER 2A.
PENNA. COAL CO.
J. L. CRAWFORD
M. R. TUTTLE 6
L. G. ENSIGN 22
HEIRS OF HOLDEN TRIPP 7
DR. J. G. SPEELING 10B
PAYNE PETTEBONE EST 8A
HEIRS OF J. B. SCHOOLEY 3.
STUEBUN JENKINS 9
JOS. M. SCHOOLEY 101
M. E. CHURCH
LEHIGH VALLEY COAL CO.