


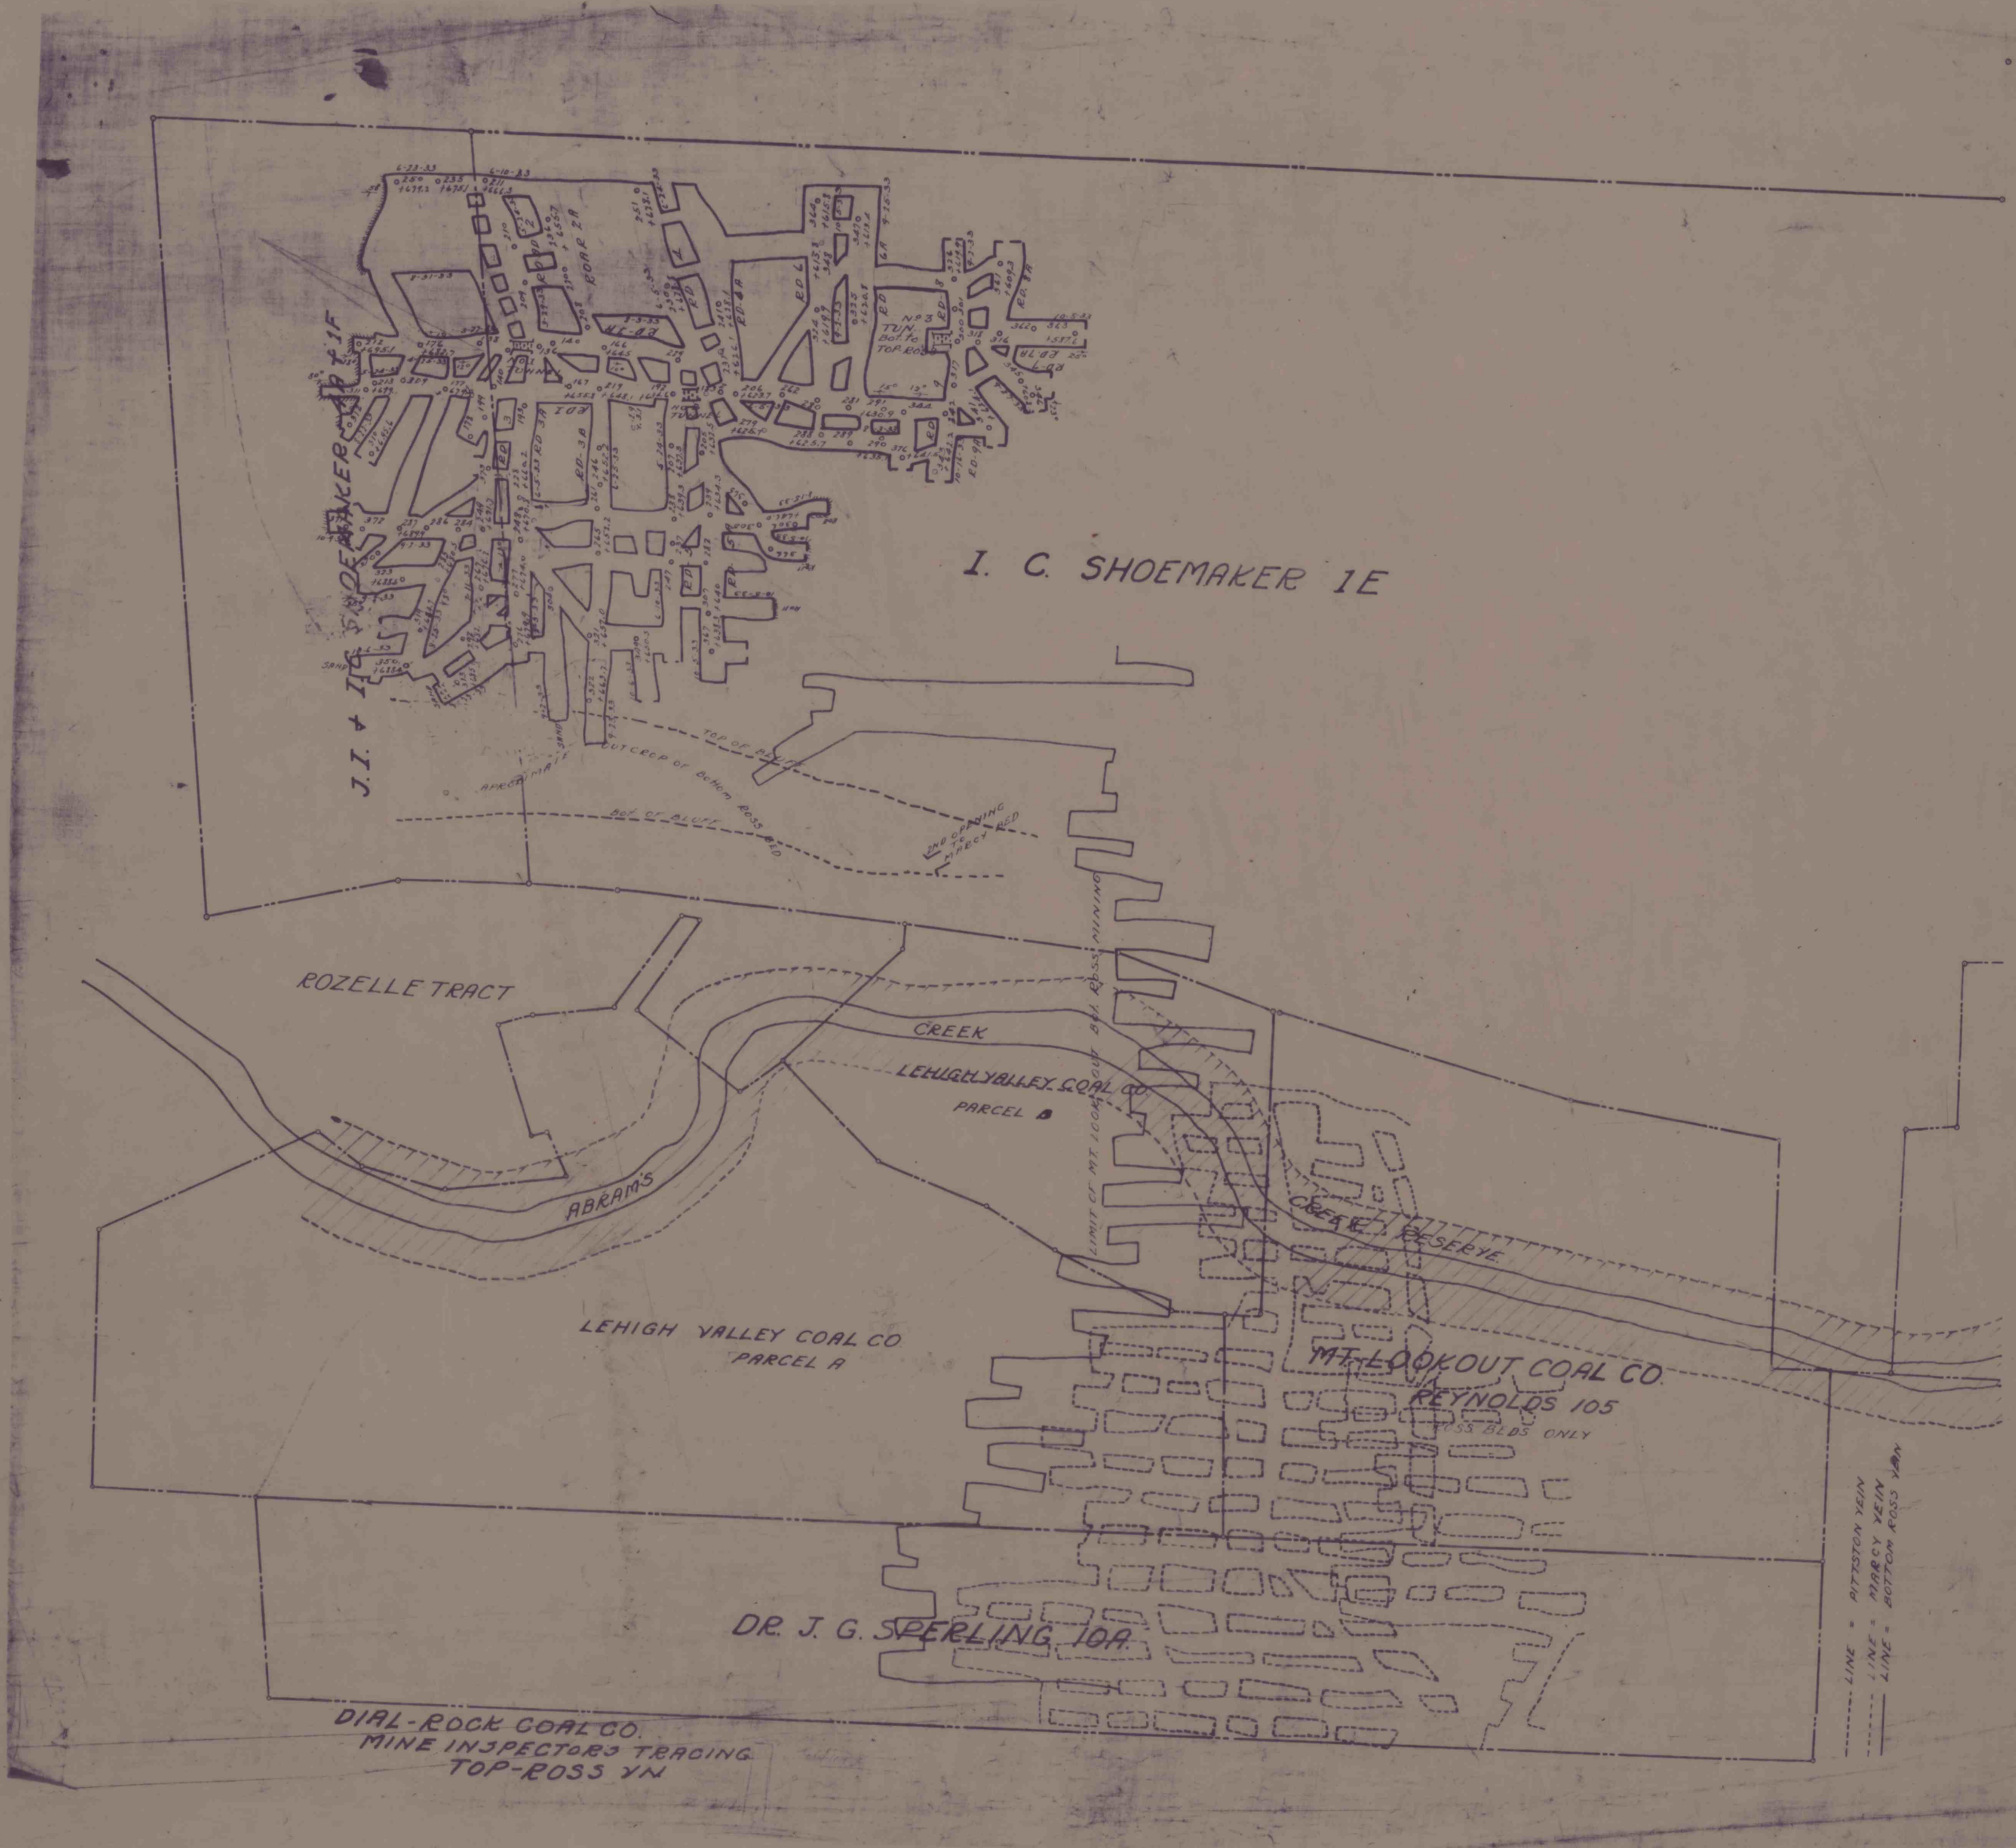

J.I. + I.C. SHOEMAKER 1E

I. C. SHOEMAKER 1E

ROZELLE TRACT

CREEK
LEHIGH VALLEY COAL CO.
PARCEL B

ABRAMS

LEHIGH VALLEY COAL CO.
PARCEL A

MT. LOOKOUT COAL CO.
REYNOLDS 105

DR. J. G. SPERLING 10A

DIAL ROCK COAL CO.
MINE INSPECTOR'S TRADING
TOP-ROSS YN

LINE - MARY YN
LINE - BOTTOM ROSS YN