


MT LOOKOUT COLLIERY
MT. LOOKOUT COAL CO..
RED ASH VEIN
WYOMING BOROUGH
LUZERNE CO PA

N-1364


SCALE

A true and correct tracing
Showing surveys made at the Mount Lashout
Colliery, at the time of abandonment
December 1st 1928.
Surveys made in duplicate and compared.
Walter C. Hess
Chief Mining Engineer

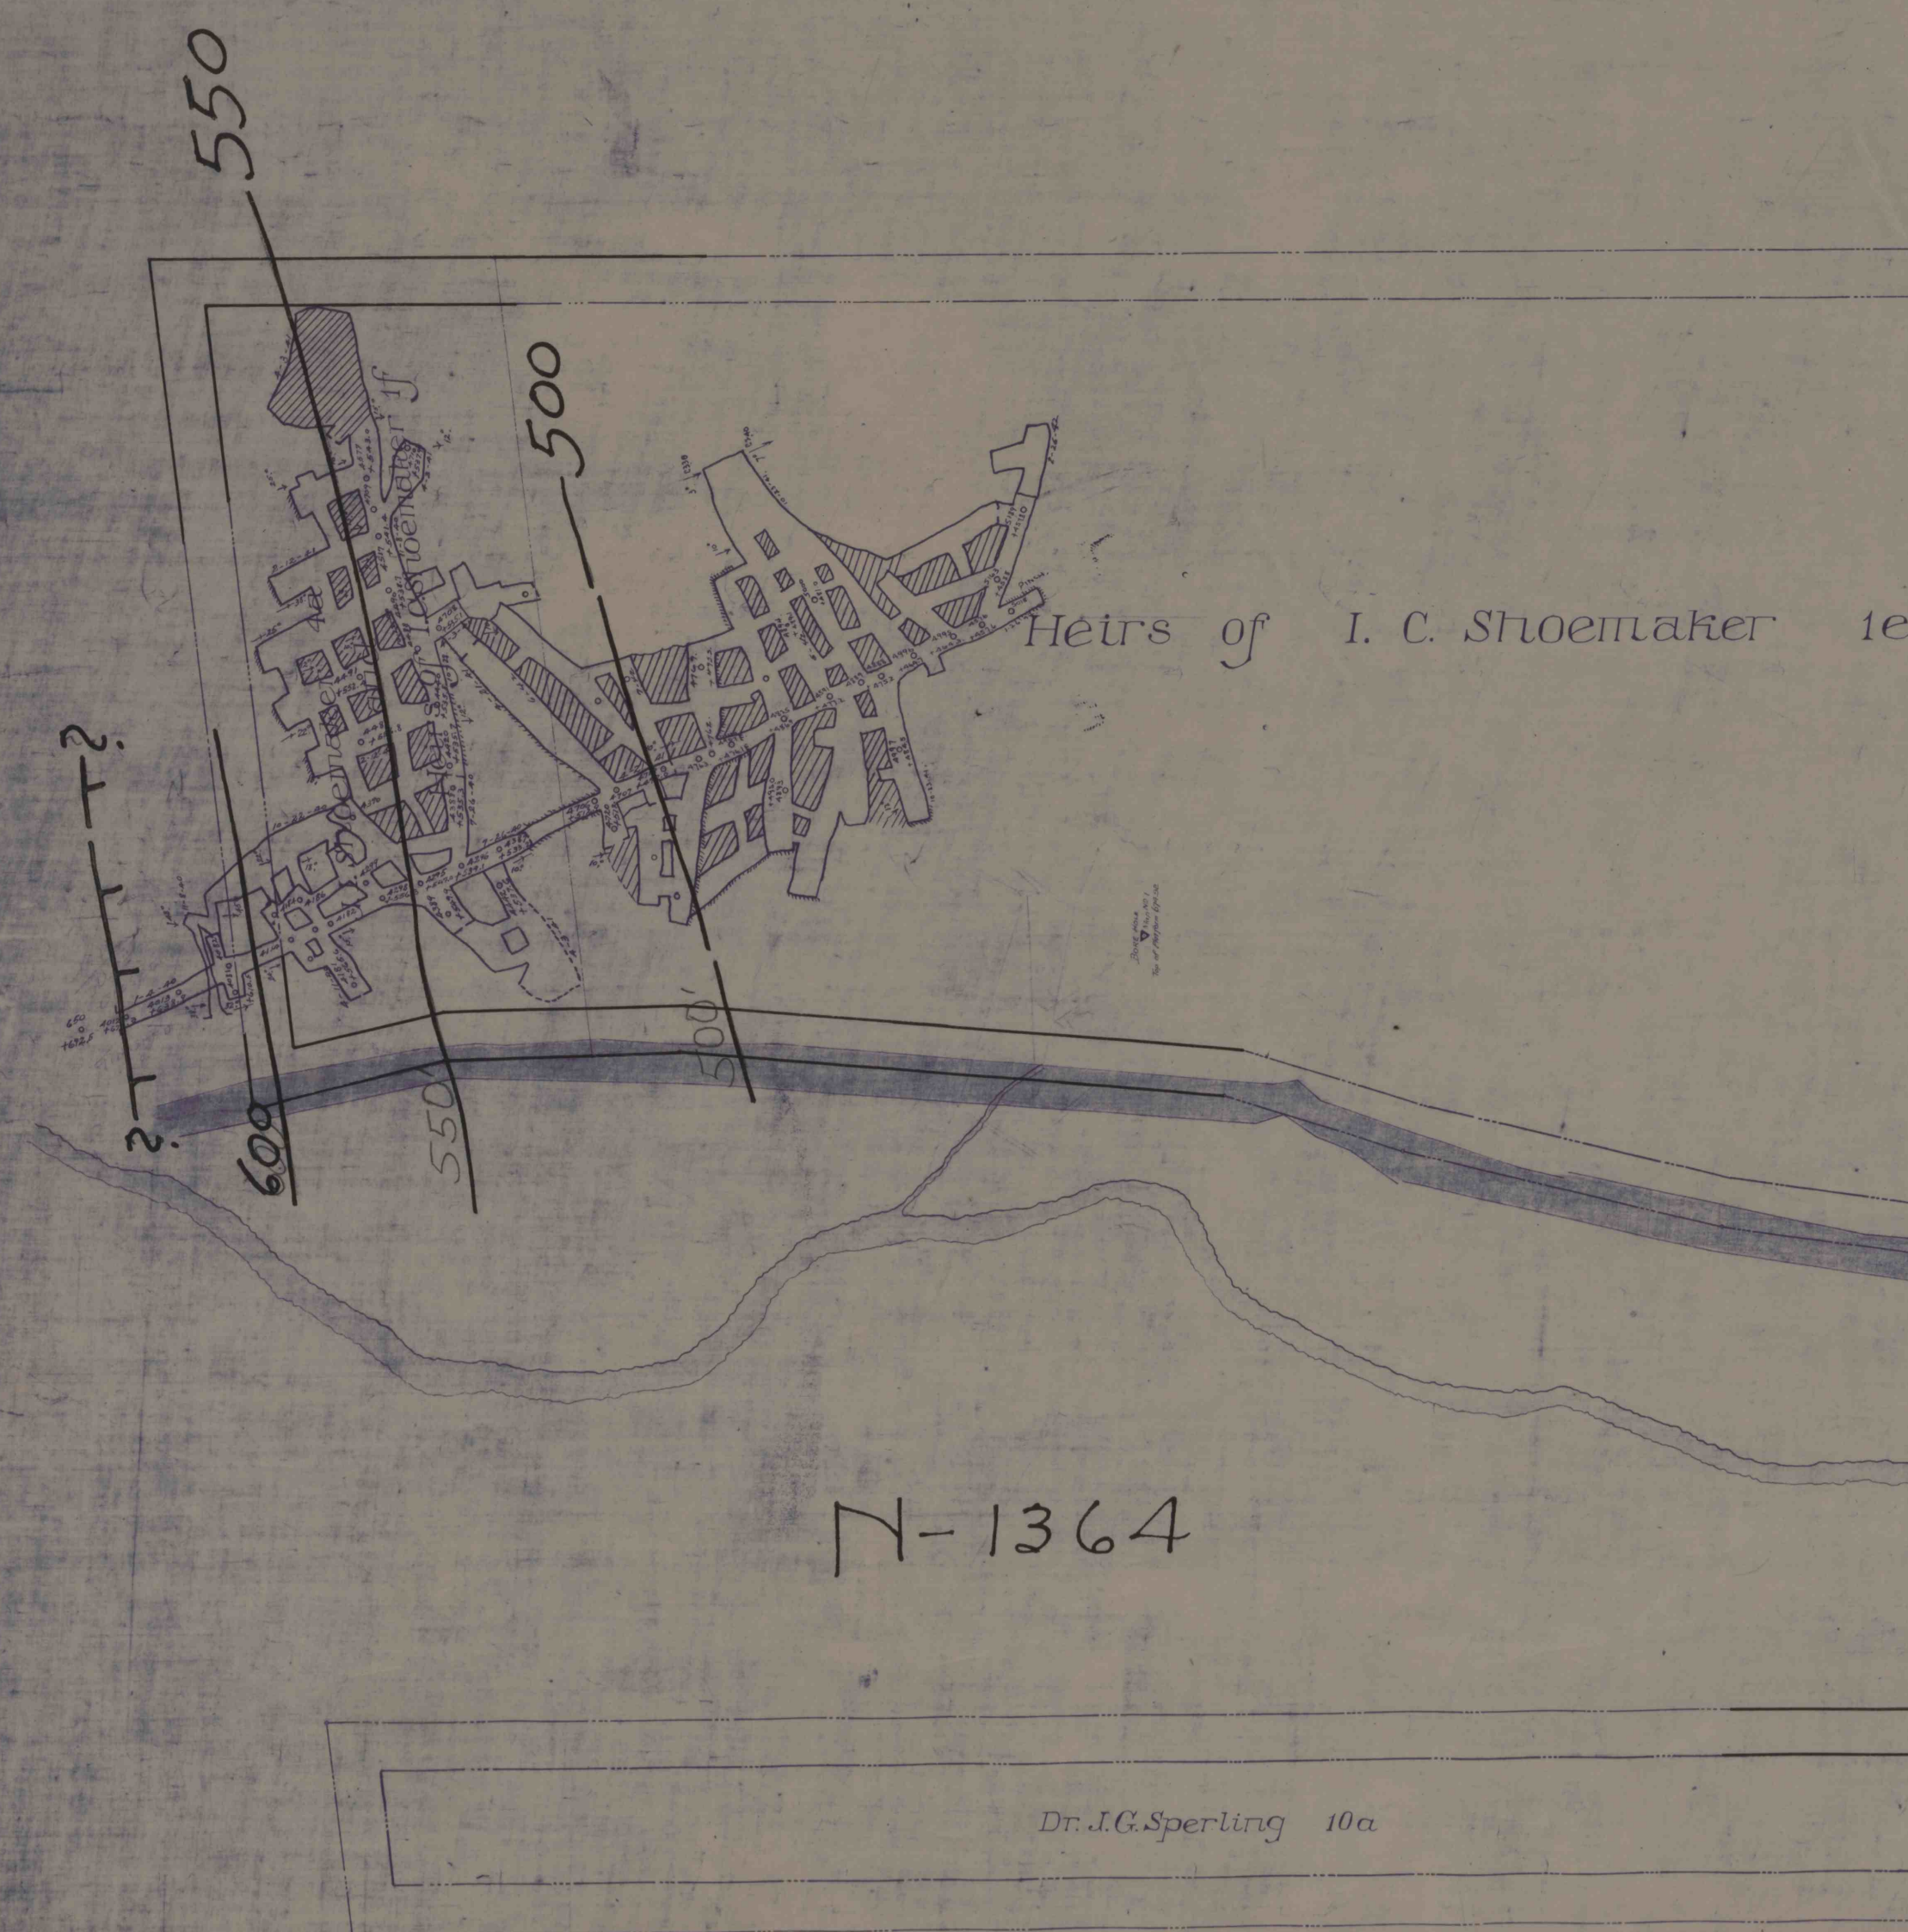

N-1364

L. V. COAL CO

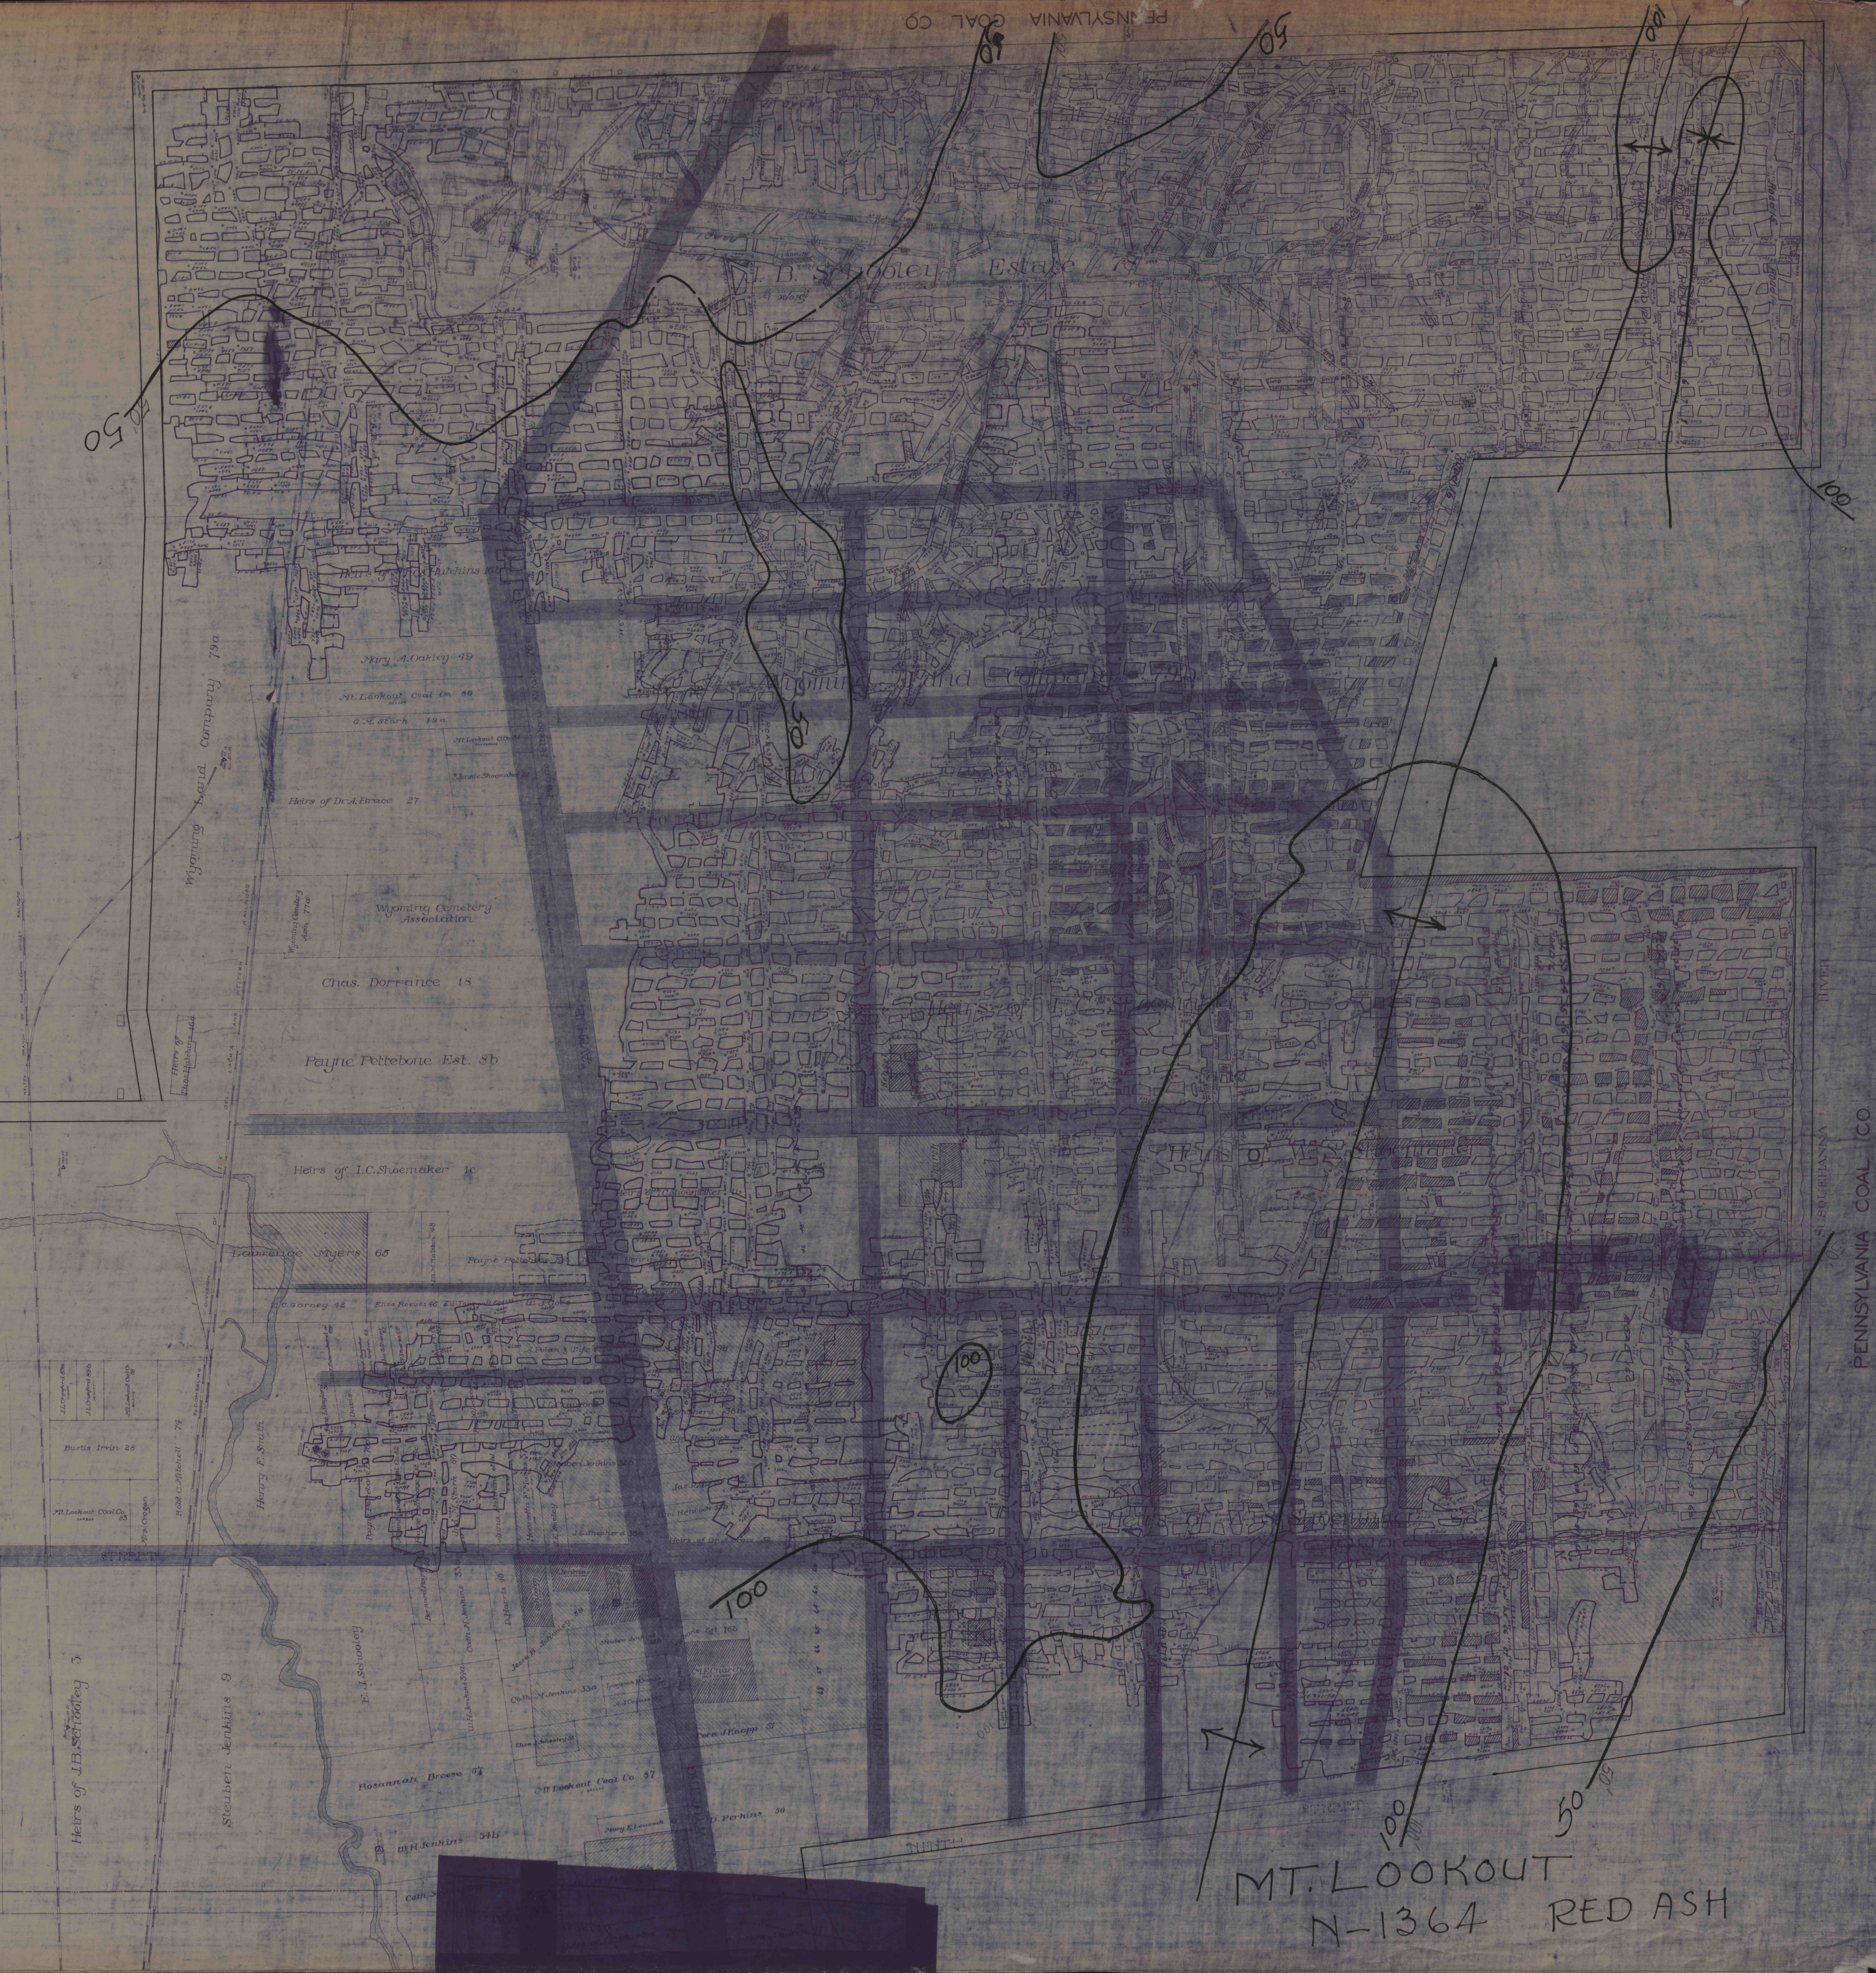

MT. LOOKOUT
N-1364 RED ASH