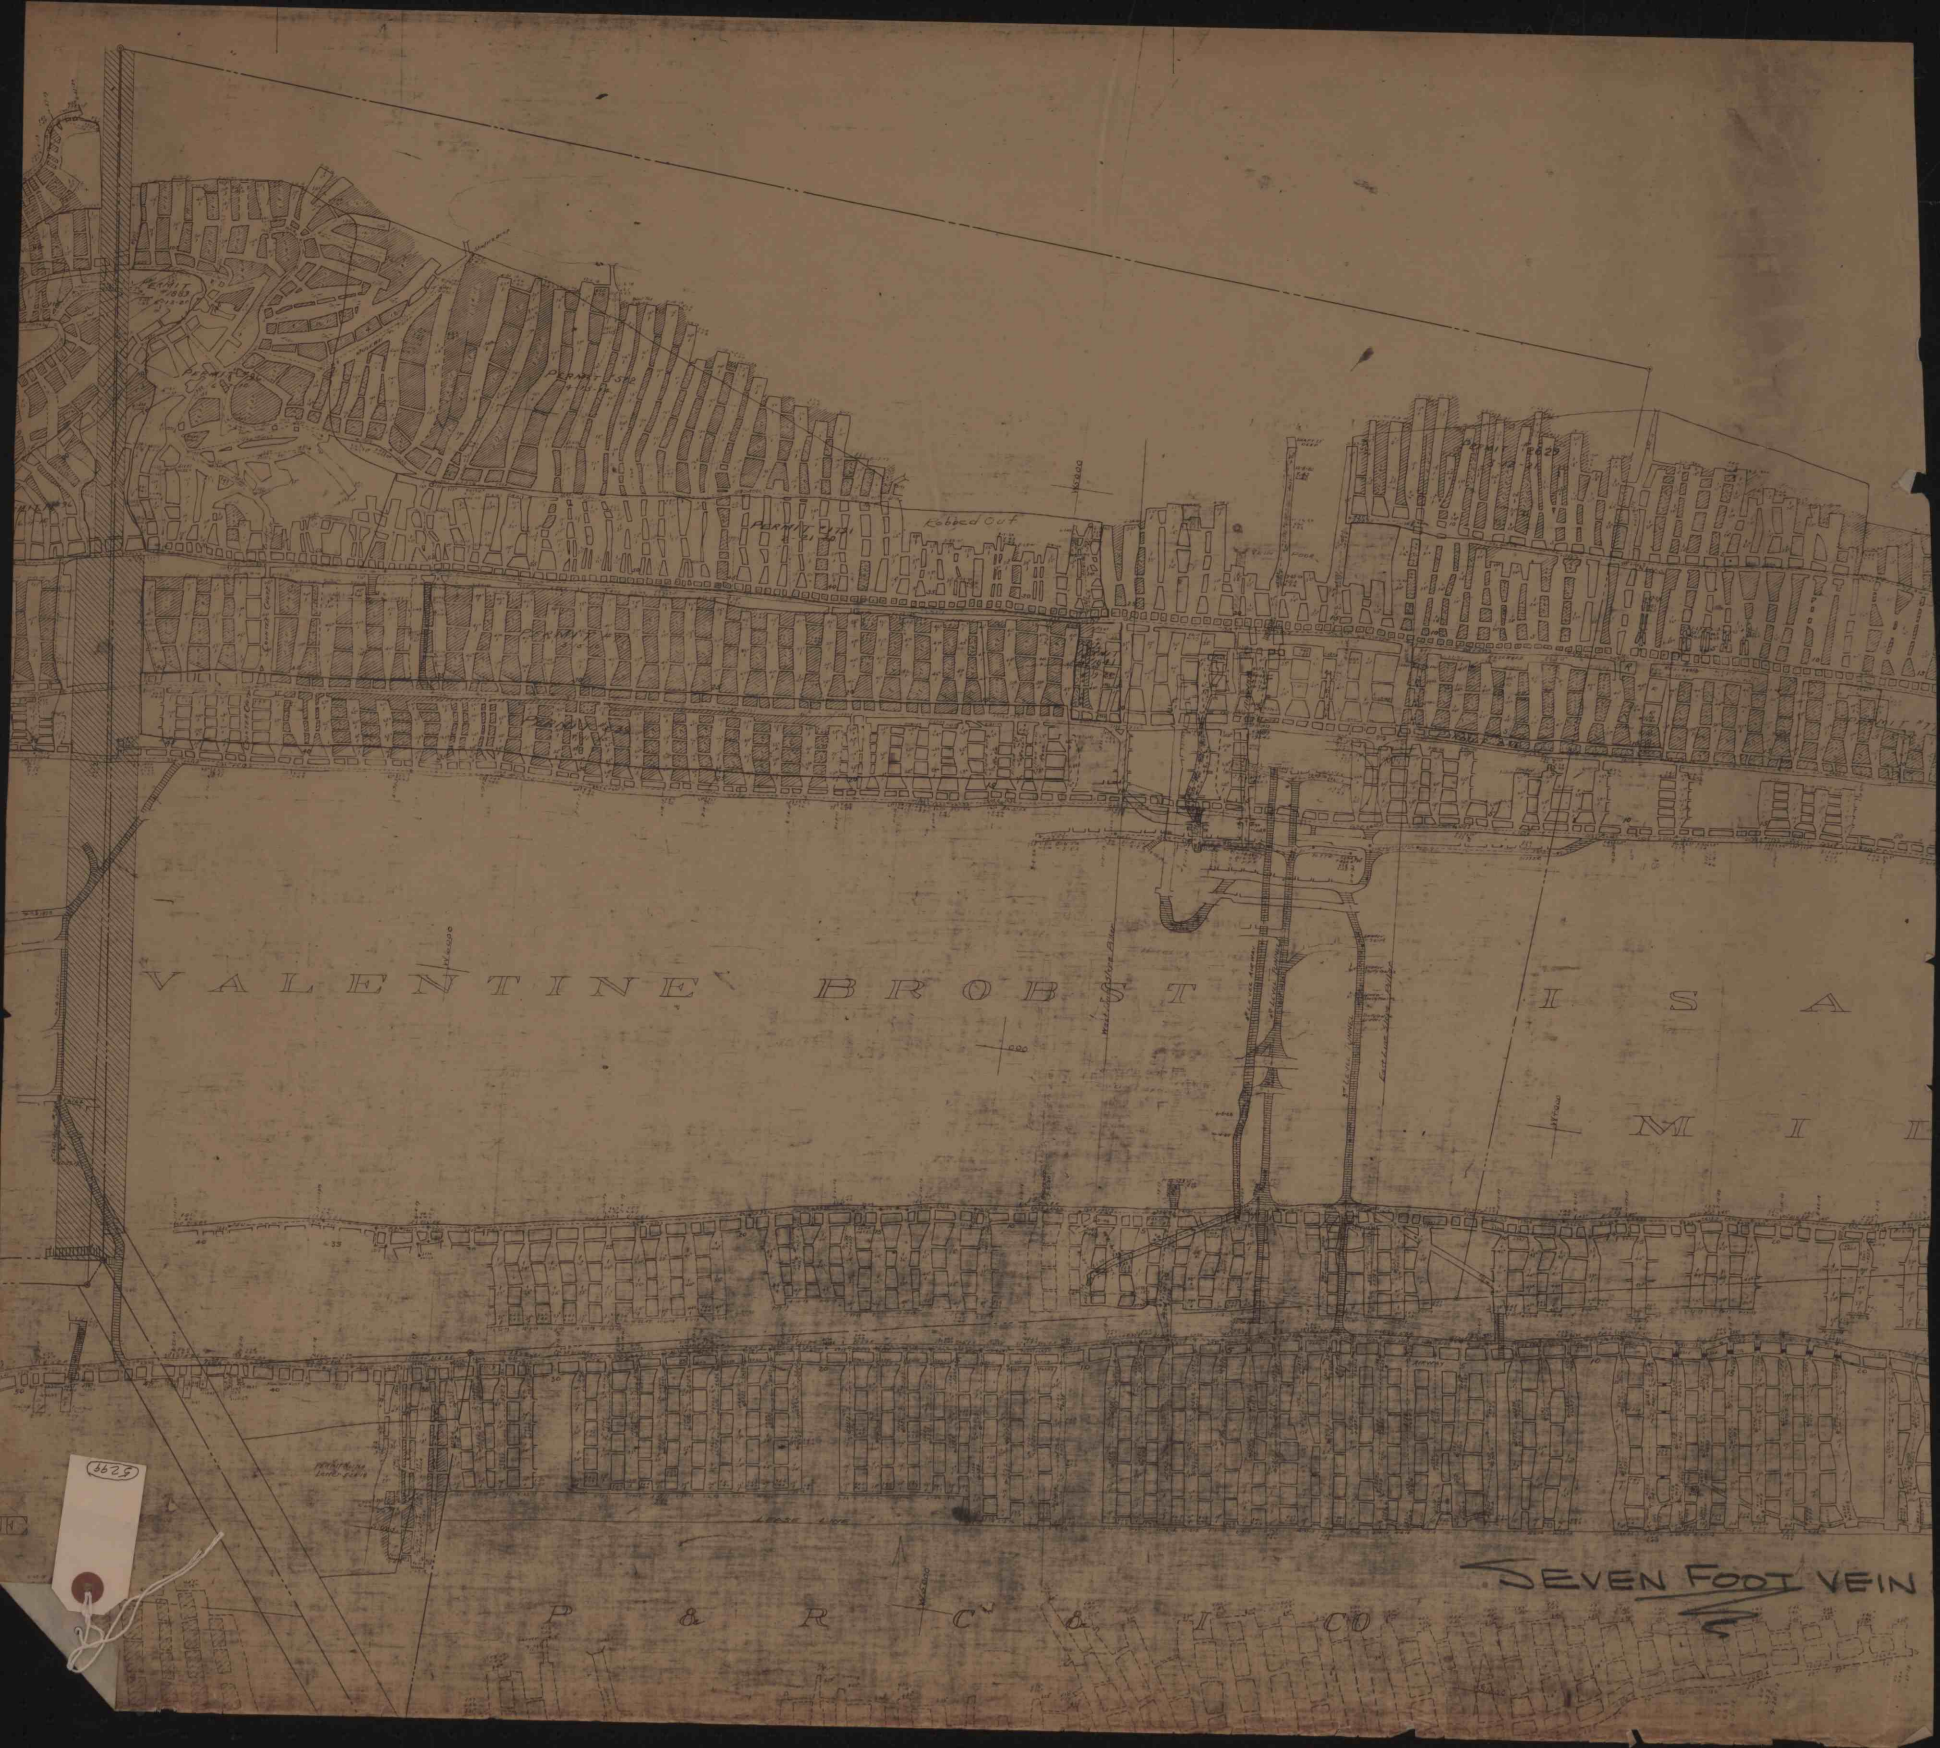
Robbed Out
VALENTINE
BROBST
I S A
M I L
SEVEN FOOT VEIN
P & R Cᵒ & I Cᵒ