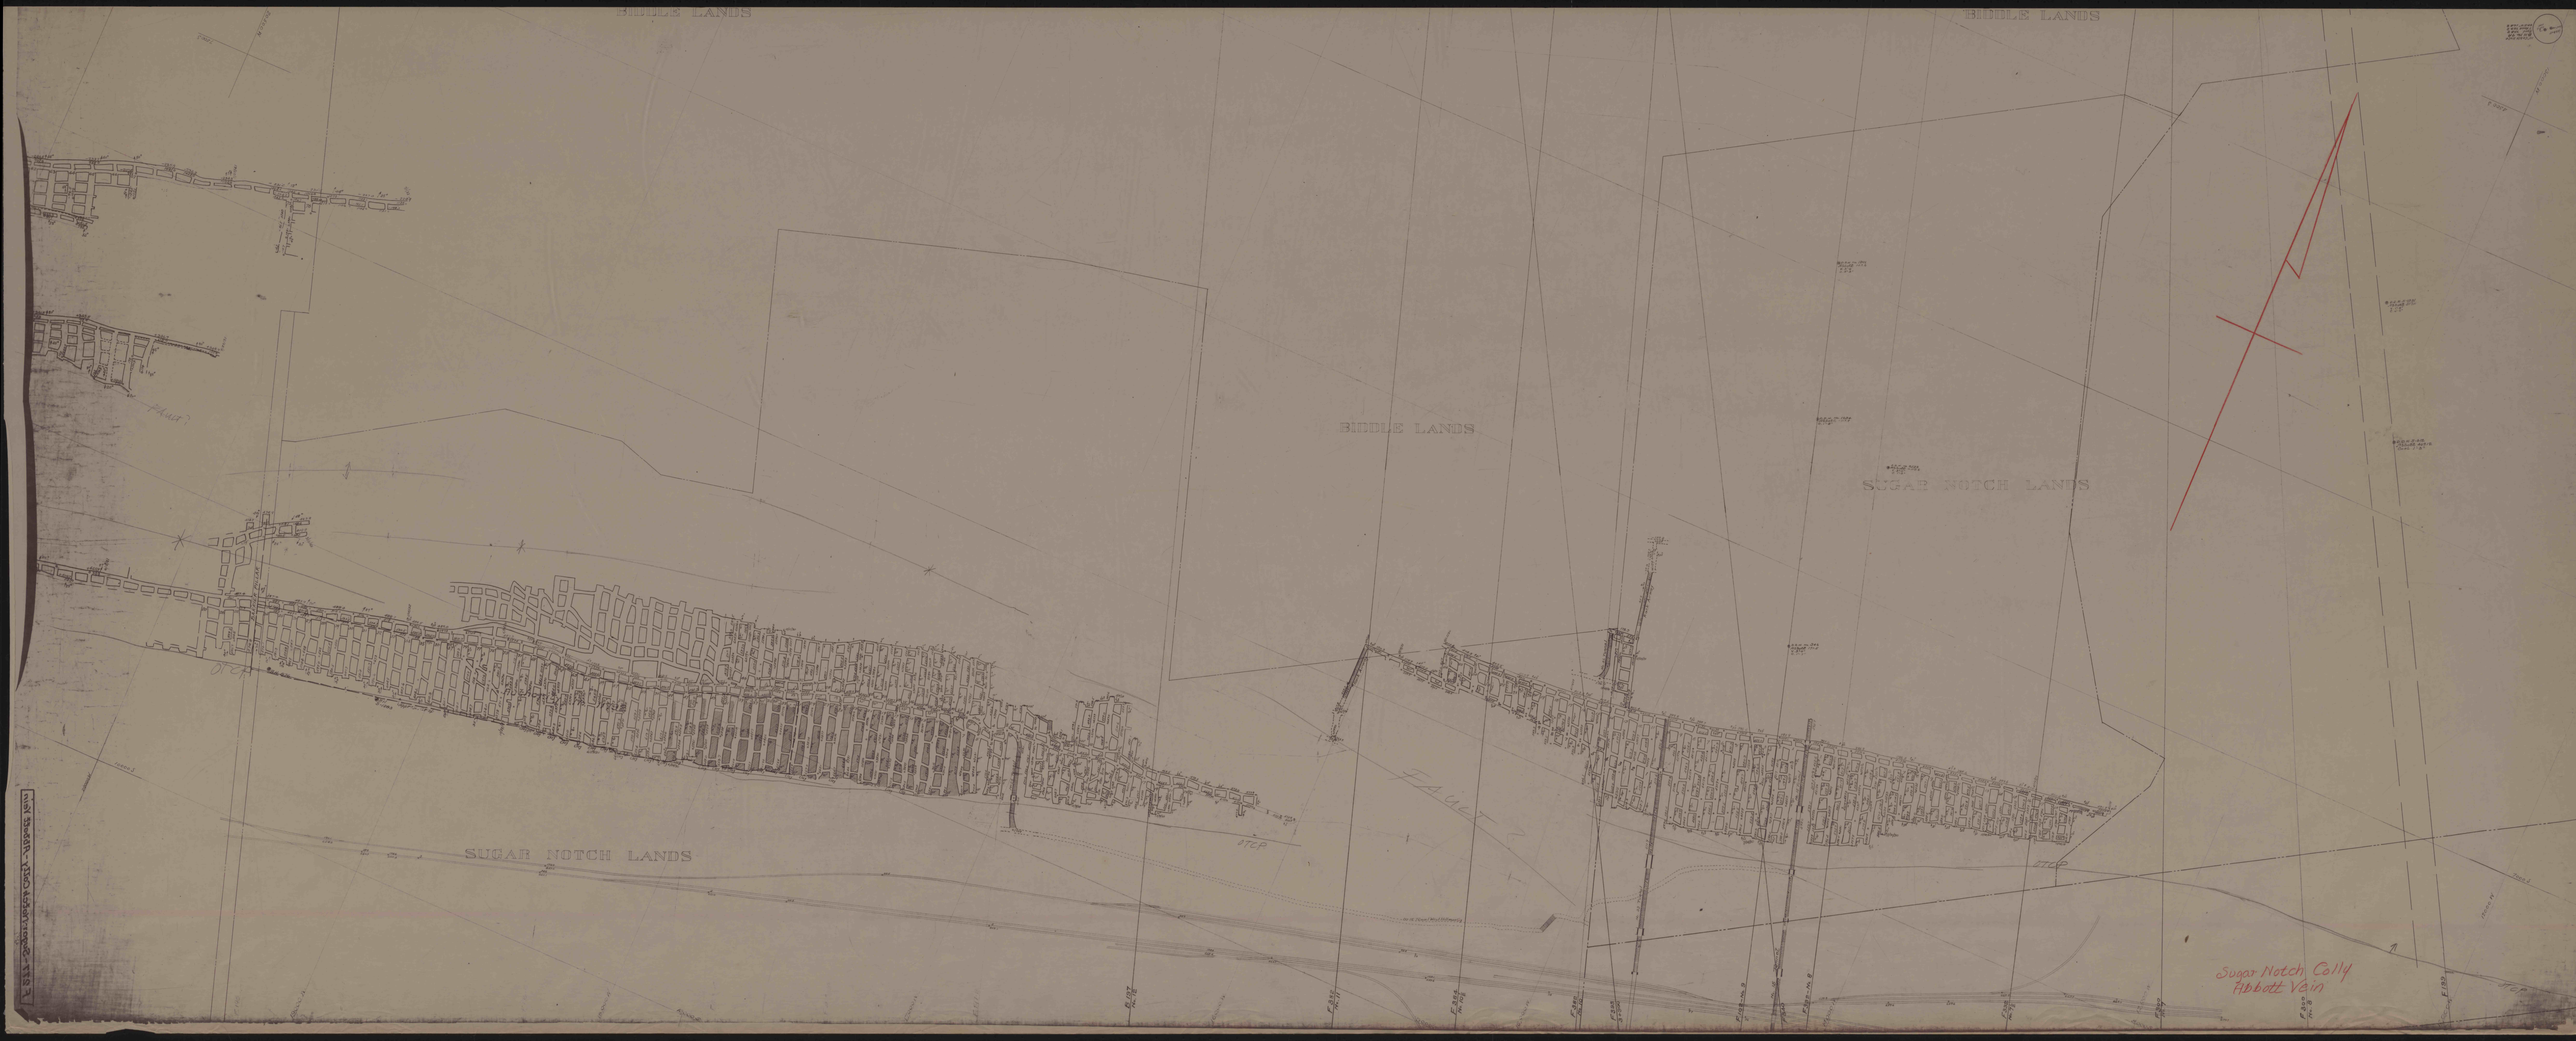
BIDDLE LANDS
BIDDLE LANDS
BIDDLE LANDS
SUGAR NOTCH LANDS
SUGAR NOTCH LANDS
FAULT
FAULT
Sugar Notch Colly
Pibbett Vein