


SUGAR NOTCH LANDS

HYNDYER TOWNSHIP
SUGAR NOTCH BOROUGH

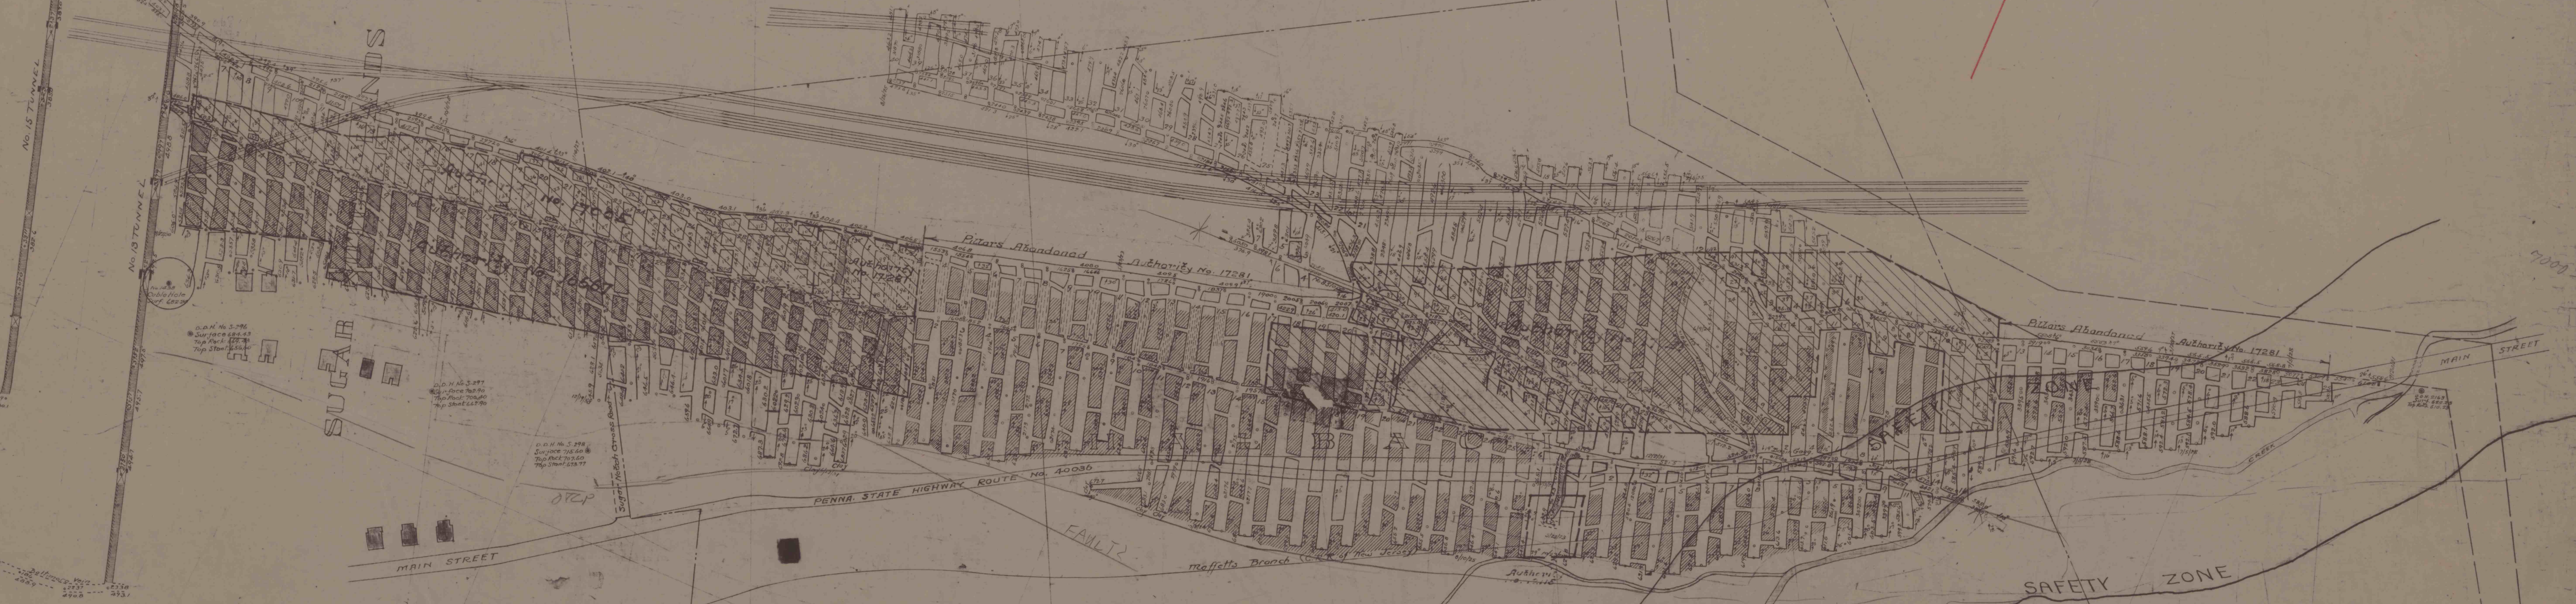

SUGAR NOTCH LANDS

Sugar Notch Colly
Top Stanton Vein