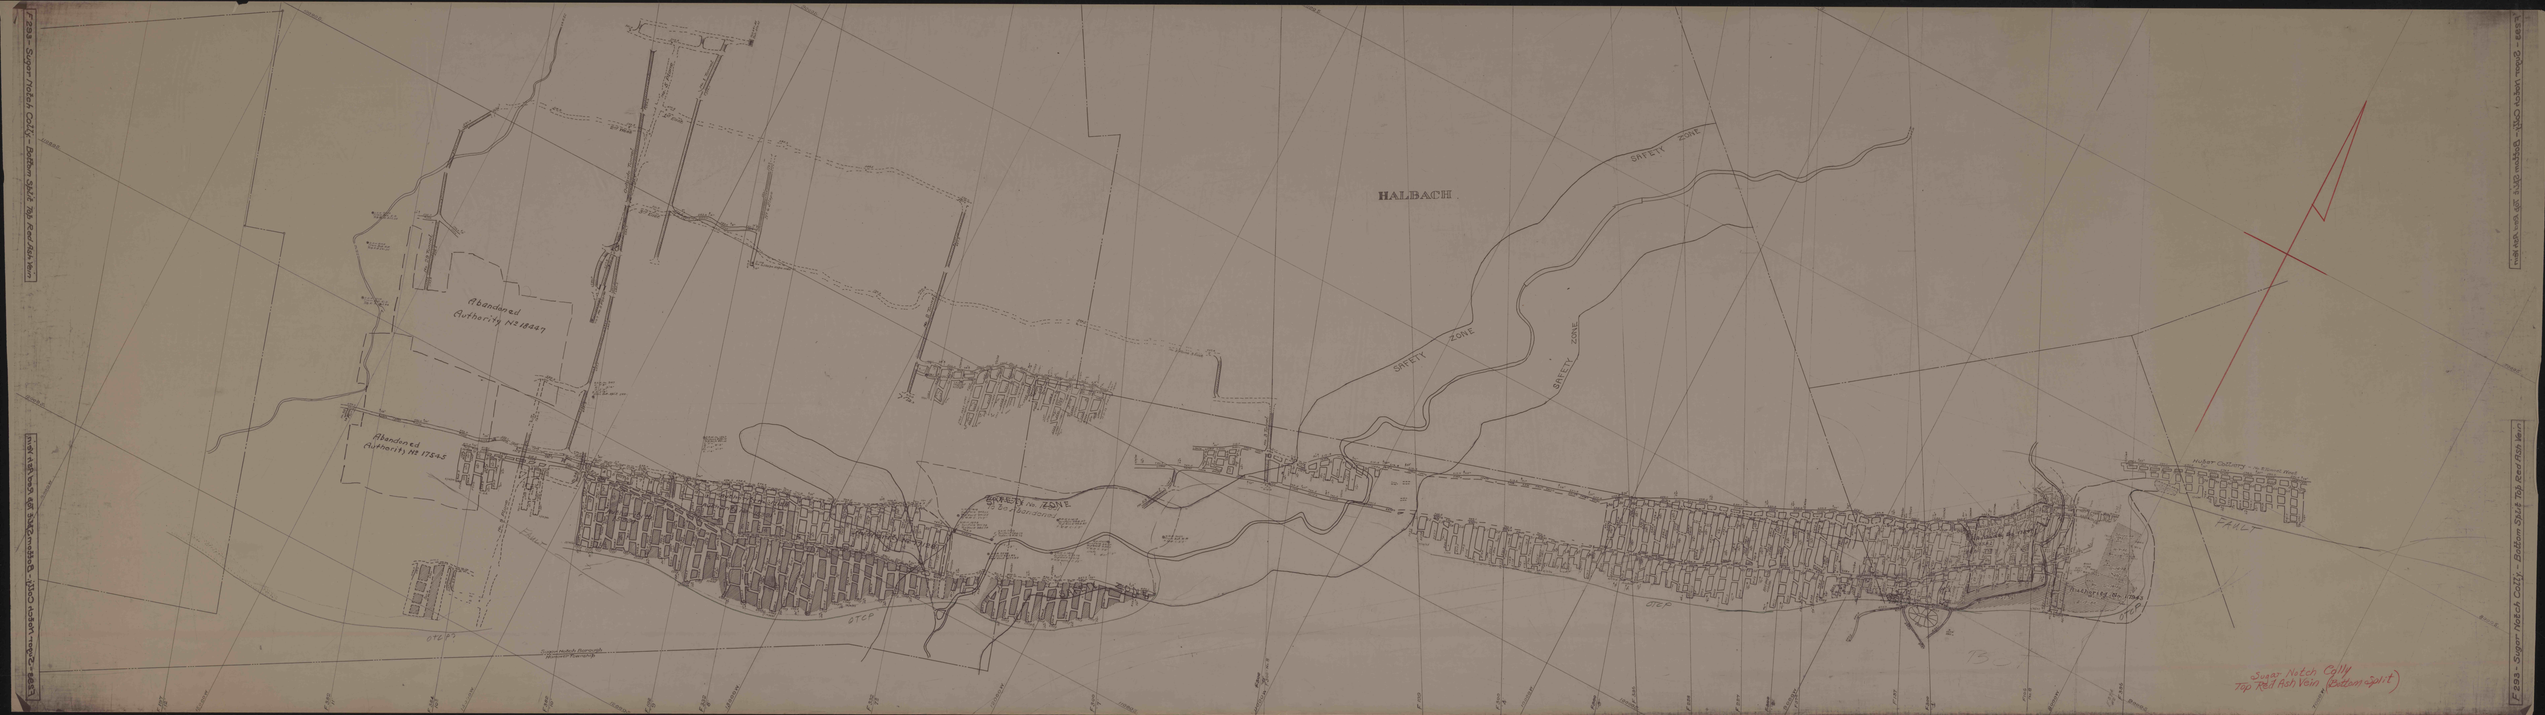
HALBACH
SAFETY ZONE
SAFETY ZONE
SAFETY ZONE
SAFETY ZONE
Abandoned Authority No 18347
Abandoned Authority No 17245
STEP
STEP
STEP
STEP
FAULT
Sugar Notch Colly
Top Rail Roh Vein (Radium Split)