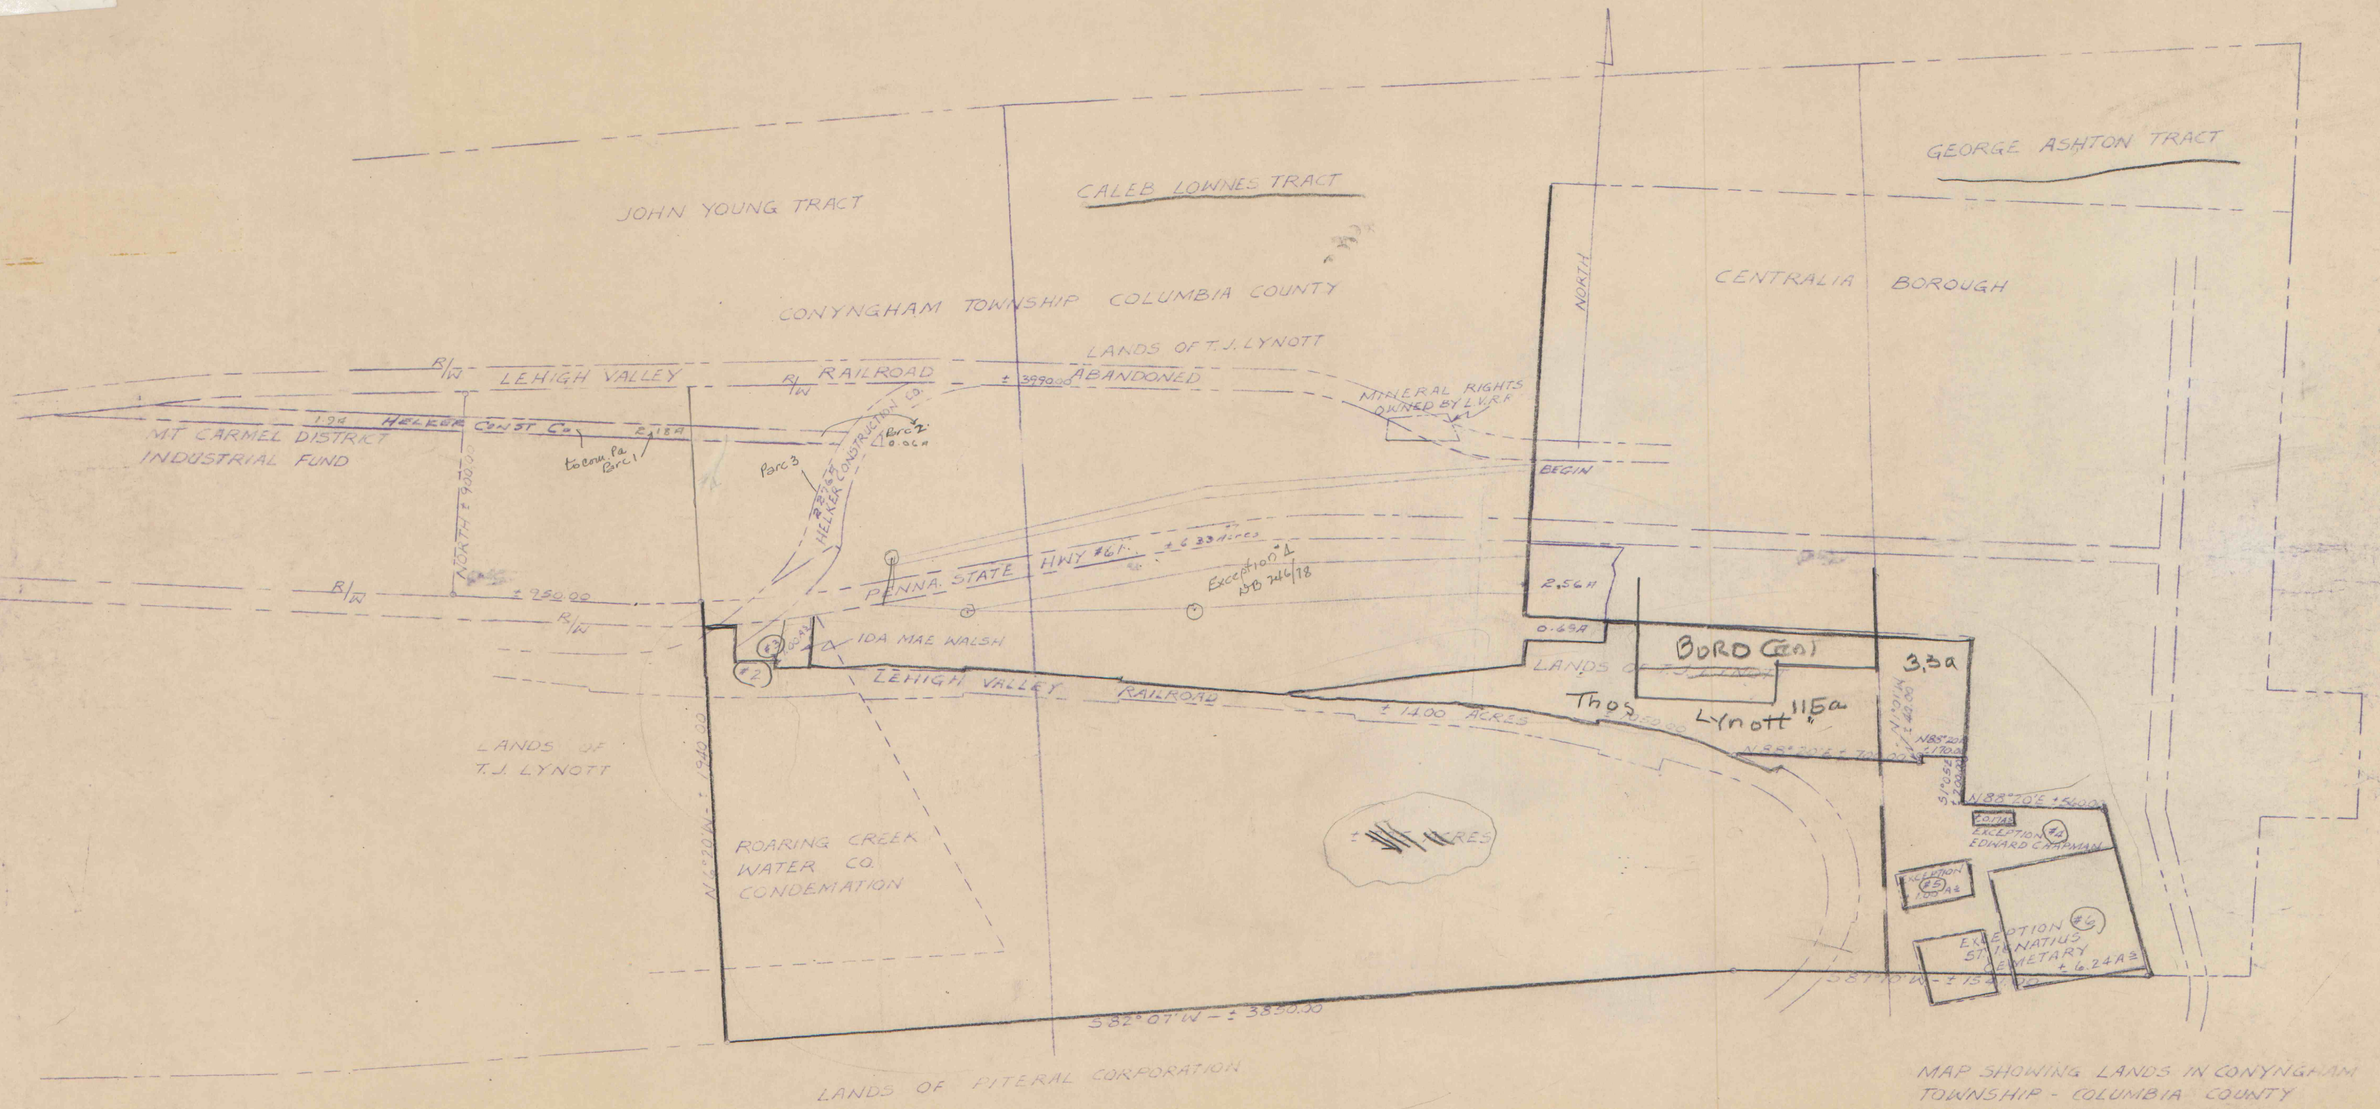

MAP SHOWING LANDS IN CONYNGHAM TOWNSHIP - COLUMBIA COUNTY PENNSYLVANIA

1" = 400'

11-6-67