



ST. CLAIR BOROUGH

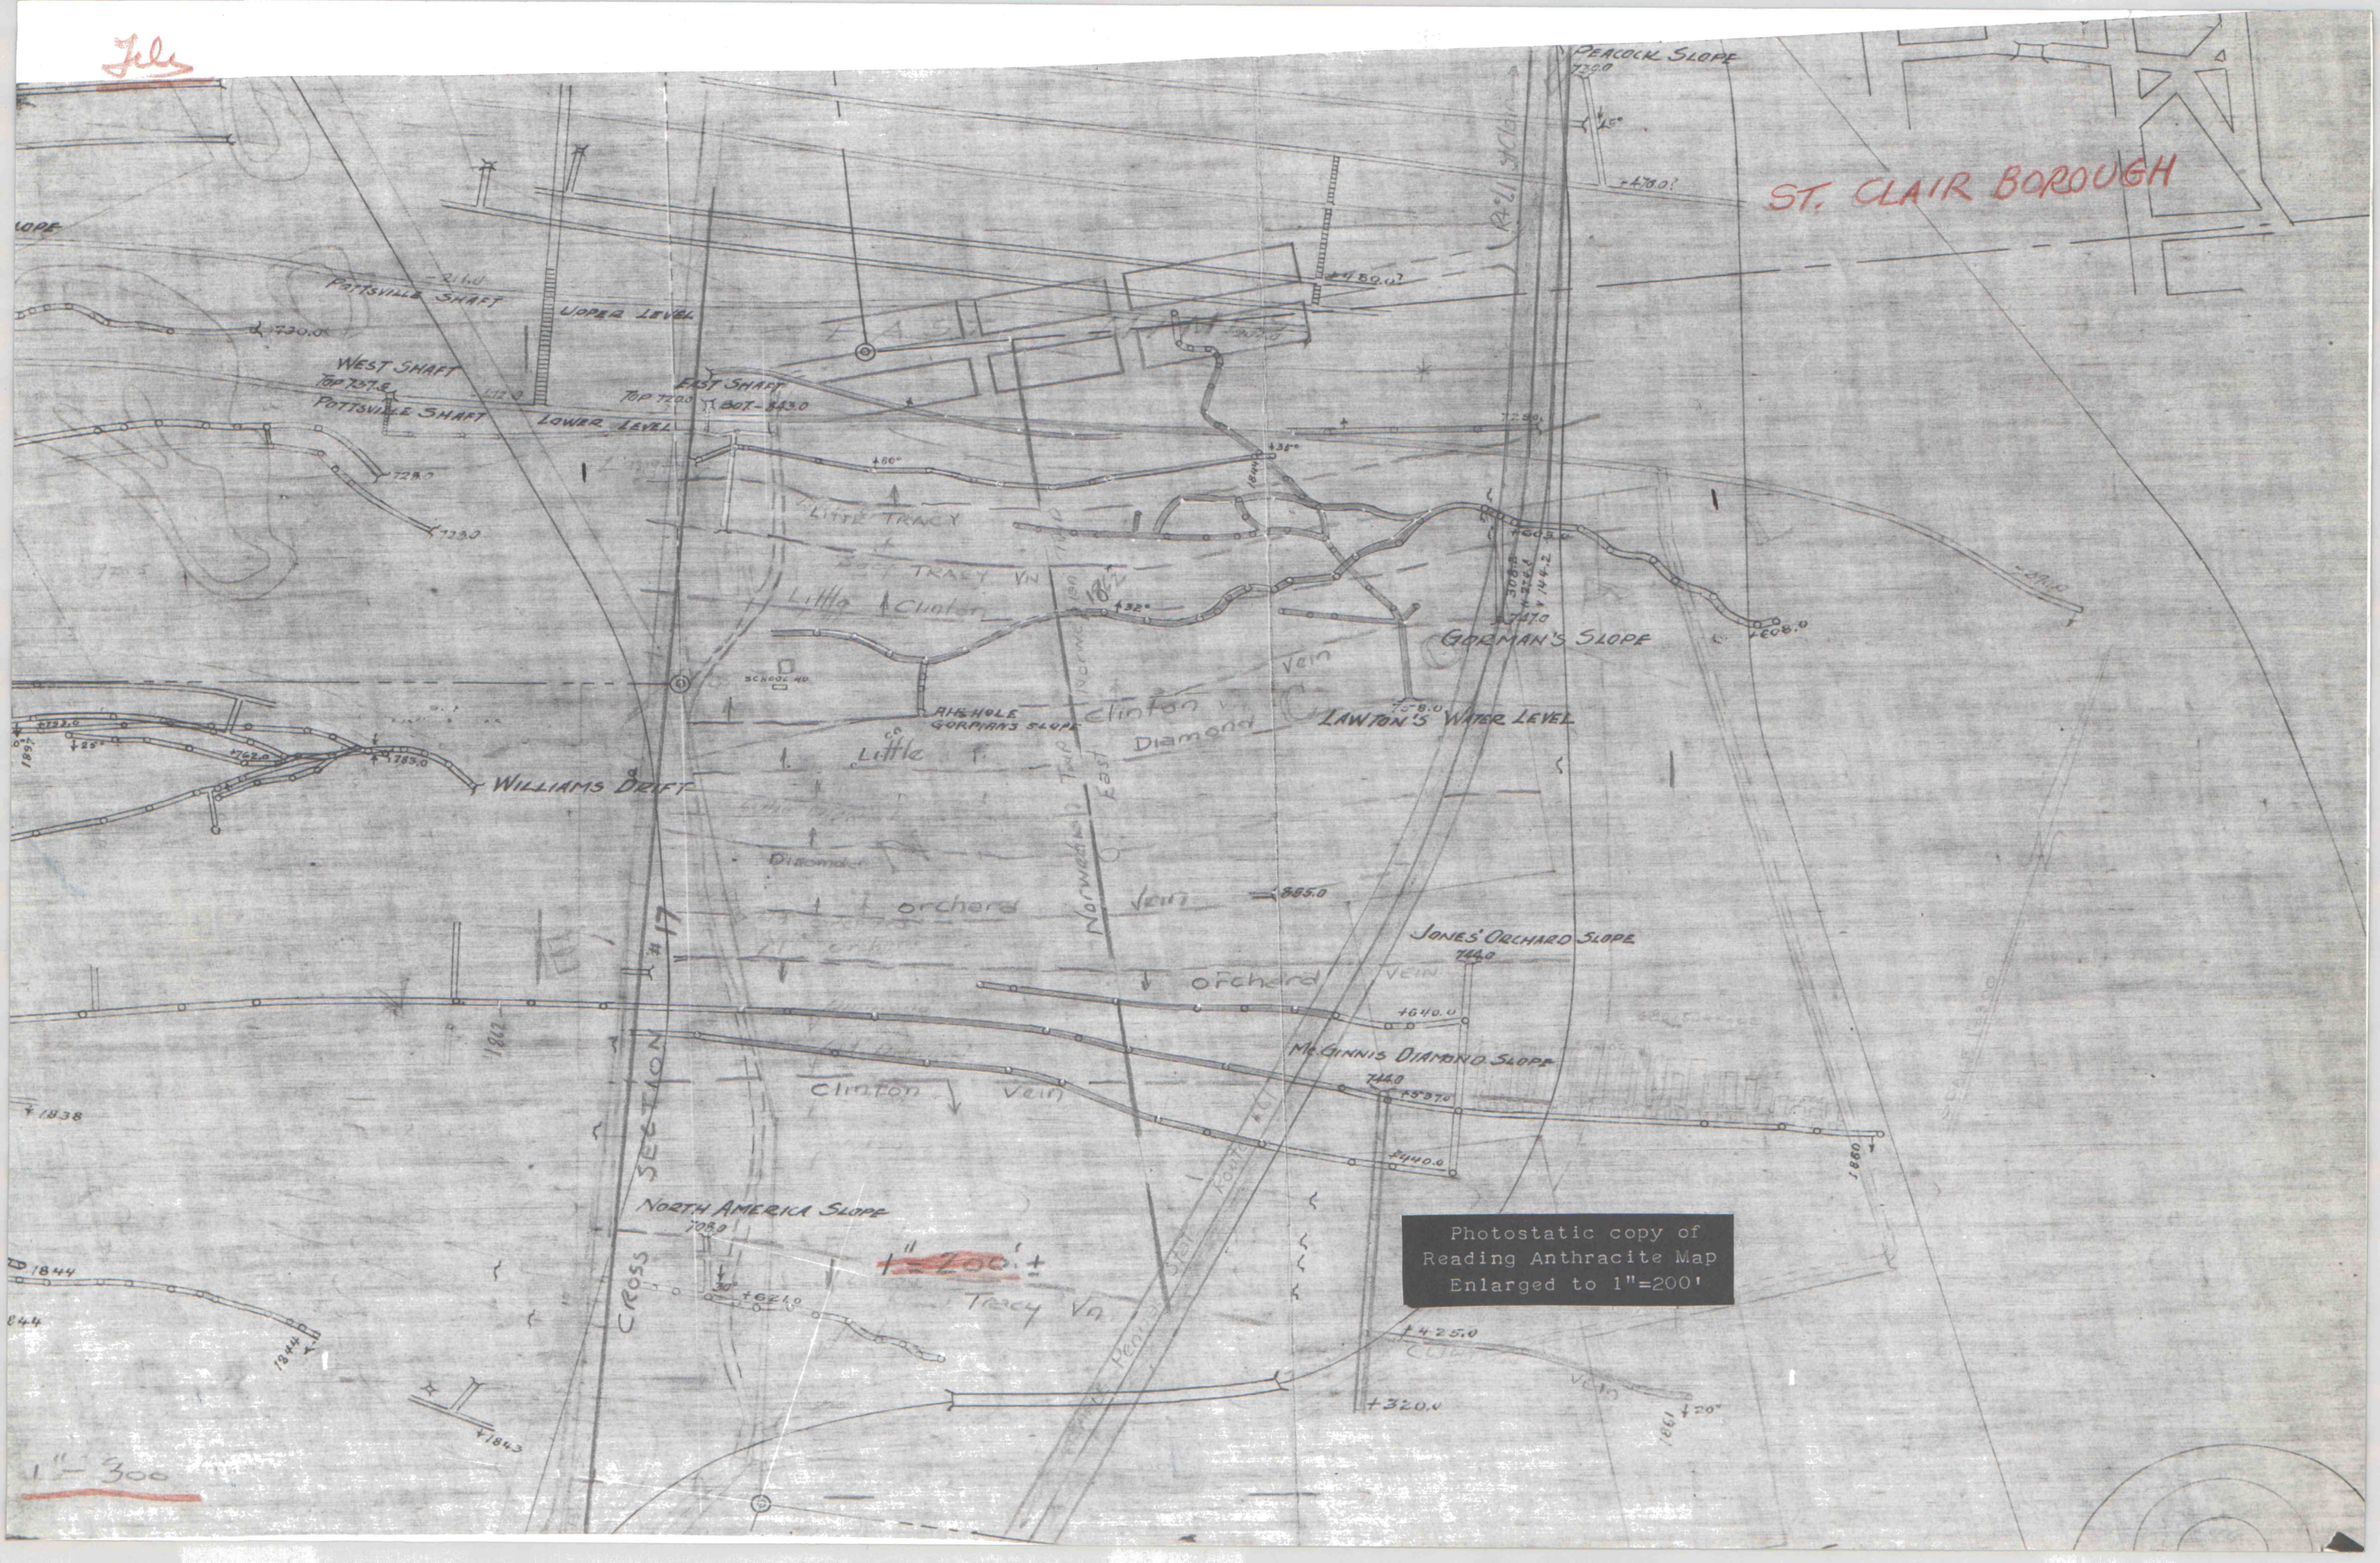

Photostatic copy of
Reading Anthracite Map
Enlarged to 1"=200'