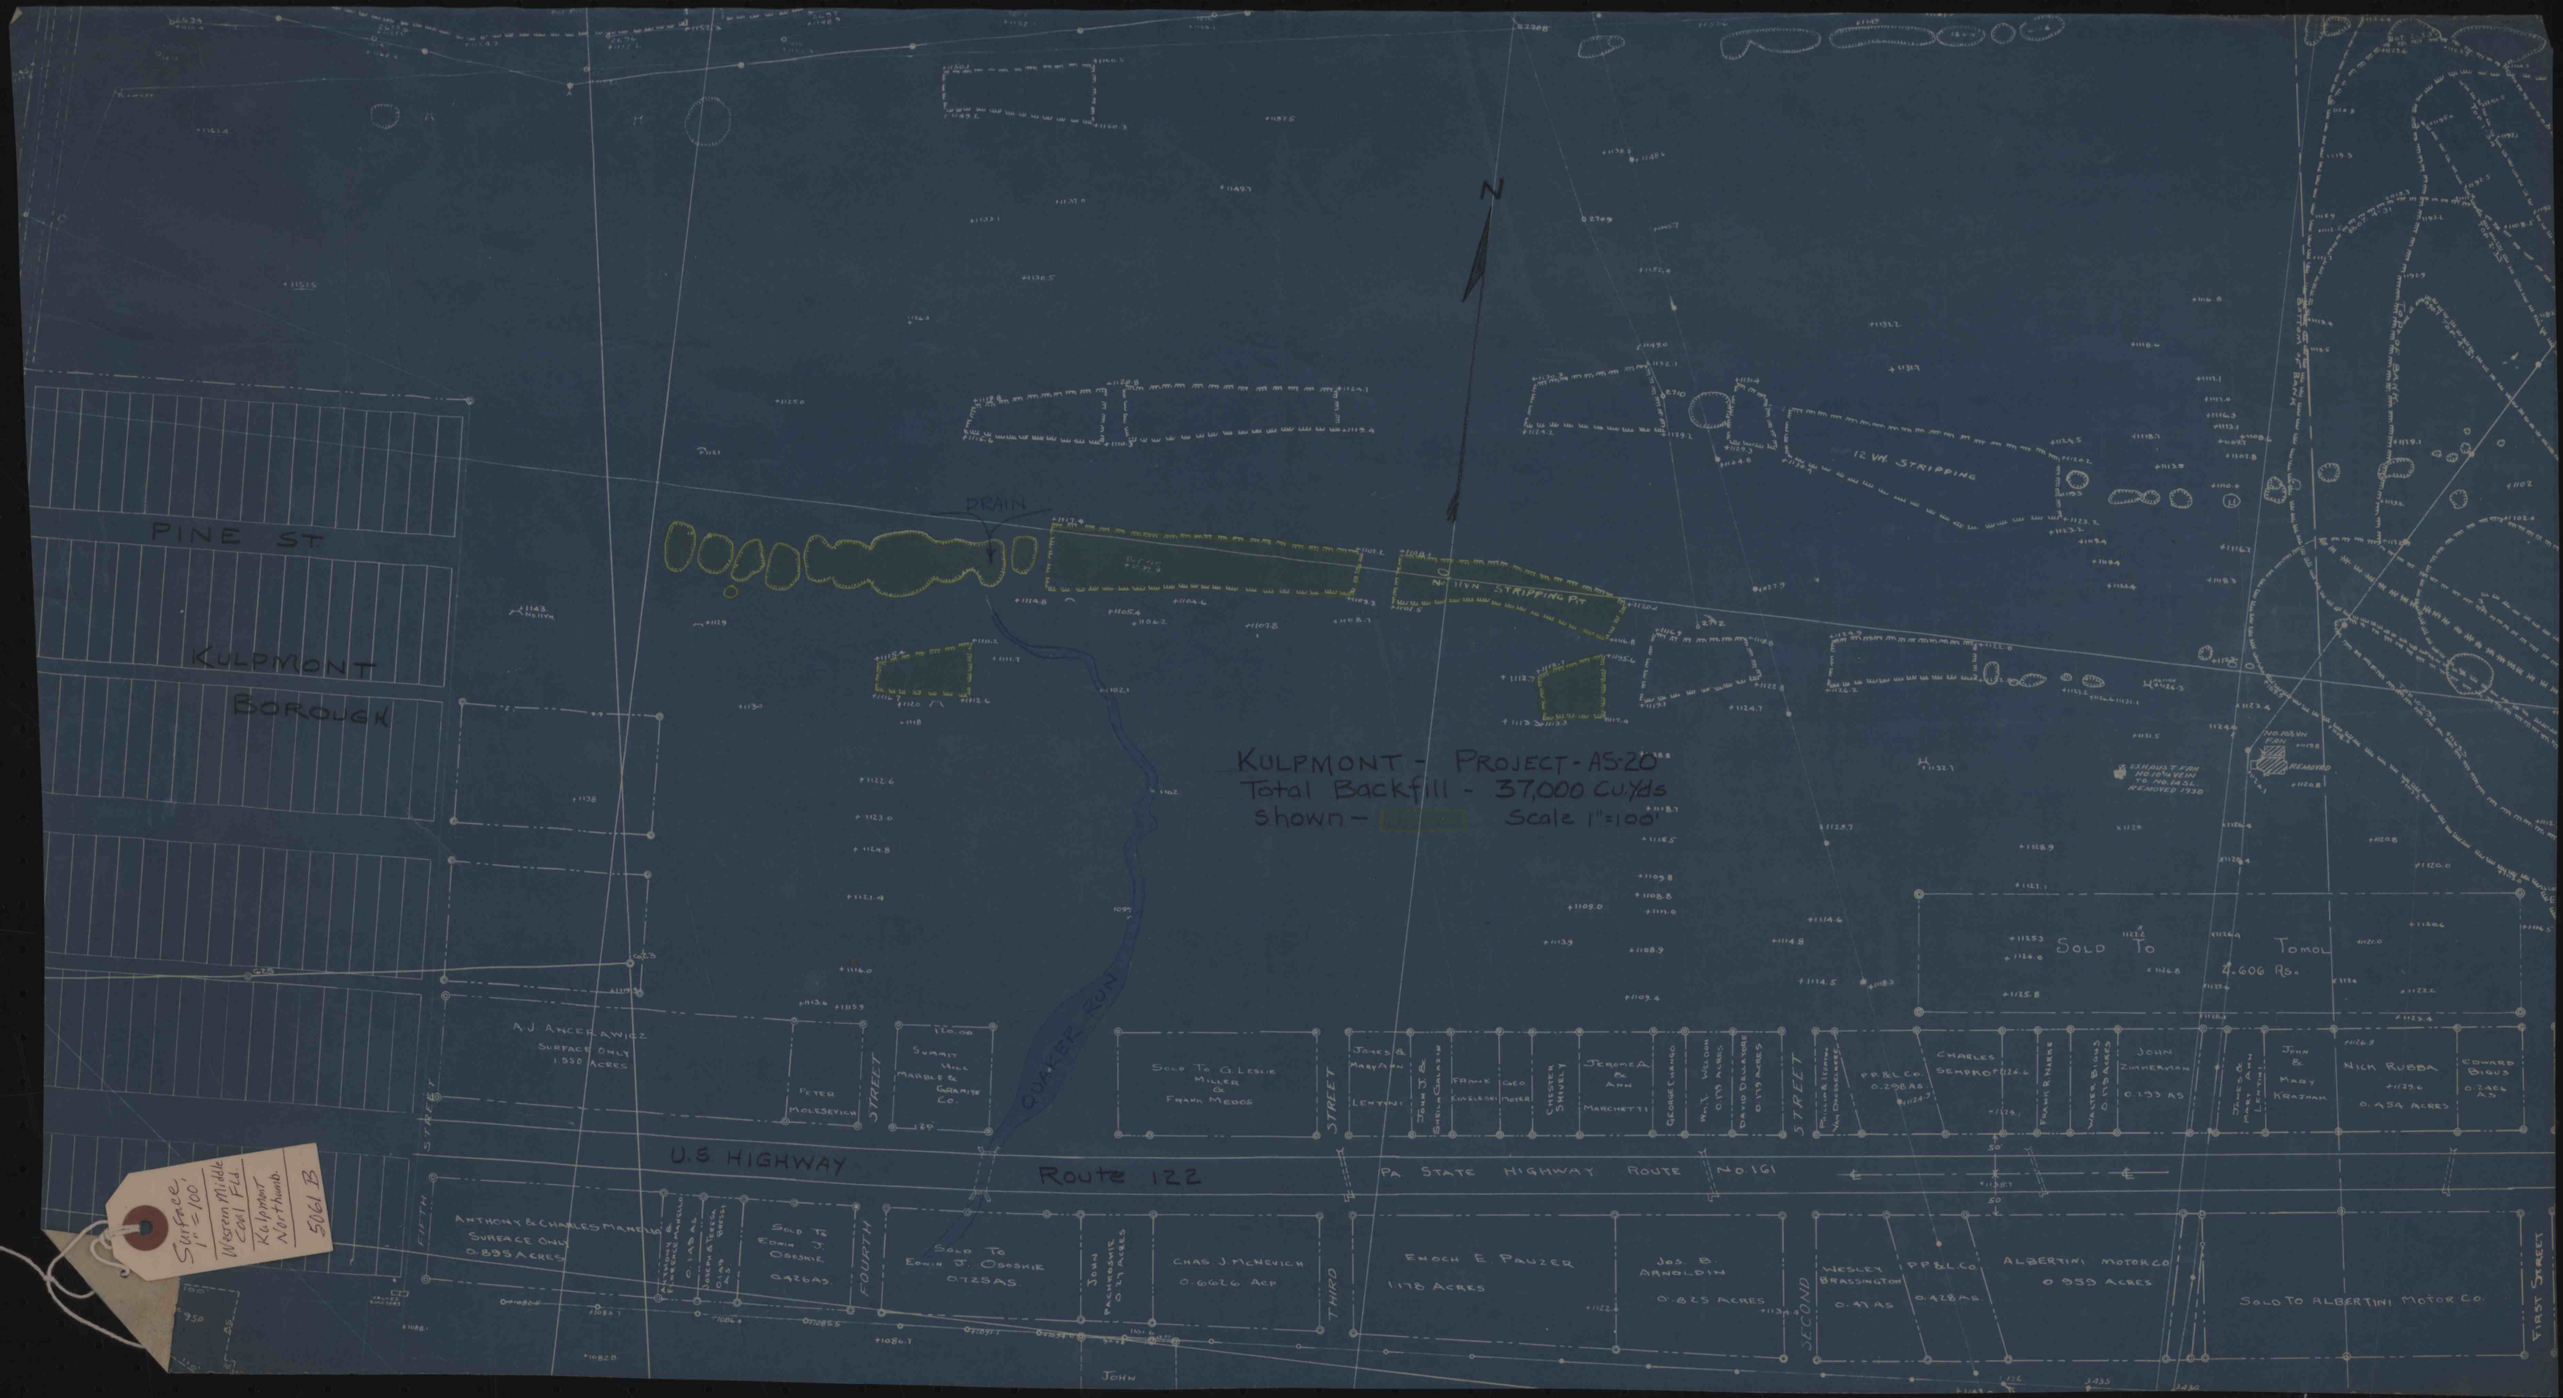

Surface
1" = 100'
Western Middle Coal Fld.
Kulpmont
Northumb.
5061 B