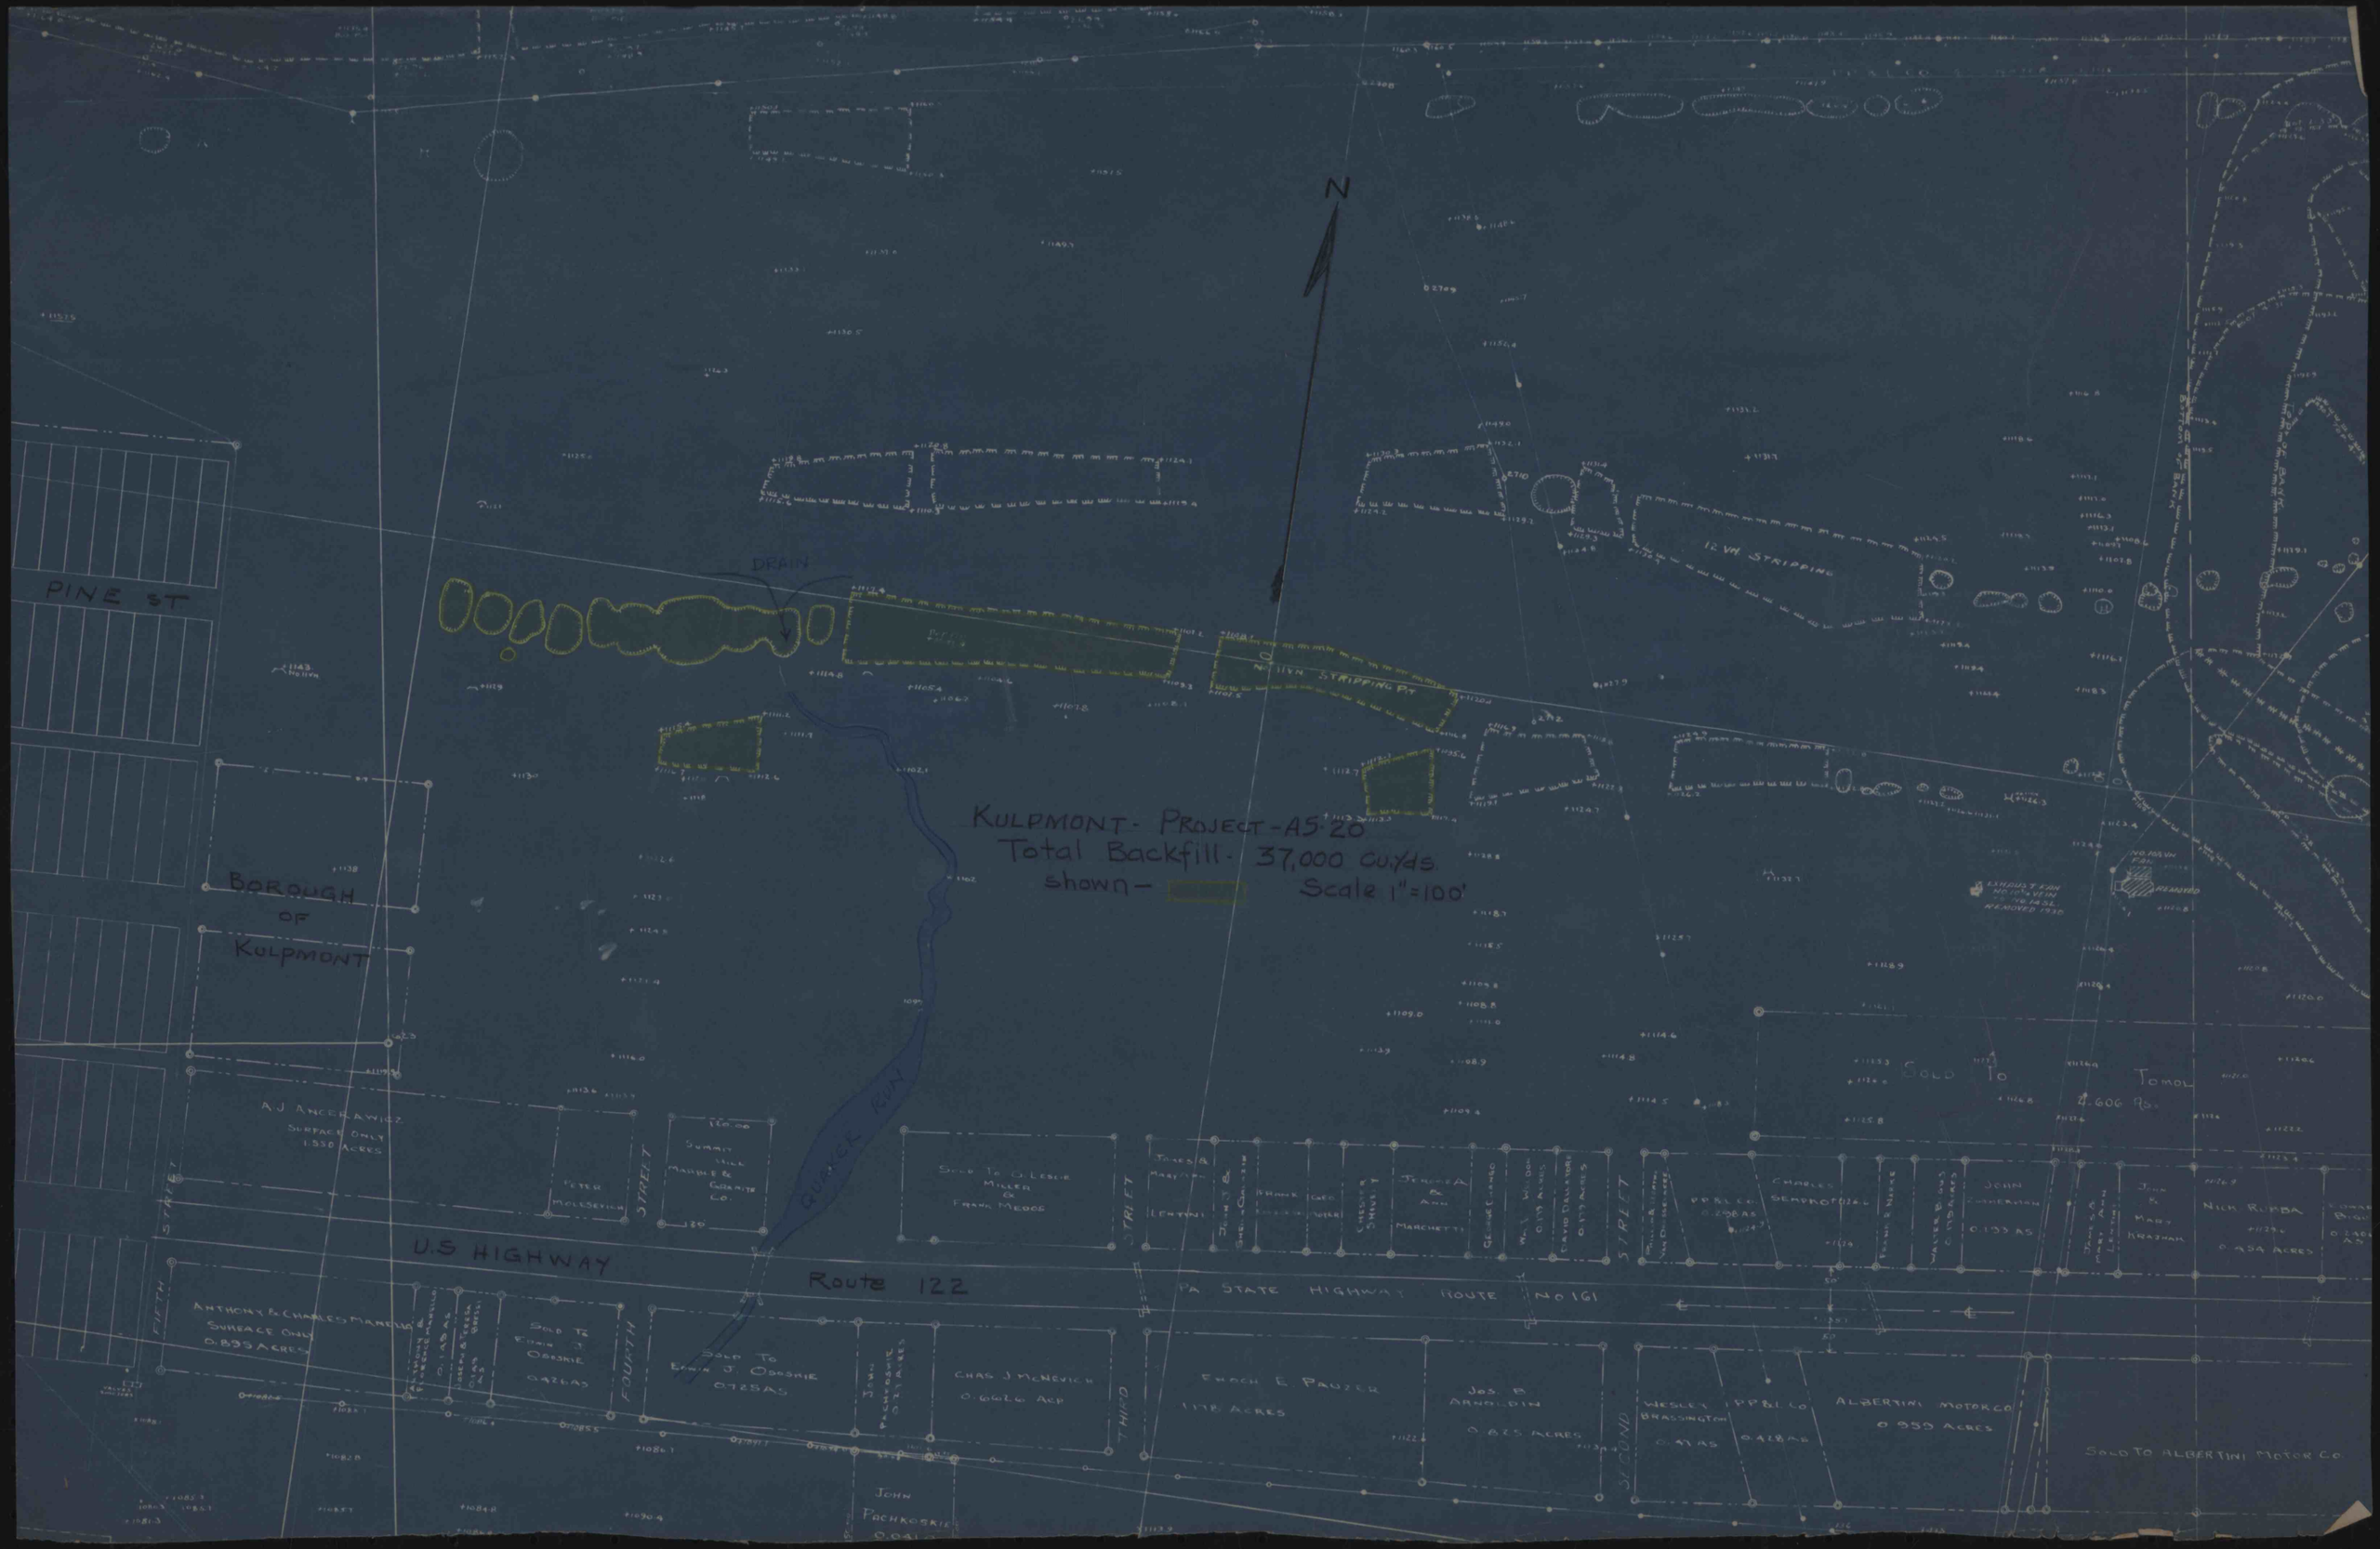
KULPMONT - PROJECT - AS-20
Total Backfill - 37,000 cu.yds.
shown -
Scale 1" = 100'
N
DRAIN
QUAKER RUN
PINE ST
BOROUGH OF KULPMONT
U.S. HIGHWAY Route 122
PA STATE HIGHWAY ROUTE NO 161
FIFTH STREET
FOURTH STREET
THIRD STREET
SECOND STREET
A.J. ANCERAWICZ
SURFACE ONLY
1.550 ACRES
PETER MOLESEVICH
SUMMIT HILL MARBLE & GRANITE CO.
SOLD TO O. LESLIE MILLER & FRANK MEDOS
ANTHONY & CHARLES MANELLA
SURFACE ONLY
0.835 ACRES
SOLD TO ERWIN J. OBOSNIE
0.426 AS
SOLD TO ERWIN J. OBOSNIE
0.725 AS
JOHN PACHKOSKIE
CHAS J. MCNEVICH
0.6626 ACR
ENOCH E. PAUZER
1.118 ACRES
JOS. B. ARNOLDIN
0.625 ACRES
WESLEY BRASSINGTON
0.41 AS
PP&L CO
0.418 AS
ALBERTINI MOTOR CO
0.959 ACRES
SOLD TO ALBERTINI MOTOR CO
SOLD TO TOMOL
4.606 ACS
12 VEIN STRIPPING
11 VEIN STRIPPING PIT
EXHAUST FAN
NO. 10 & 11 VEIN
REMOVED 1950
NO. 10 & 11 VEIN FAN
REMOVED
CHARLES SEMPROTTUCH
JOHN CHERNICH
0.133 AS
NICK RUPPA
0.434 ACRES
JOHN & MARY KRATSMAN
JOHN & MARY SAMS
JOHN & MARY MARCHETTI
JENNIE & ANN MARCHETTI
GEORGE CHIMKO
WM. WILSON
0.139 ACRES
DAVID DALLA VORE
0.139 ACRES
WALTER BLOSS
0.139 ACRES
FRANK & NANCY
FRANK GEORGE
CHESTER SHUE
