


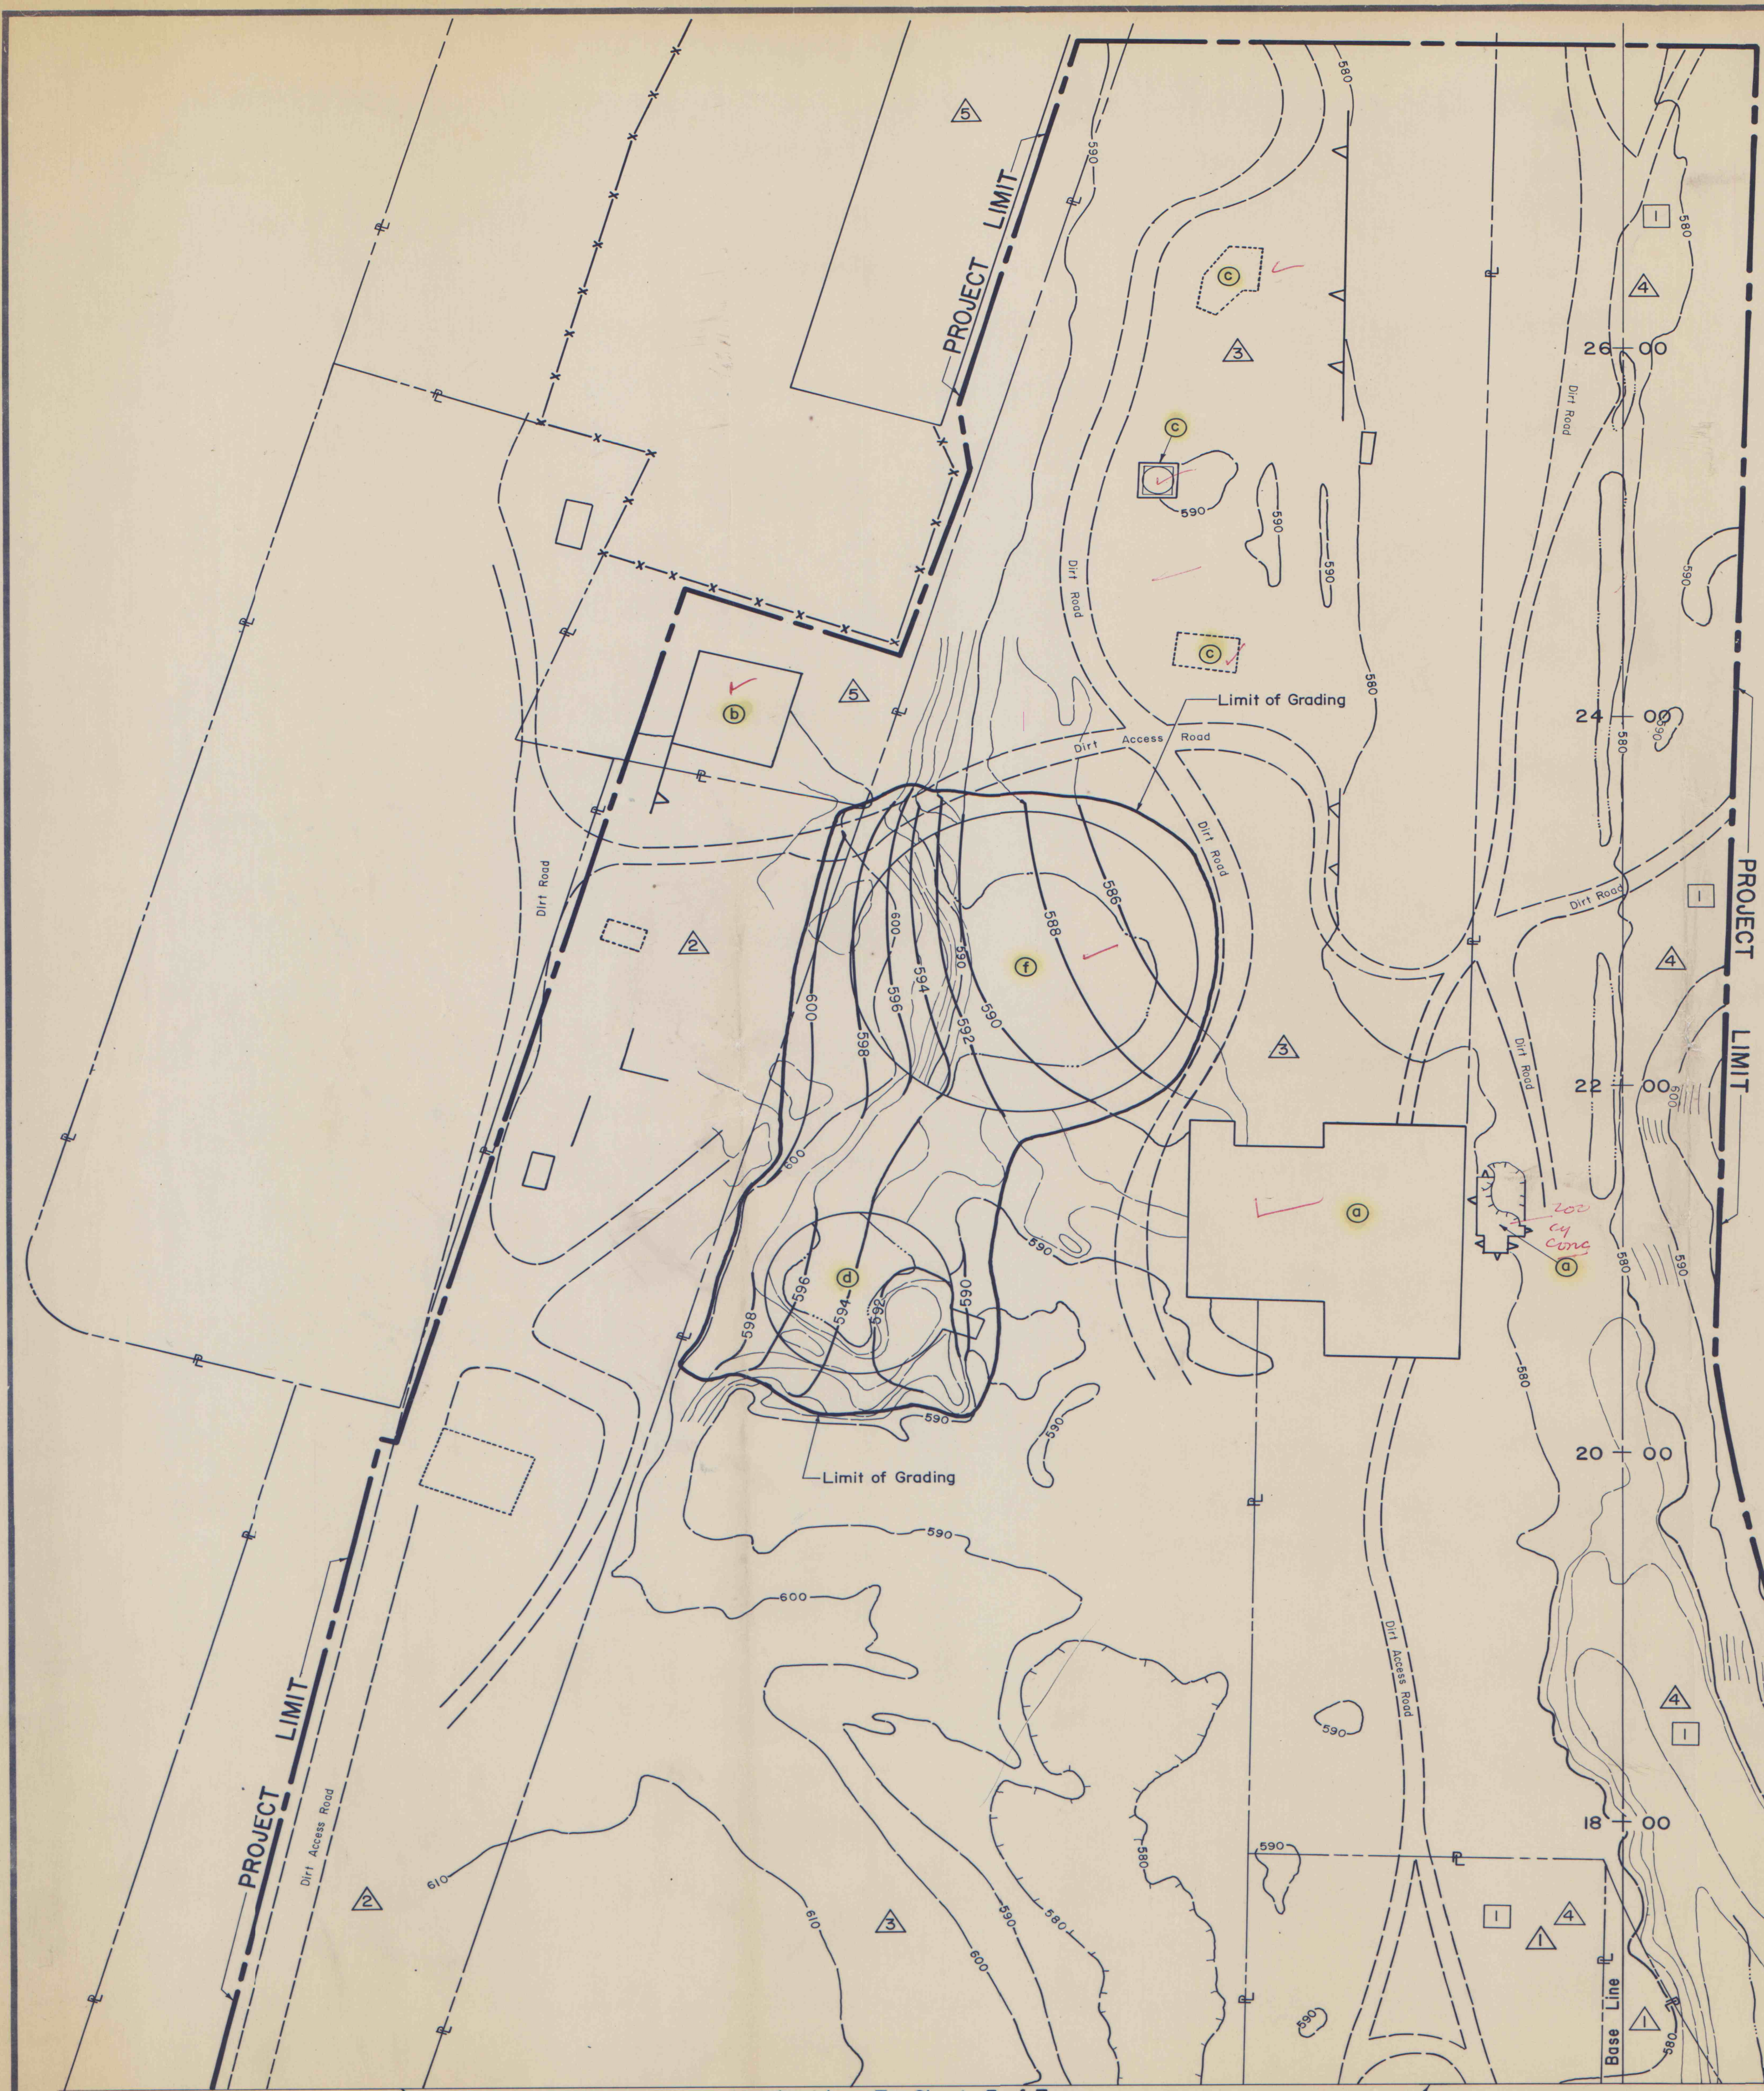

LESSEE
1 Edward Lukashewski
Wapwallopen, PA 18660

MINERAL OWNER
Blue Coal Corporation
101 South Main Street
Ashley, PA 18706

SURFACE OWNERS
1 Blue Coal Corp.
101 South Main Street
Ashley, PA 18706
2 Carrier Coal Enterprises
11 East 44th Street, Suite 1700
New York, NY 10017
3 UGI Corporation
247 Wyoming Avenue
P. O. Box 1389
Kingston, PA 18704-0389
4 Betty Domiano
3 East McClure Avenue
Old Forge, PA 18518
5 Bert & Minnie Mushkin
704 Pine Street
Scranton, PA 18510

LEGEND

9300cy ✓ a Breaker & Adjacent Structure
Reinforced Concrete Construction
45.47' High
To be Removed
120' x 140' x 35' H. Assume 15' H. 120' x 140' x 15' 18" Walls

336 784 b Engine House A
Brick & Concrete Construction
32' High
To be Removed
55' x 55' x 32' 18" Walls 55' x 55' x 7' Thick Base Conc

150 260 c Smoke Stack & Adjacent Structures
Brick & Concrete Construction
130.34' High
To be Removed
20' H Base - Assume 24" Walls x 30' H 50' x 50' x 10' Deep Allow 50' x 50' x 10' Structure 50' x 150' x 10' Deep 18' x 130' x 12" Walls Chimney

471 139 d Settling Basin B
Concrete Construction
7' High
To be Removed
12" Walls FT 9? Assume 2' x 4' FT 9

266 266 e Engine House B
Brick & Concrete Construction
25' High
To be Removed
40' x 60' x 25' H Assume 40' x 60' x 6' Conc

f Settling Basin A
Concrete Construction
18' High
To be Removed
18' x 150' x 18" Walls Footing?


Limit of Grading
Existing 2' Contours
Existing 10' Contours
Proposed Contours
Approximate Property Line

PUBLIC UTILITY ACT 287


—W— Water Line Pennsylvania Gas & Water Company
Wilkes-Barre Center Building
39 Public Square
Wilkes-Barre, PA 18711

NOTE: Contour Interval = 2 ft. Unless Otherwise Noted


SURFACE MAP
Scale: 1 in. = 50 ft.

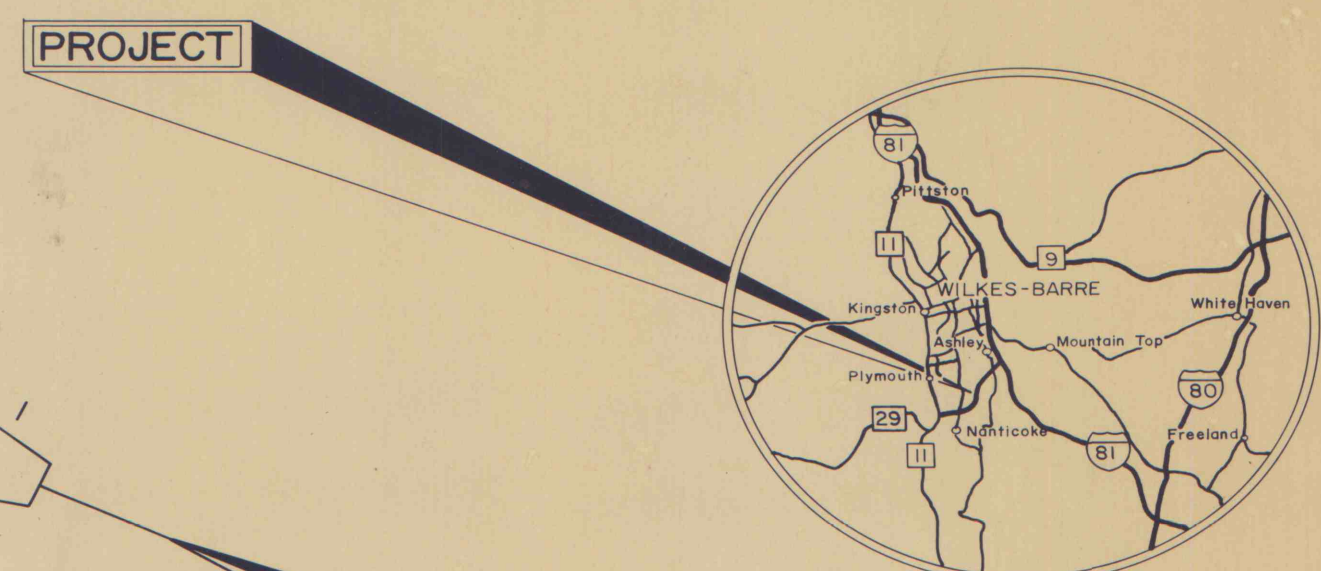

LOCATION MAP
Scale: 1 in. = 9 mi.

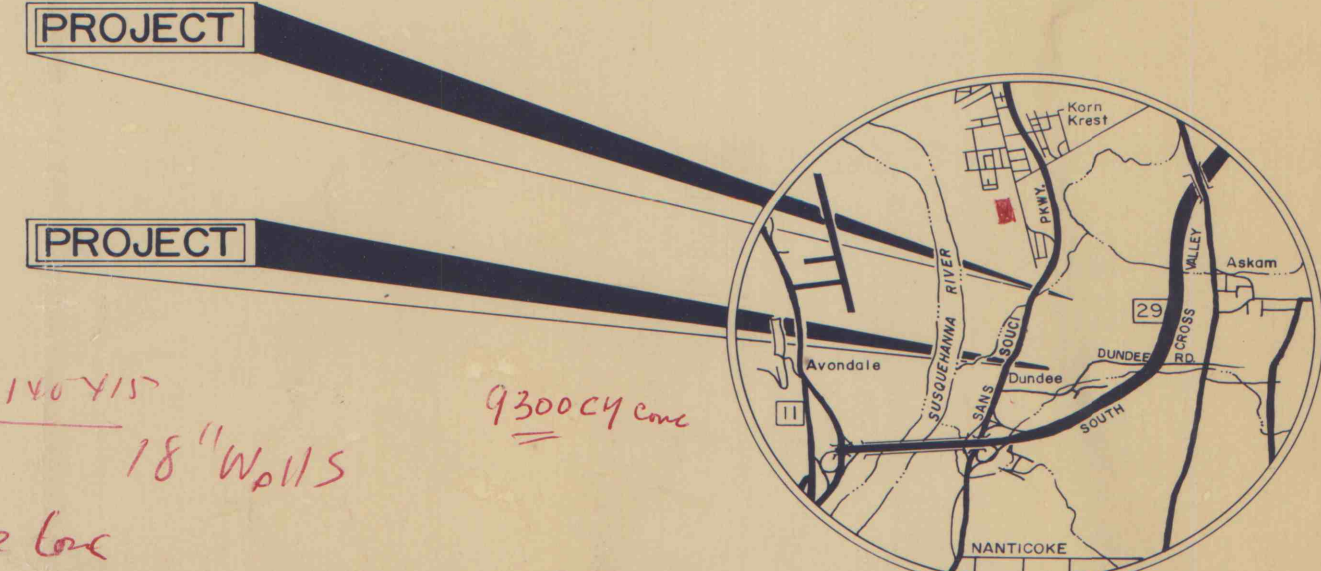

VICINITY MAP
Scale: 1 in. = 1 mi.

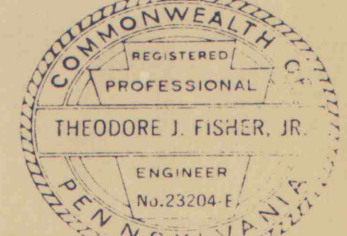NO.	DATE	REVISION	APPR.
SUBMITTED <i>Charles J. Fisher</i> CHIEF, DESIGN SECTION, WILKES-BARRE			
APPROVED <i>Michael R. Ferko</i> DISTRICT ENGINEER, WILKES-BARRE			
APPROVED <i>Richard J. Fisher</i> DIRECTOR, BUREAU OF ABANDONED MINE RECLAMATION			
 			
COMMONWEALTH OF PENNSYLVANIA DEPARTMENT OF ENVIRONMENTAL RESOURCES OFFICE OF RESOURCES MANAGEMENT			
PROJECT NO. OSM 40(2119)101.1			
BACKFILLING STRIP PITS LOOMIS COLLIERY HANOVER TOWNSHIP LUZERNE COUNTY, PENNSYLVANIA			
LOCATION, VICINITY & SURFACE MAPS			
DRAWN BY D.G.D.	DATE June 3, 1987	DRAWING NO. 2 of 7	
CHECKED BY C.L.	SCALE As Shown		

Kim Feather
814-944-5035

TOPOGRAPHY BY:
The EADS Group
EADS
1126 Eighth Avenue
P.O. Box 1887
Altoona, PA 16603
Using Aerial Photography
Dated 3-18-86

ALL DIMENSIONS AND EXISTING
CONDITIONS SHALL BE CHECKED
AND VERIFIED BY CONTRACTOR
AT THE SITE.