


**CROSS SECTION
STA. 10+87**

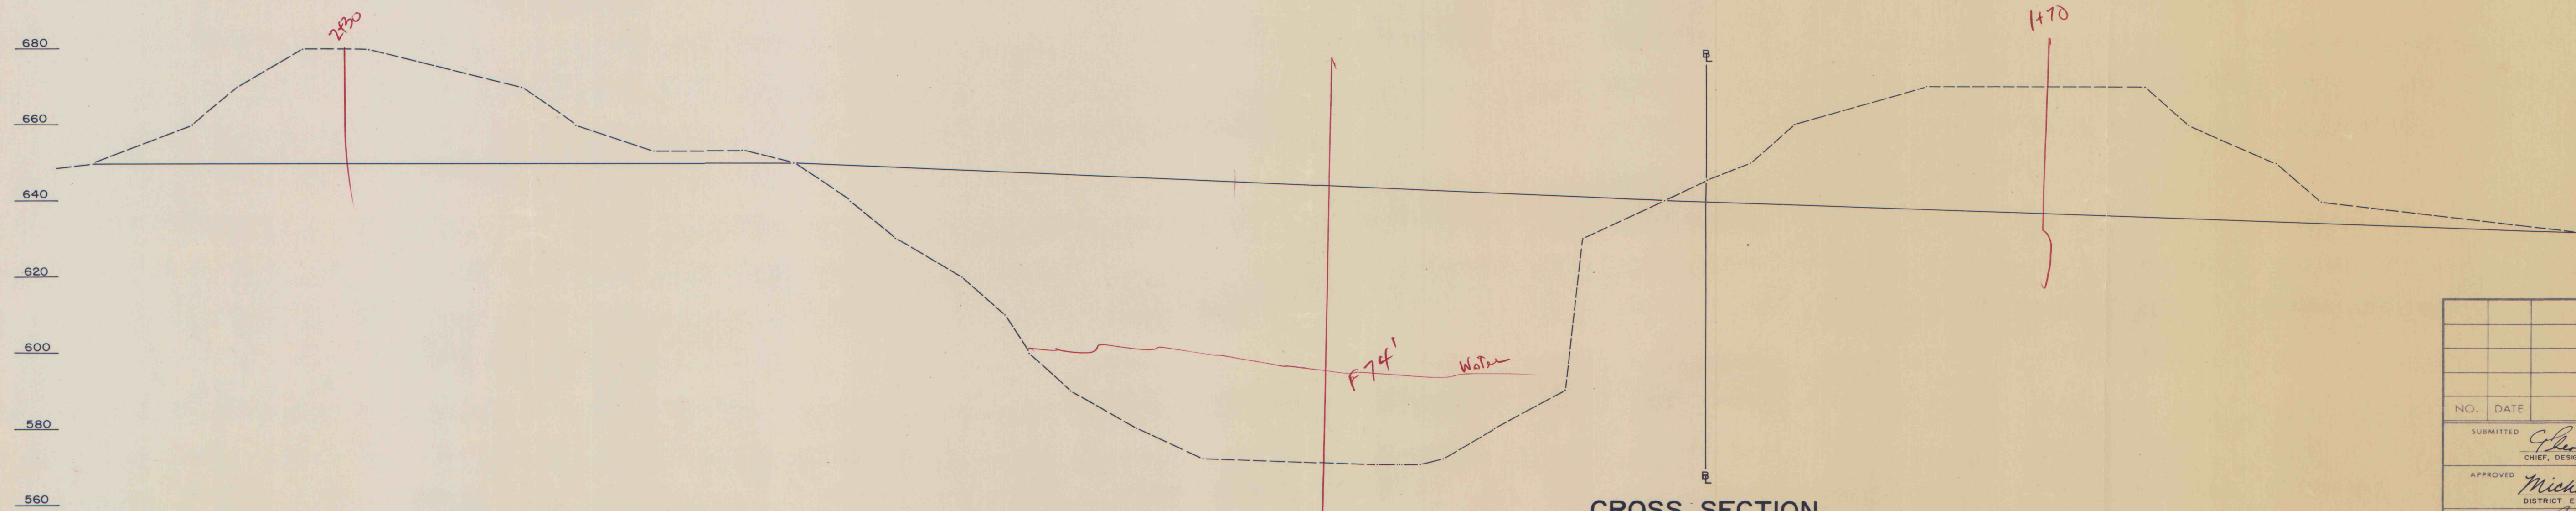

**CROSS SECTION
STA. 7+25**

NOTE: (Cross Sections From Grading Area "A")

NO.	DATE	REVISION	APPR.
SUBMITTED <i>Charles J. Fisher</i> CHIEF, DESIGN SECTION, WILKES-BARRE			
APPROVED <i>Michael R. Ferko</i> DISTRICT ENGINEER, WILKES-BARRE			
APPROVED <i>Richard J. Smith</i> DIRECTOR, BUREAU OF ABANDONED MINE RECLAMATION			
COMMONWEALTH OF PENNSYLVANIA DEPARTMENT OF ENVIRONMENTAL RESOURCES OFFICE OF RESOURCES MANAGEMENT			
PROJECT NO. OSM 40(2119)101.1			
BACKFILLING STRIP PITS LOOMIS COLLIERY HANOVER TOWNSHIP LUZERNE COUNTY, PENNSYLVANIA			
CROSS SECTIONS			
DRAWN BY <i>J.D.F.</i>	DATE June 3, 1987	DRAWING NO.	
CHECKED BY <i>C.L.</i>	SCALE 1 in. = 20 ft.	6 of 7	

ALL DIMENSIONS AND EXISTING
CONDITIONS SHALL BE CHECKED
AND VERIFIED BY CONTRACTOR
AT THE SITE.