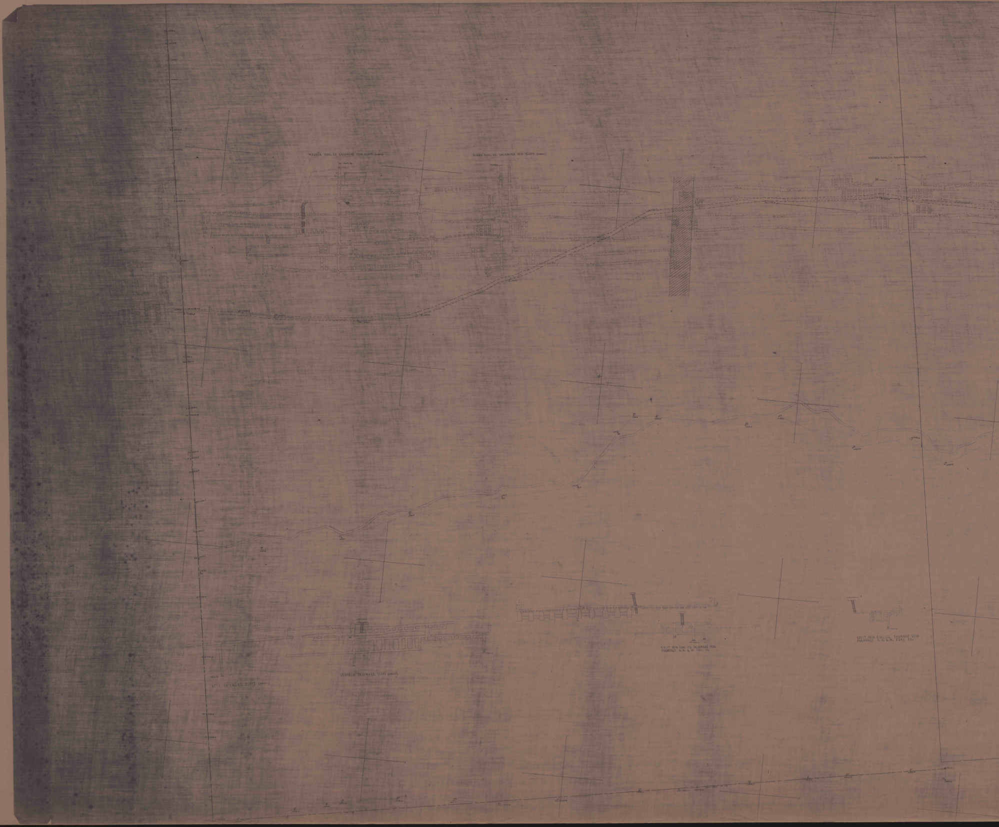
MAURER COAL CO. SKIDMORE VEIN SLOPE (ABAN)
CLARK COAL CO. SKIDMORE VEIN SLOPE (ABAN)
HARNER COAL CO. SKIDMORE VEIN SLOPE
OTTO SKIDMORE SLOPE (ABAN)
SERMAN SKIDMORE SLOPE (ABAN)
SPLIT VEIN COAL CO. SKIDMORE VEIN FORMERLY D. H. & W. COAL CO.
SPLIT VEIN COAL CO. SKIDMORE VEIN FORMERLY D. H. & W. COAL CO.

FIRESIDE MINING CO. SKIDMORE VEIN SLOPE
WAYNE MOYER LYKENS VALLEY TUNNEL
J. & C. COAL CO. SKIDMORE VEIN SLOPE

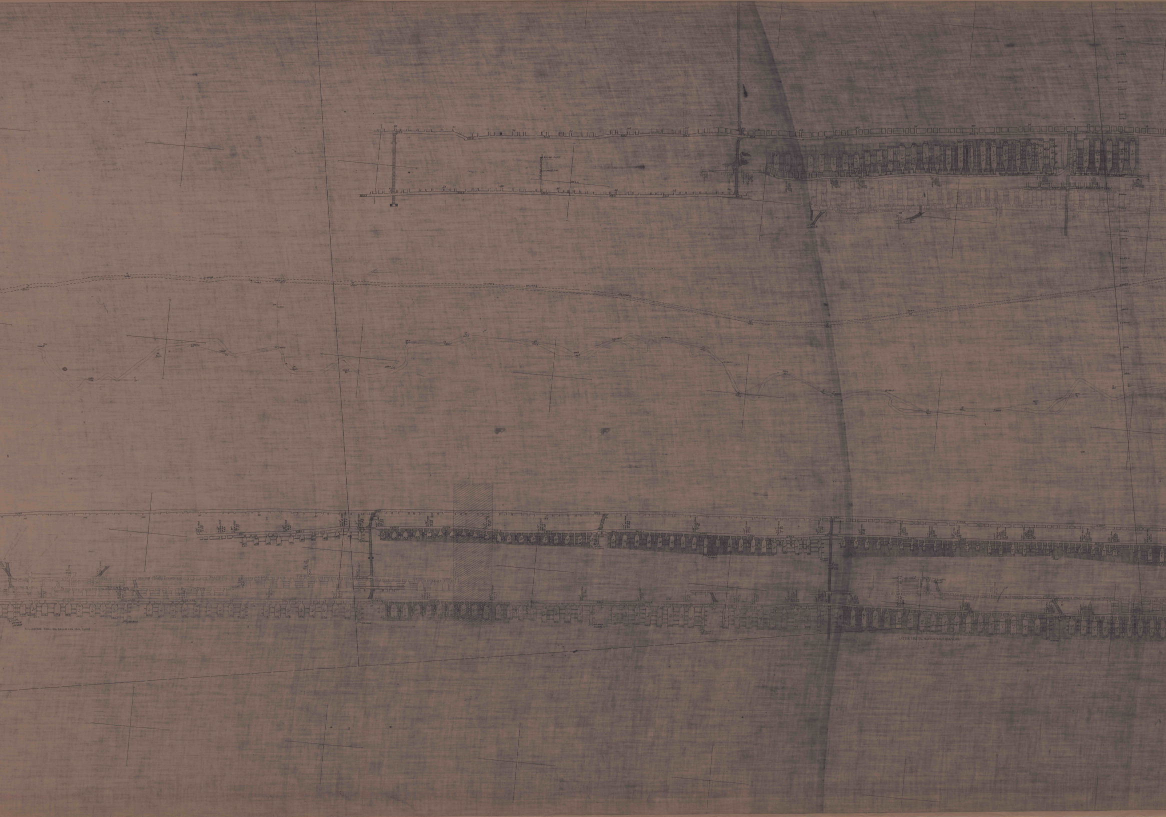
WILLIAMSON COAL CO. SKIDMORE 15TH SLOPE
HATTER COAL CO. MIDDLE SPLIT NEW SLOPE

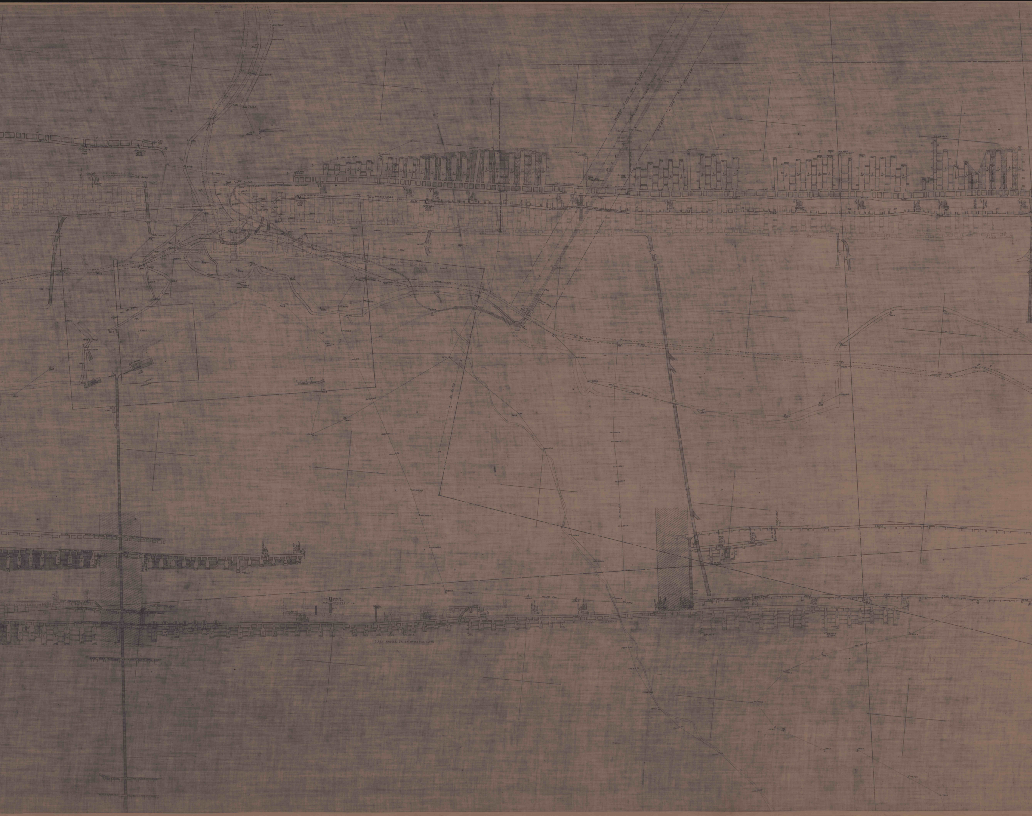

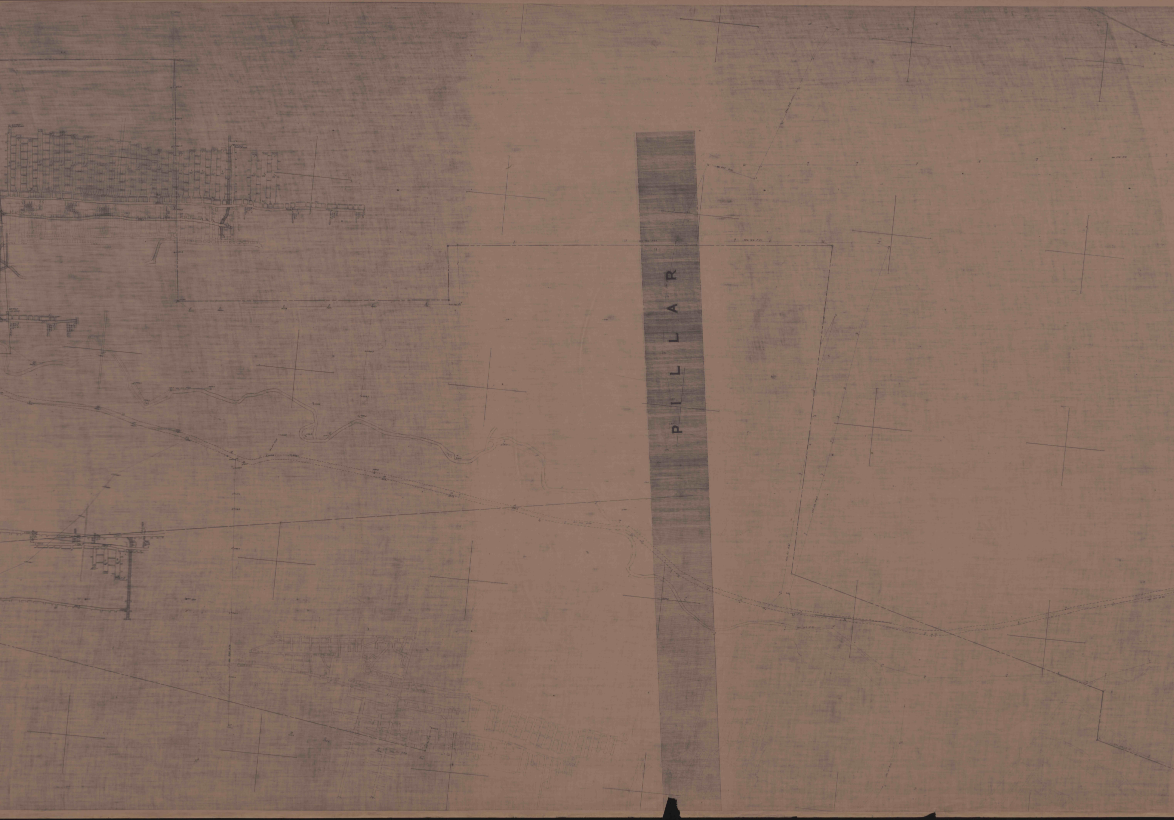
PILLAR