


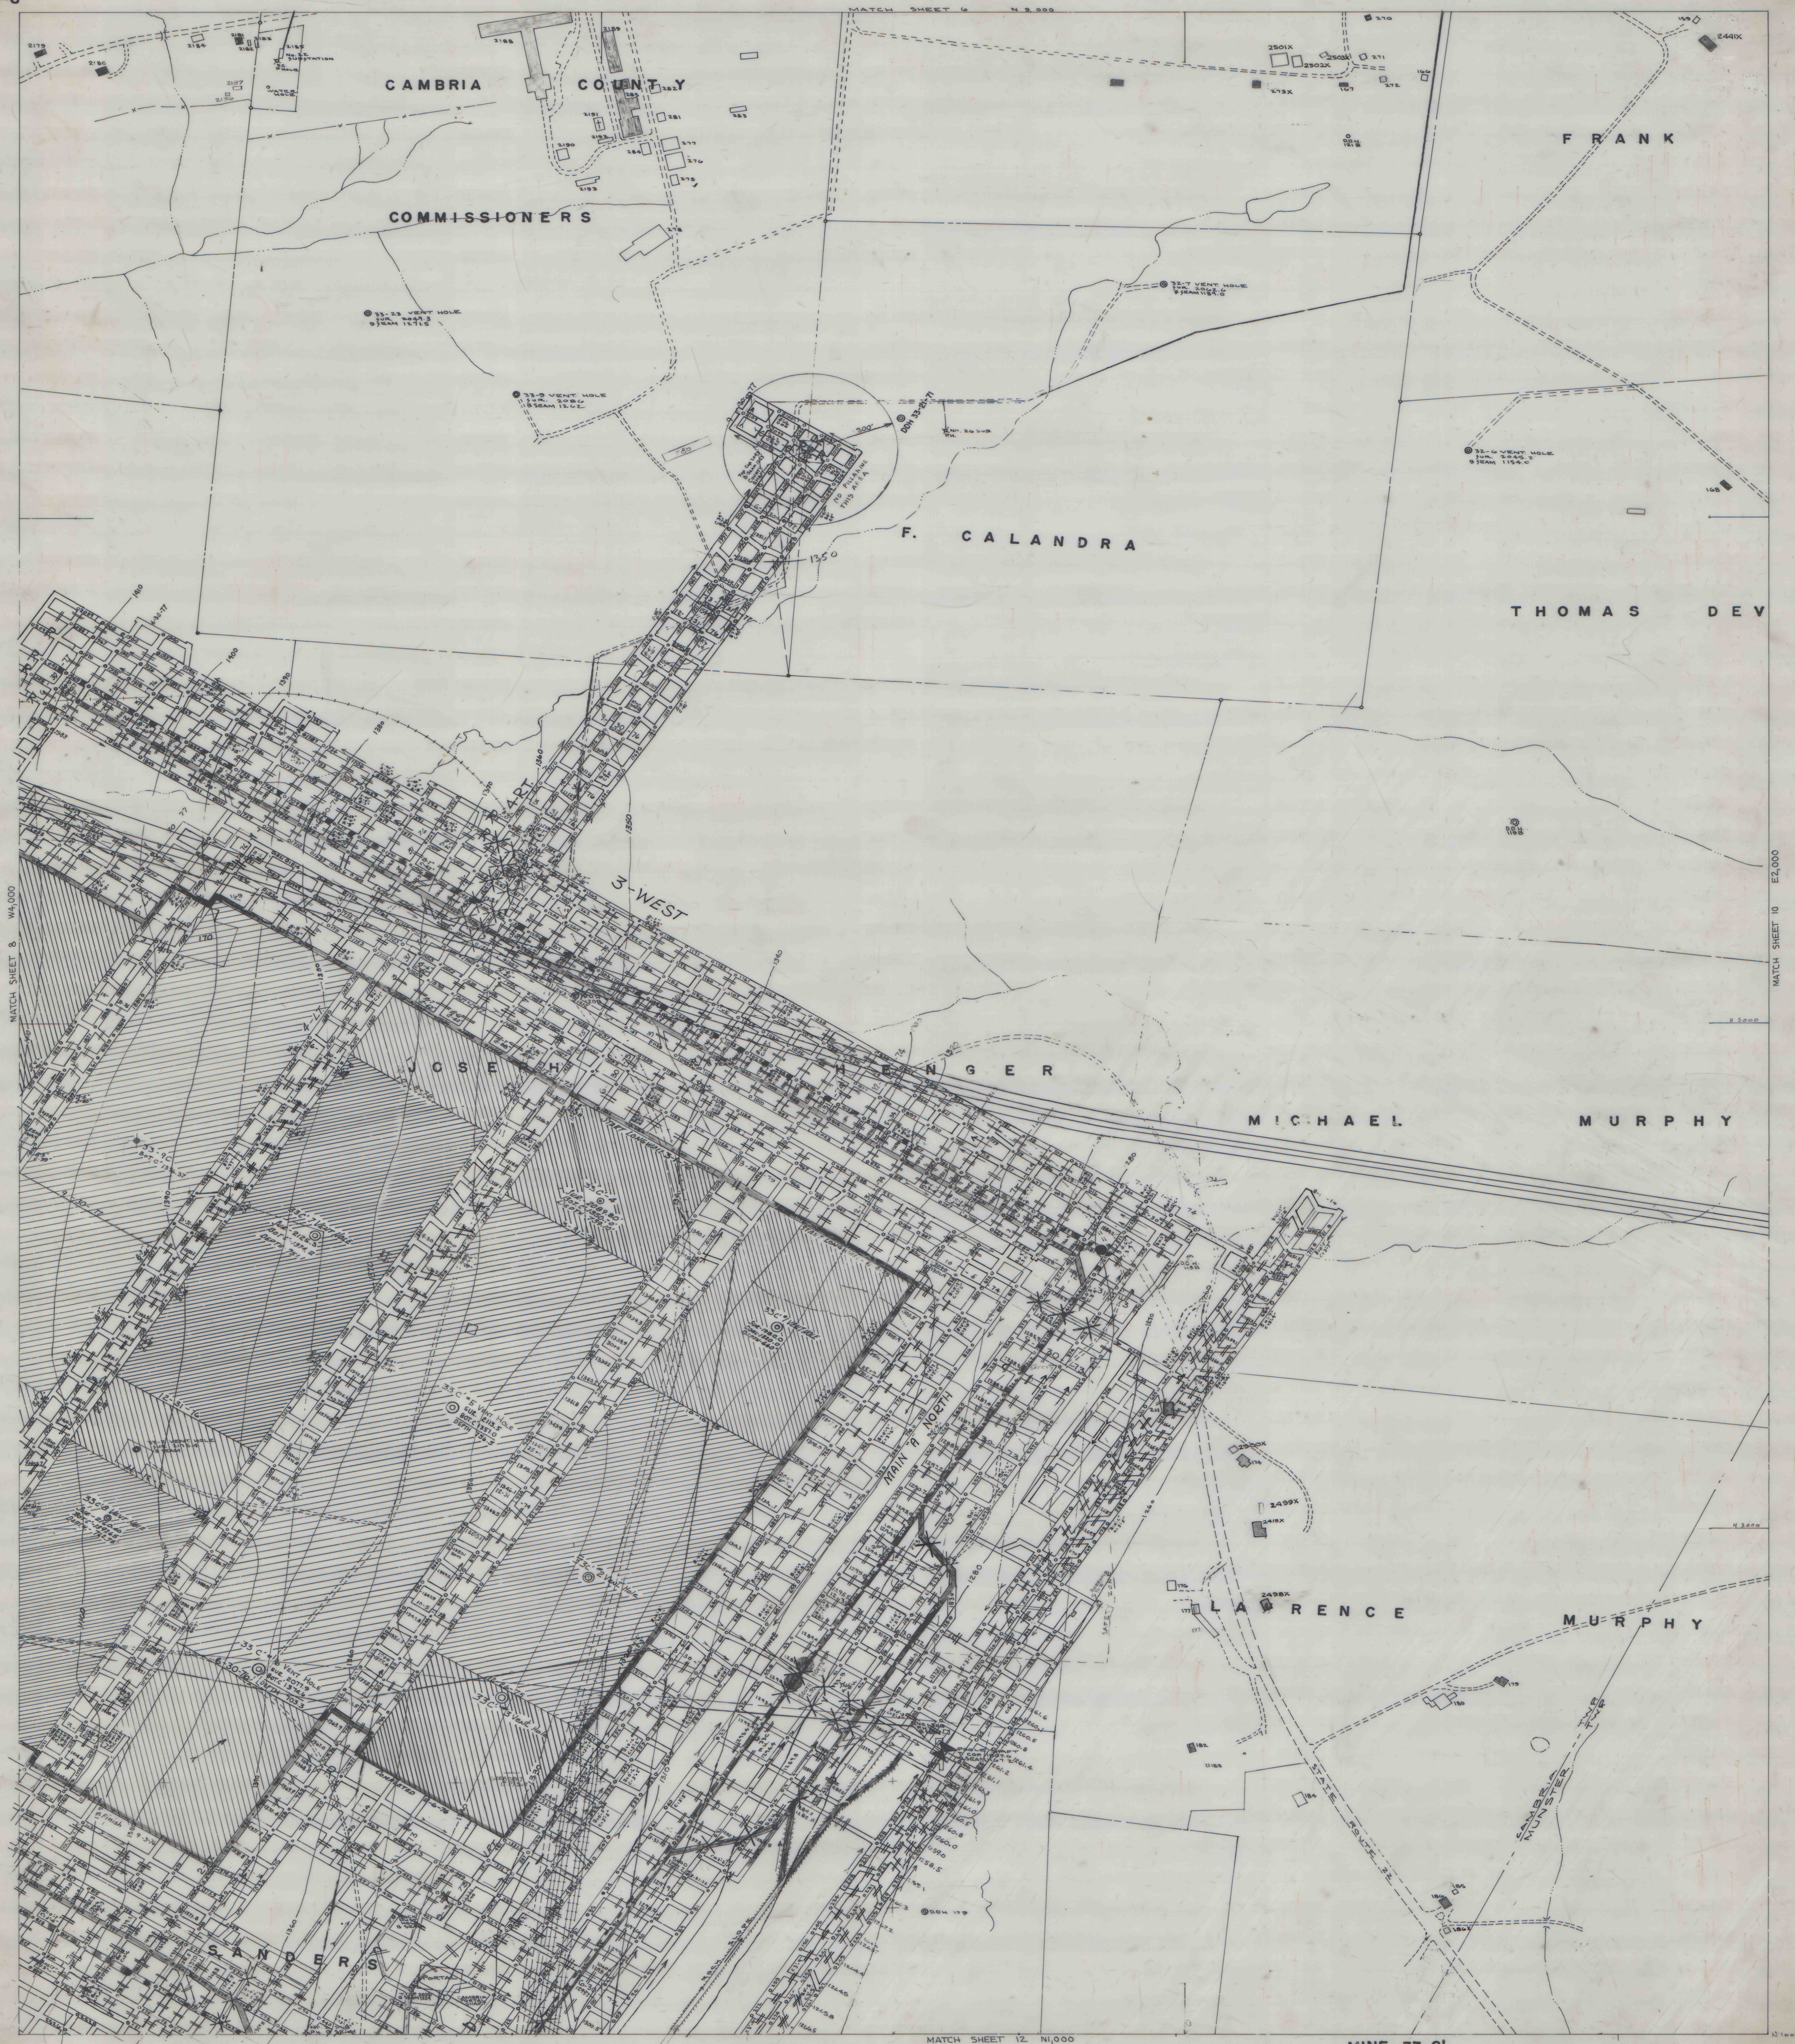

MATCH SHEET 8 WA 000

MATCH SHEET 10 E2 000

MATCH SHEET 12 N1 000

MINE 33-C

9-C