


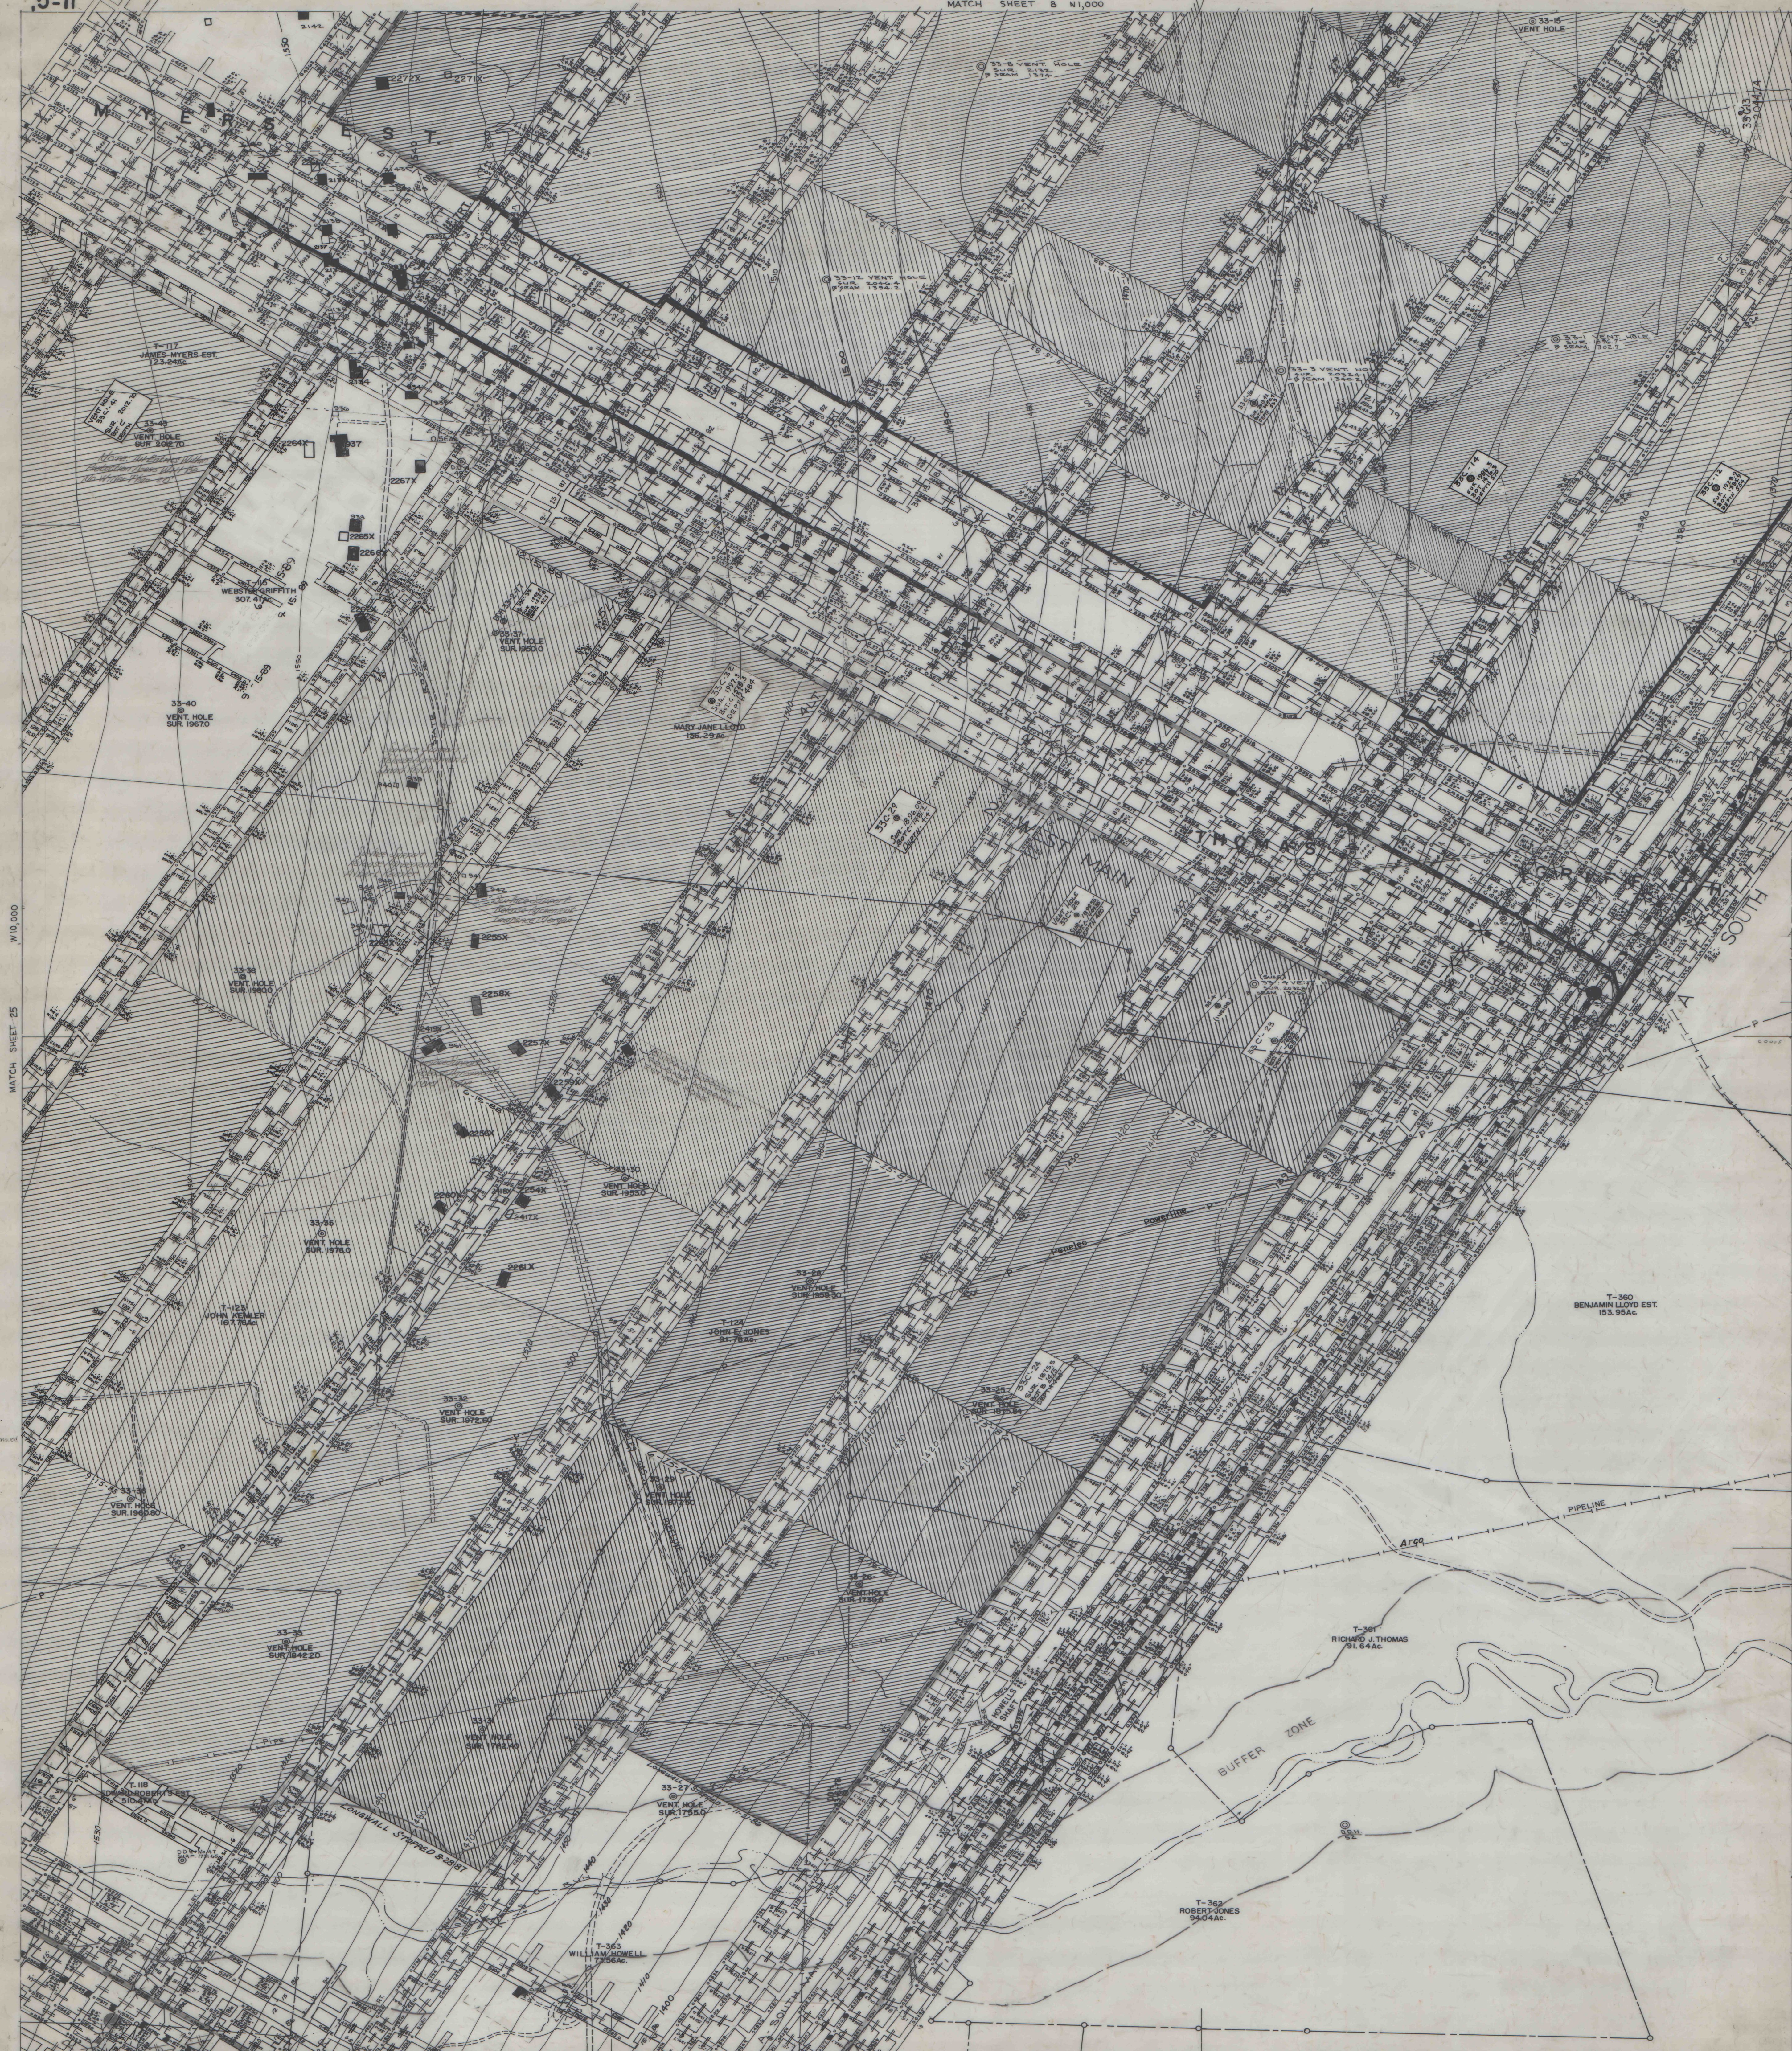

MATCH SHEET 25

MATCH SHEET 12 N4,000

