


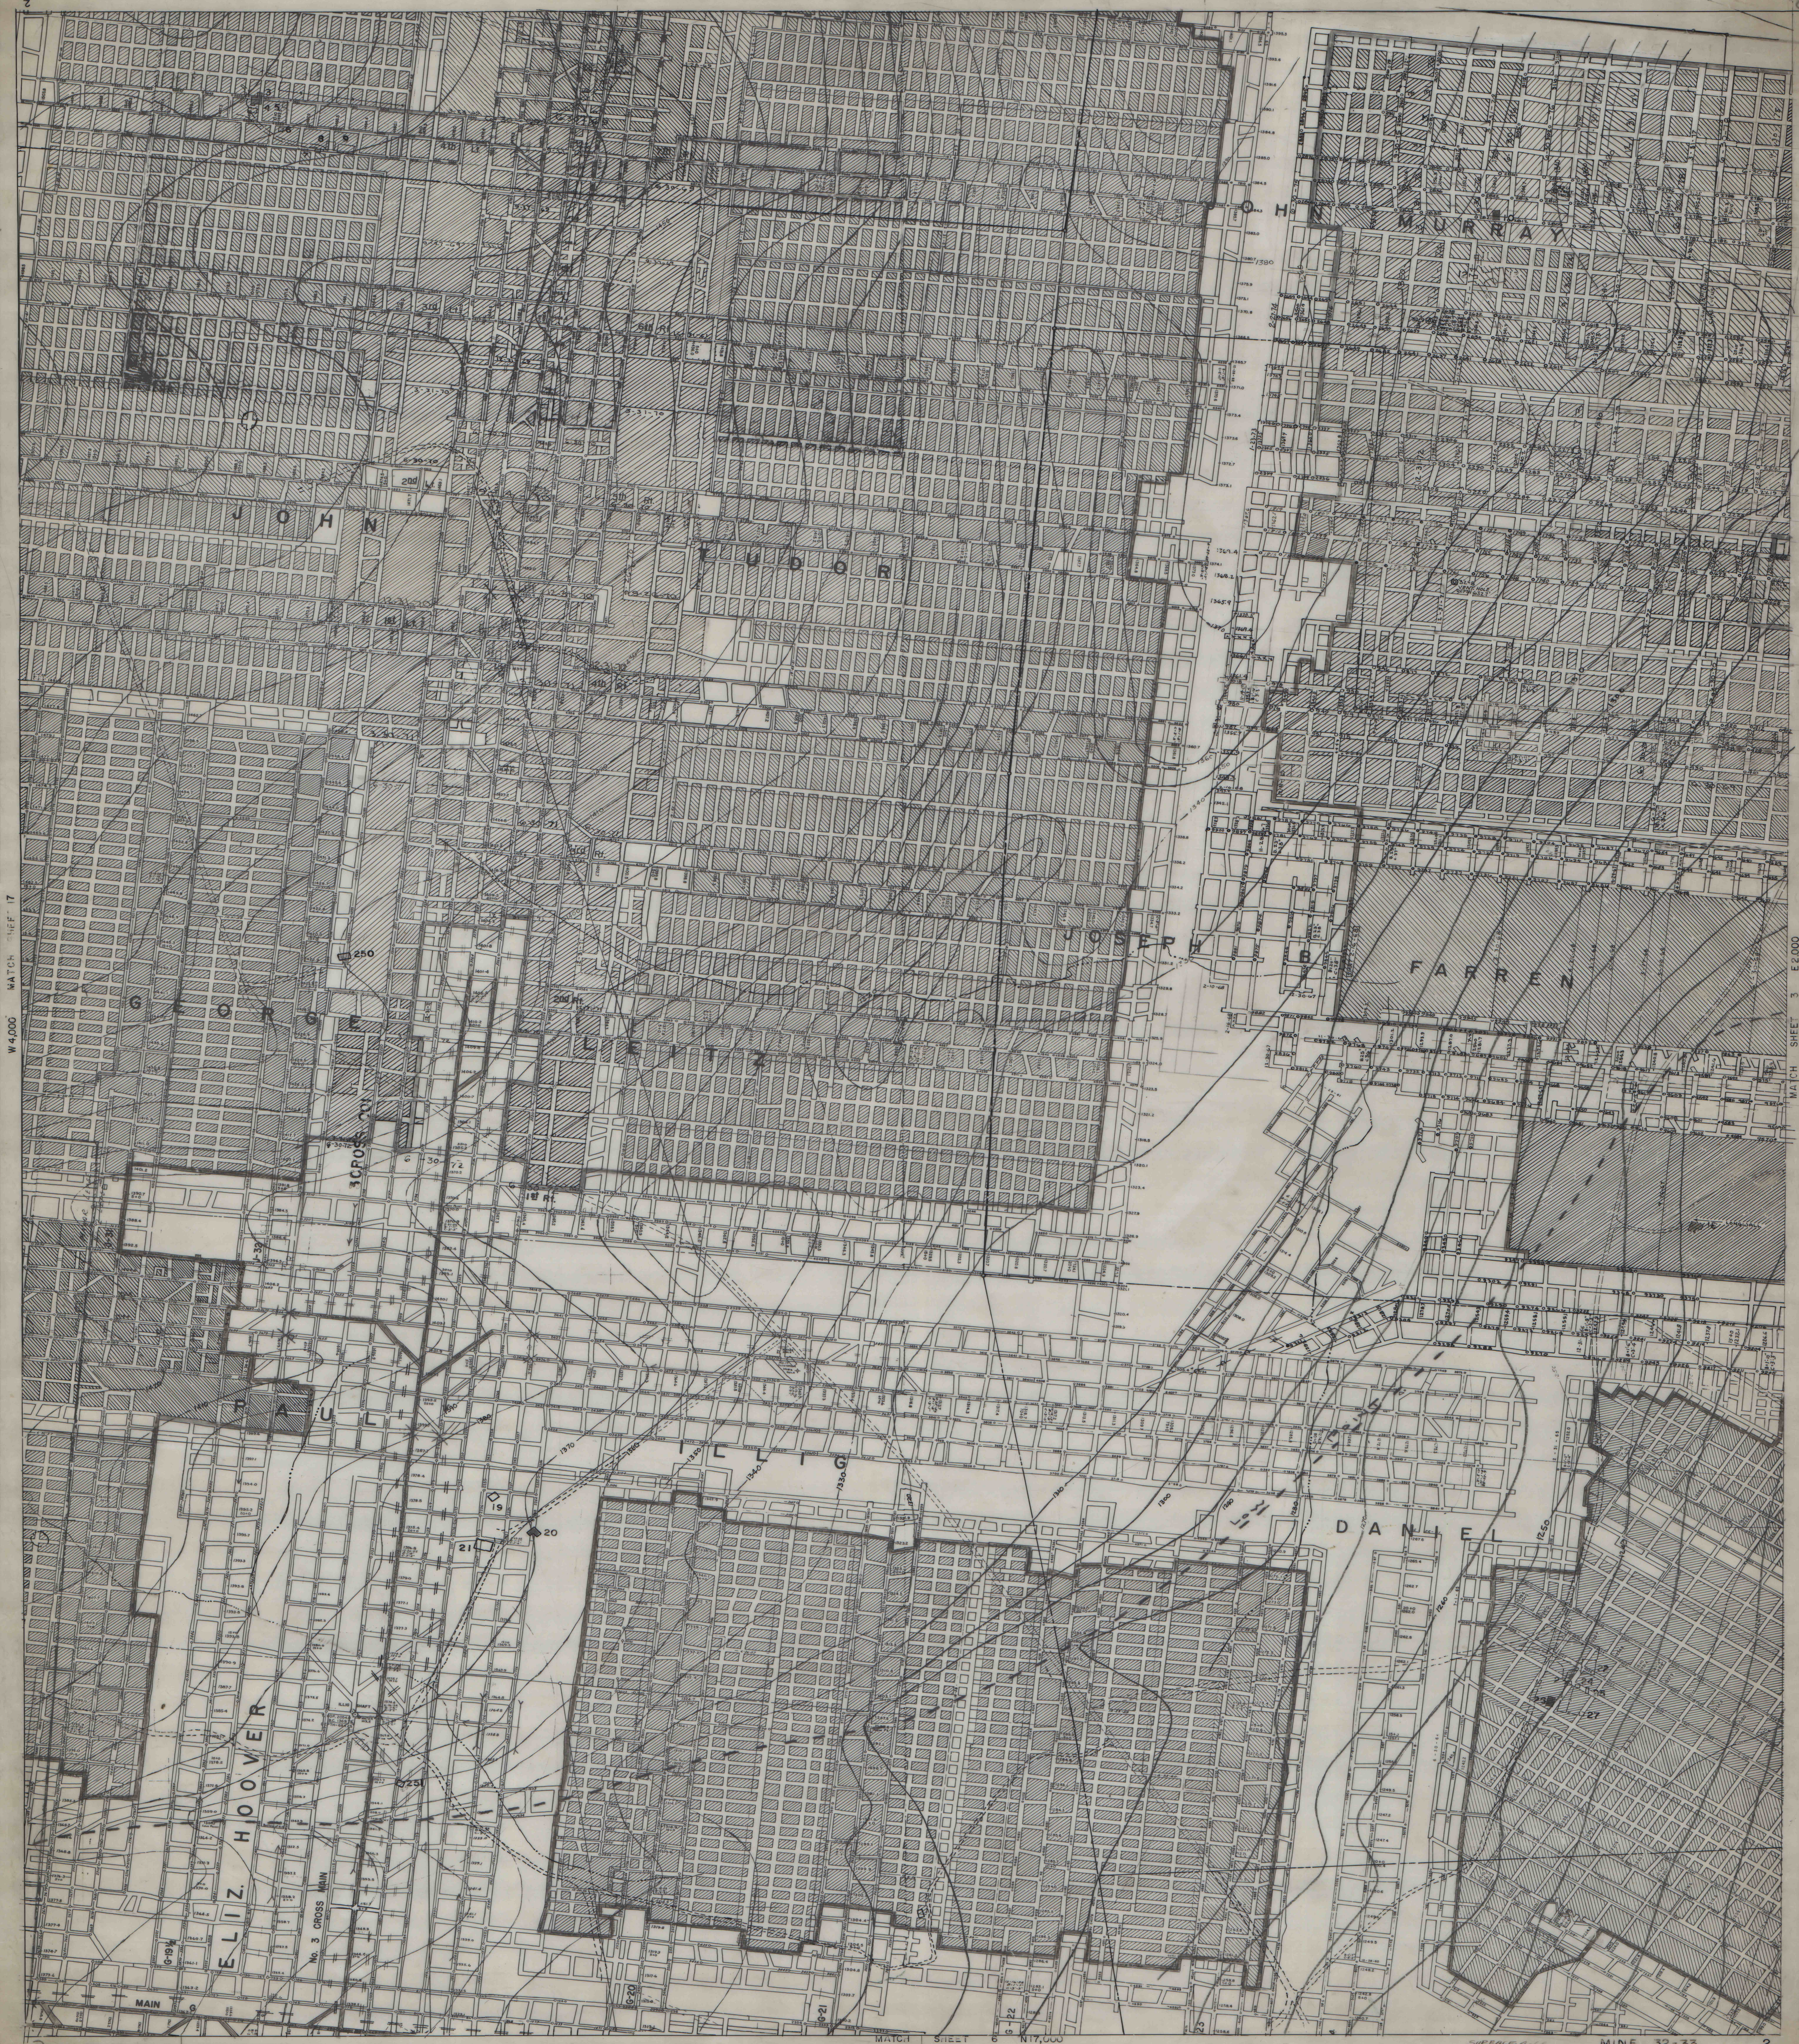

W 4,000 MATCH SHEET 17

MATCH SHEET 3 E 2,000