


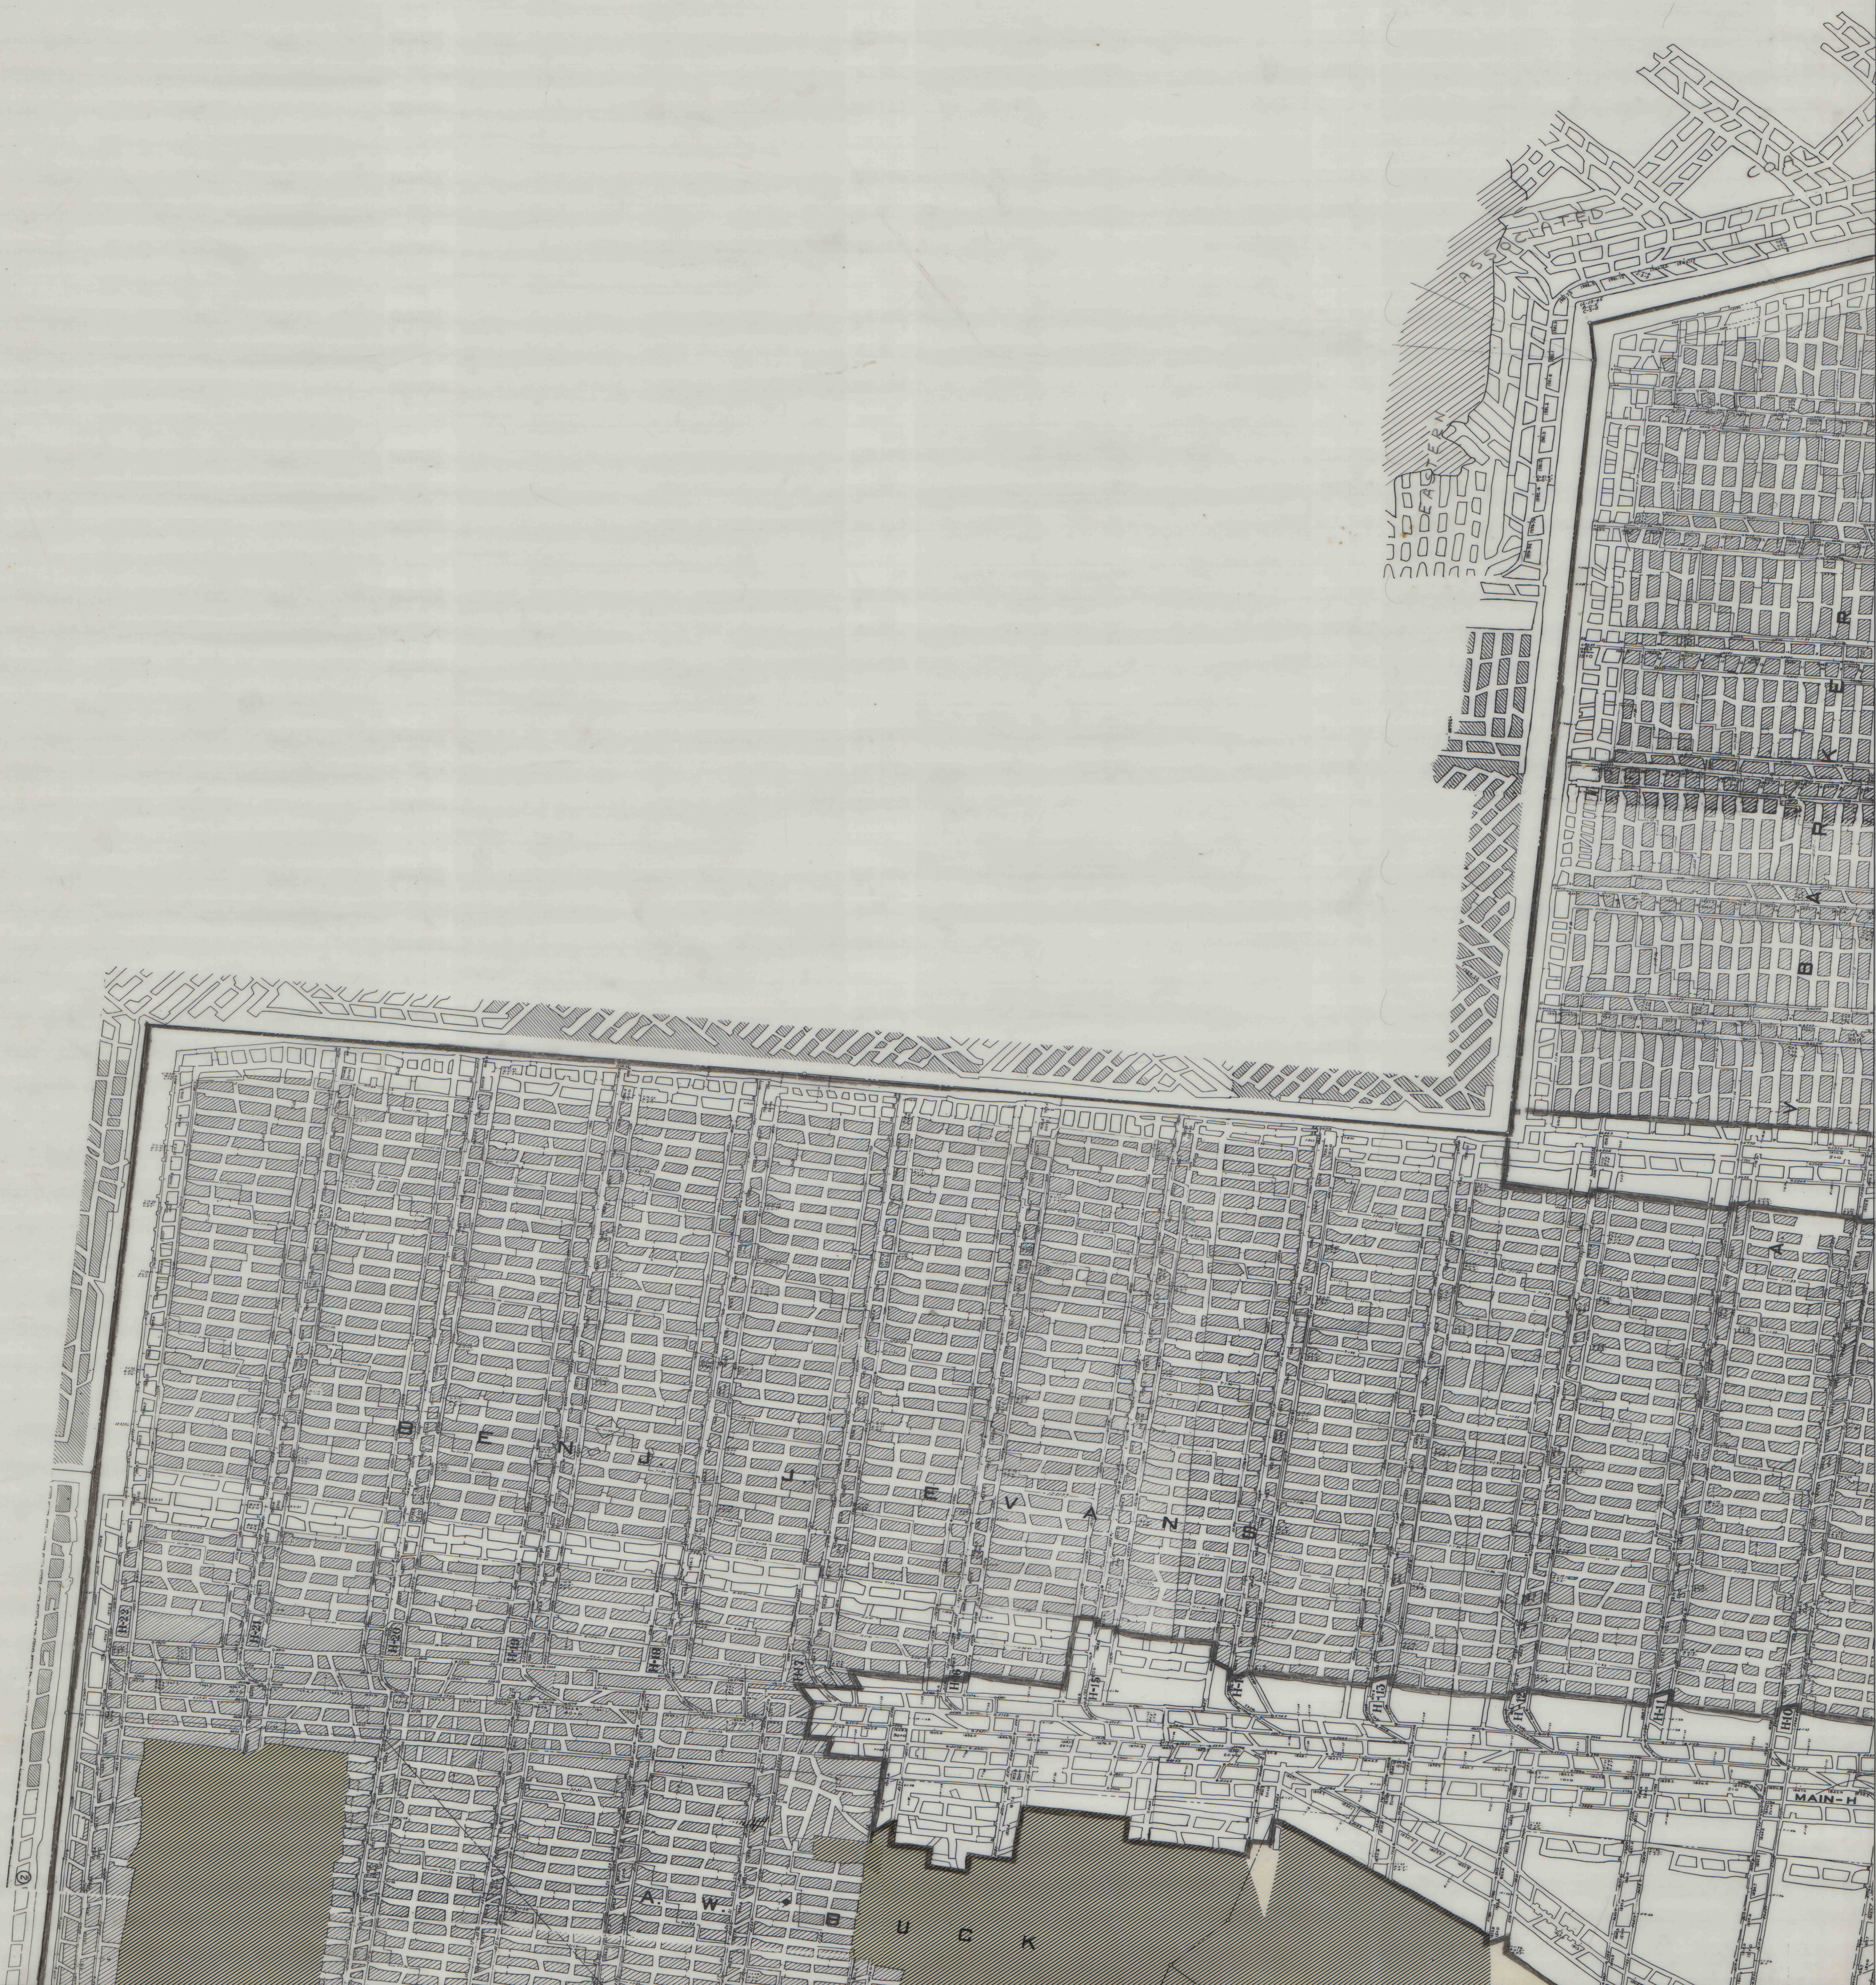

MATCH SHEET 15