


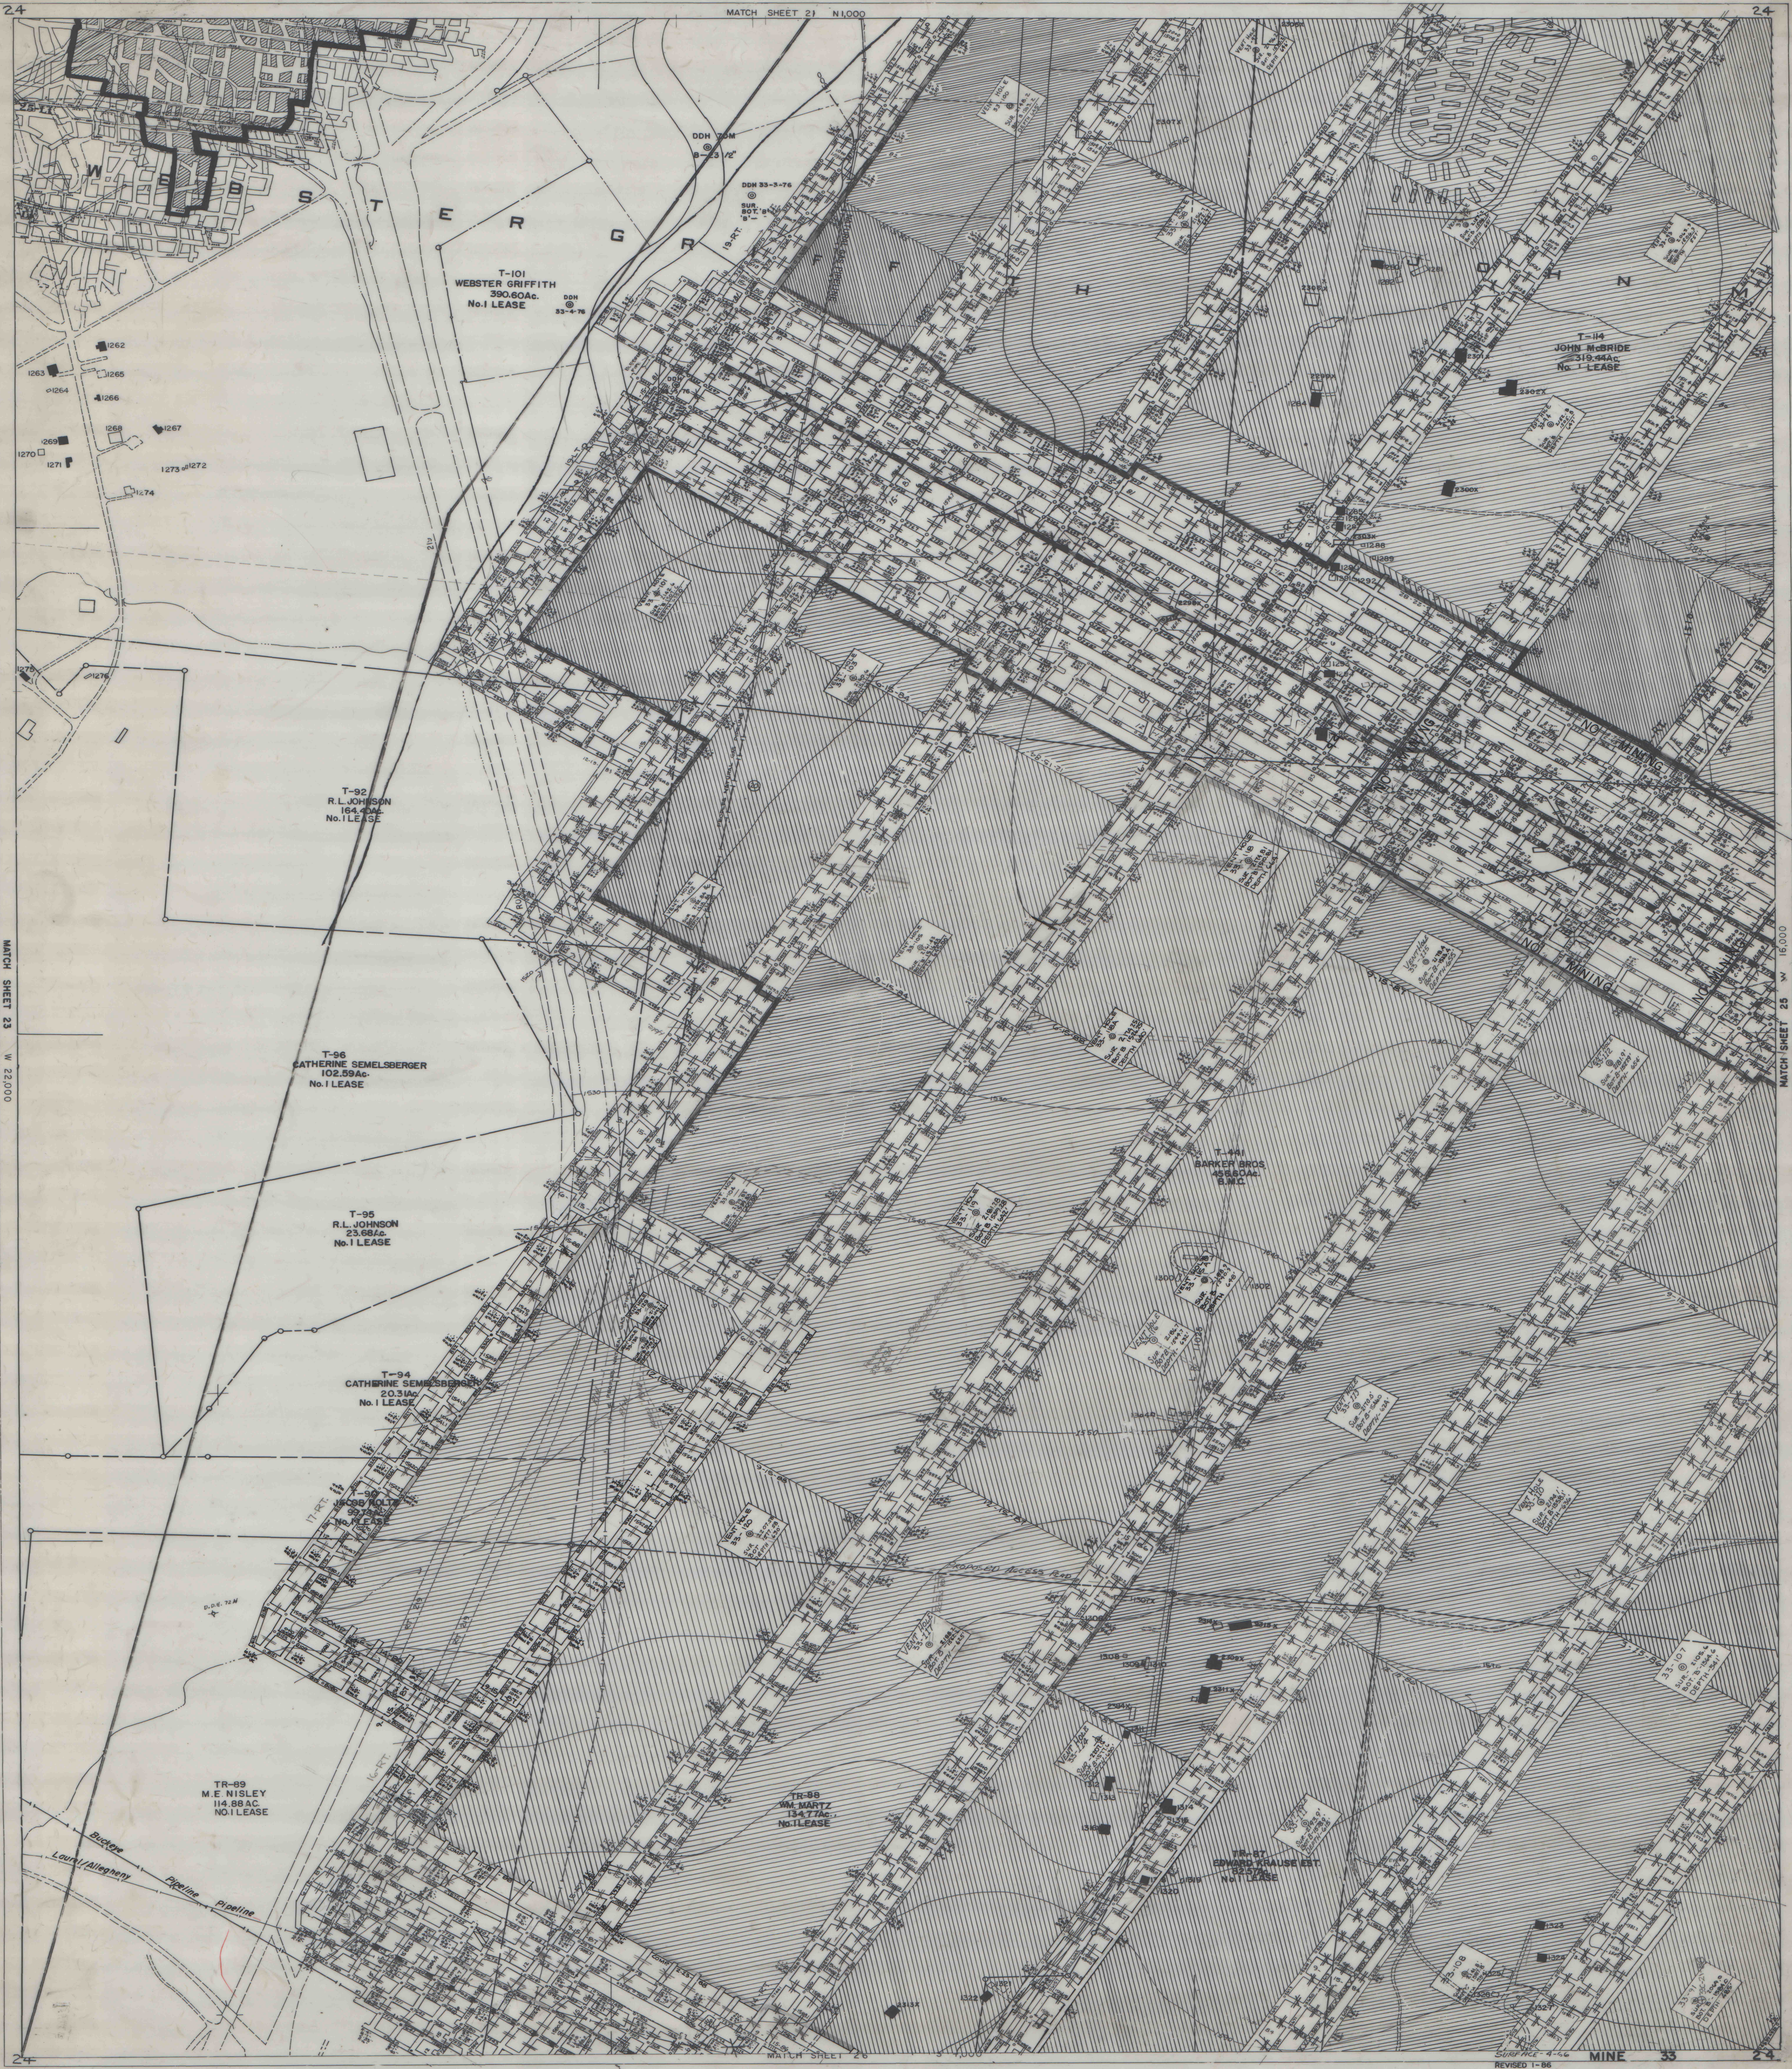

24

24

MATCH SHEET 23 W 22,000

MATCH SHEET 25 W 15,000

24

24

MATCH SHEET 21 N 1,000

MATCH SHEET 26 N 1,000

REVISED 1-86 MINE 33